


Map No. **KANSAS** Sec. 11 Twp. 24 R. 12^E
Well No. 6 Front Farm
Mid-Cook Company

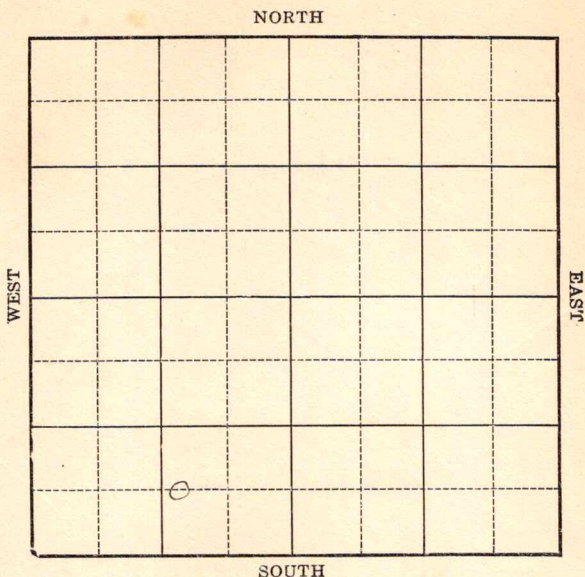

Location _____
Drilling Remarks _____

Rig Up _____
Drilling Remarks _____

RECORD


Cased _____ in. _____ ft.
Sand _____
Gas _____
Oil _____
Total Depth _____

PRODUCTION

1st 24 hrs. Nat. _____
1st 24 hrs. after shot _____
Gas _____ cu. ft.
Dry Hole _____
Abandoned _____

Map No. _____ Sec. 11 Twp. 24 R. 12^EWell No. 6 Hunt Farm
Mid-Continent Petroleum Company

NORTH

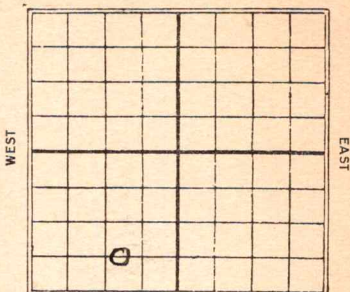

_____ Ft. from N. Line

660 Ft. from S. Line1120 Ft. from E. Line

_____ Ft. from W. Line

SOUTH

Date

REPORT

19308/27 Rgn up9/3 Spdg9/10 drly 1350'9/17 Top Line 1697set 6"First show 1723T.D. 1730'P.B. to 1727 shot 20 grCly out9/24 Top Line 1697Oil 1723-30'T.D. 1730P.B. 1727shot 20 gr20 bbl oil
Pump

16 **KANSAS** Sec. 11 Twp. 24 R. 12 ^E

Well No. 6 Hunt

Mid-Cont Prod Corp Company

Contractor

FIRST REPORTS


_____ Ft. from N. Line

660 Ft. from S. Line

1120 Ft. from E. Line

_____ Ft. from W. Line

SECTION PLAT

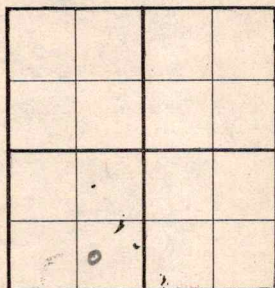

Location _____

Rig up _____

Drilling and Remarks:

Rgn up.

RECORD

Cased _____ in., _____ ft.

Sand _____

Gas _____

Oil _____

Total Depth _____

PRODUCTION

1st 24 hrs. Nat. _____

1st 24 hrs. after shot _____

Gas _____ Cu. Ft.

Dry Hole _____

Abandoned _____

Date

AUG 27 1930

19

CHAS. L. SHERWOOD

Scout

Gmwood

Map No. **KANSAS** Sec. 11 Twp. 24 R. 12Well No. 6 Hunt
Mis-Cont part Co Company

Contractor

COMPLETE**SECTION PLAT**

	0		

_____ Ft. from N. Line

660 Ft. from S. Line1120 Ft. from E. Line

_____ Ft. from W. Line

Location _____

Rig up _____

Drilling and Remarks:

Top line 1697'

PB to 1727'

20/20 bbs.

RECORD

Cased _____ in., _____ ft.

Sand _____

Gas _____

Oil 1773-1730Total Depth 1730**PRODUCTION**

1st 24 hrs. Nat. _____

1st 24 hrs. after shot _____

Gas _____ Cu. Ft.

Dry Hole _____

Abandoned _____

Date

SEP 24 1930

19

CHAS. L. SHERWOOD

Scout