


Map No. *L1002* *K11* Sec. *8* Twp. *28* R. *4*
 Well No. *18 corner* Farm
Empire Company
 NORTH

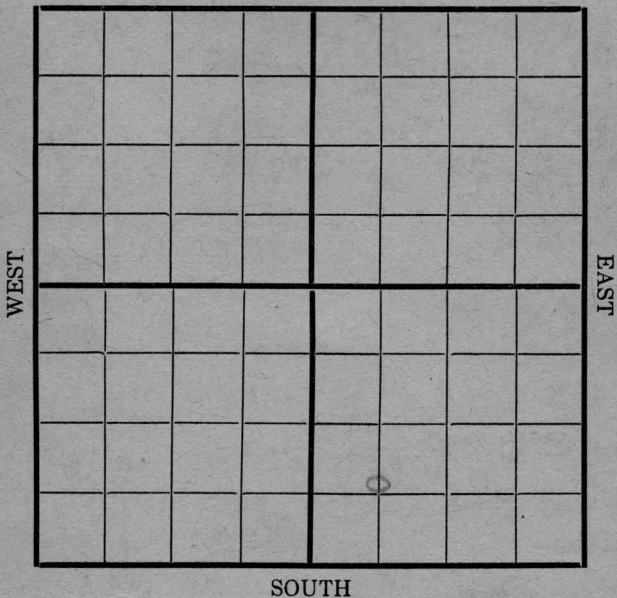

Location _____
 Rig Up _____
 Drilling and remarks

Rigged up

RECORD

Cased _____ in. _____ Ft.
 Sand _____
 Gas _____
 Oil _____
 Total Depth _____

PRODUCTION

1st 24 hrs. Nat. _____
 1st 24 hrs. after shot _____
 Gas _____ Cu. Ft.
 Dry Hole _____
 Abandoned _____

Date


1/15, 191 *7* *Carly* Scout

Map No. _____ Sec. 8 Twp. 28 R. 4
 Well No. 18 Warner Farm _____
Empire Company _____

NORTH

WEST

EAST

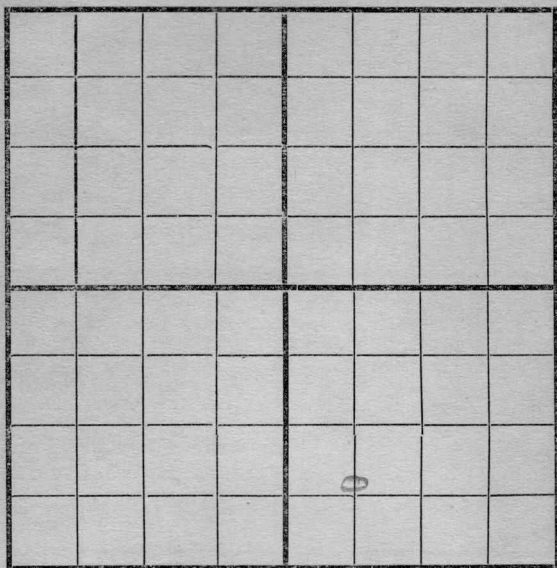

SOUTH

Location _____

Rig Up _____

Drilling and remarks

230

RECORD

Cased _____ in. _____ Ft.

Sand _____

Gas _____

Oil _____

Total Depth _____

PRODUCTION

1st 24 hrs. Nat. _____

1st 24 hrs. after shot _____

Gas _____ Cu. Ft.

Dry Hole _____

Abandoned _____

Date

1/22, 1912 Condy Scout

Map No. _____ Sec. 8 Twp. 28 R. 4Well No. 18 _____ Farm __________
Empire Company

NORTH

WEST

EAST

SOUTH

Location _____

Rig Up _____

Drilling and remarks

620'

RECORD

Cased _____ in. _____ Ft.

Sand _____

Gas _____

Oil _____

Total Depth _____

PRODUCTION

1st 24 hrs. Nat. _____

1st 24 hrs. after shot _____

Gas _____ Cu. Ft.

Dry Hole _____


Abandoned _____

Date

1/29, 1917Condy Scout

Map No. _____ Sec. 8 Twp. 28 R. 4
 Well No. 18 Farm _____
Empire Company _____

NORTH

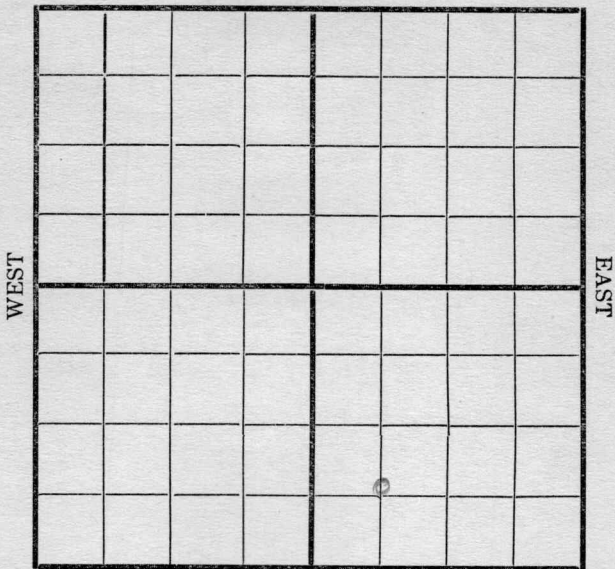

SOUTH

Location _____
 Rig Up _____
 Drilling and remarks

890'

RECORD

Cased _____ in. _____ Ft.
 Sand _____
 Gas _____
 Oil _____
 Total Depth _____

PRODUCTION

1st 24 hrs. Nat. _____
 1st 24 hrs. after shot _____
 Gas _____ Cu. Ft.
 Dry Hole _____
 Abandoned _____


Date 2/5 1917 Conroy Scout

Map No. _____ Sec. 8 Twp. 28 R. 4
 Well No. 18 Varner Farm

NORTH

WEST

EAST

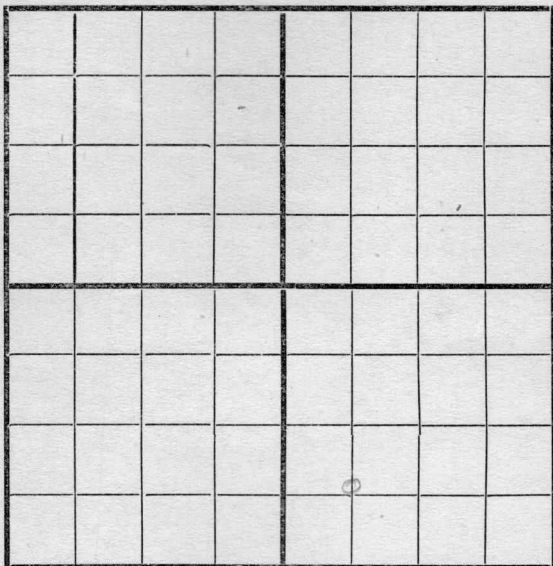

SOUTH

Location _____
 Rig Up _____
 Drilling and remarks

1410

RECORD

Cased _____ in. _____ Ft.
 Sand _____
 Gas _____
 Oil _____
 Total Depth _____

PRODUCTION


1st 24 hrs. Nat. _____
 1st 24 hrs. after shot _____
 Gas _____ Cu. Ft.
 Dry Hole _____
 Abandoned _____

Date 3/12, 1917 C. A. Varner Scout

Map No. _____ Sec. 8 Twp. 28 R. 4
 Well No. 18 Varner Farm _____
Empire Company _____

NORTH

WEST

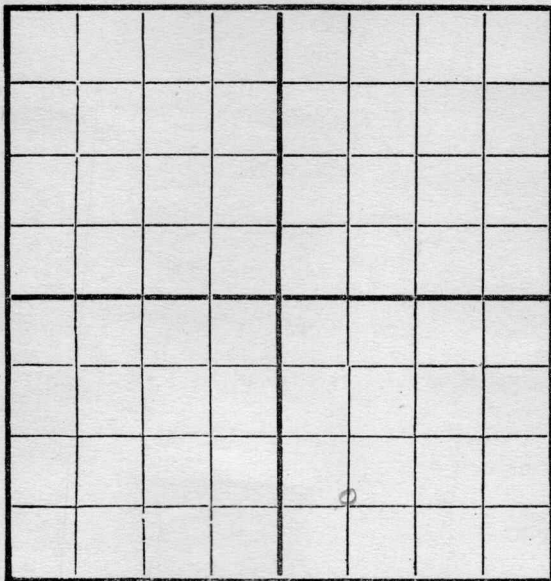

EAST

SOUTH

Location _____
 Rig Up _____
 Drilling and remarks _____

1470

RECORD

Cased _____ in. _____ Ft.
 Sand _____
 Gas _____
 Oil _____
 Total Depth _____

PRODUCTION


1st 24 hrs. Nat. _____
 First 24 hrs. after shot _____
 Gas _____ Cu. Ft.
 Dry Hole _____
 Abandoned _____

Date

3/19, 1917 Carroll Scout

Map No. _____ Sec. 8 Twp. 28 R. 4
 Well No. 18 Harmon Farm
Empire Company

NORTH

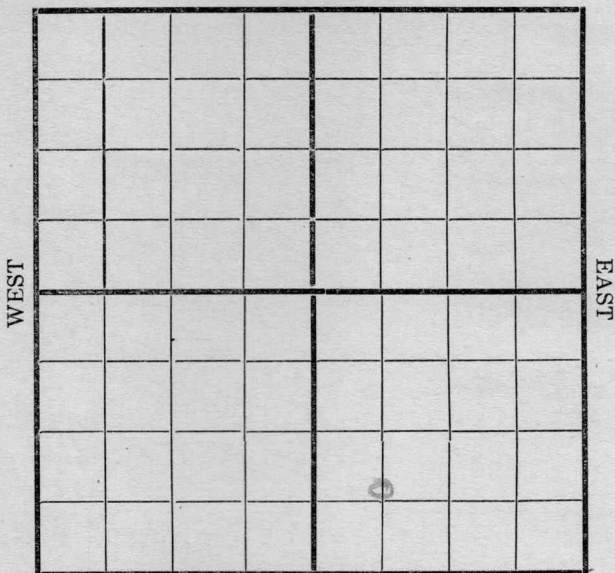

SOUTH

Location _____
 Rig Up _____
 Drilling and remarks

1830

RECORD

Cased _____ in. _____ Ft.
 Sand _____
 Gas _____
 Oil _____
 Total Depth _____

PRODUCTION

1st 24 hrs. Nat. _____
 1st 24 hrs. after shot _____
 Gas _____ Cu. Ft.
 Dry Hole _____
 Abandoned _____

Date


2/20 191 2 Carley Scout

Map No. _____ Sec. 8 Twp. 28 R. 4
 Well No. 18 Turner Farm
Engine Company

NORTH

WEST

EAST

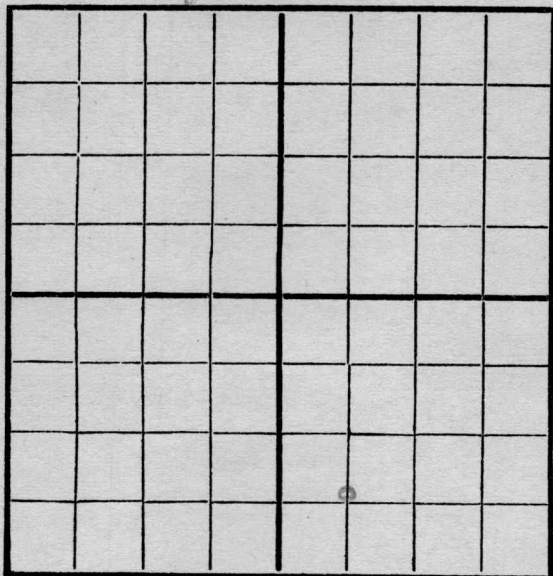

SOUTH

REMARKS:

1970

Date


3/5-7, 1917 Carly Scout

Map No. _____ Sec. 8 Twp. 38 R. 4
 Well No. 18 Farmer Farm _____
Empire Company _____

NORTH

WEST

EAST

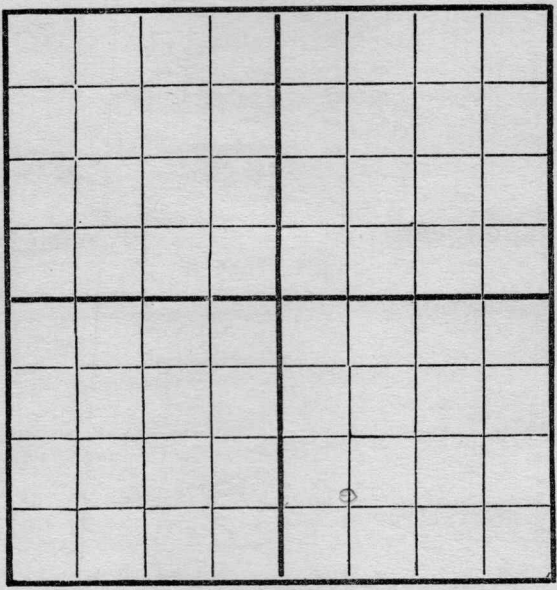

SOUTH

Location _____

Rig Up _____

Drilling and remarks

2015

RECORD

Cased _____ in. _____ Ft.

Sand _____

Gas _____

Oil _____

Total Depth _____

PRODUCTION

1st 24 hrs. Nat. _____

1st 24 hrs. after shot _____

Gas _____ Cu. Ft.

Dry Hole _____

Abandoned _____

Date

3/12

191


7 Candy

Scout

Map No. _____ Sec. 8 Twp. 28 R. 4
 Well No. 18 Hammer Farm _____
Empire Company _____

NORTH

WEST

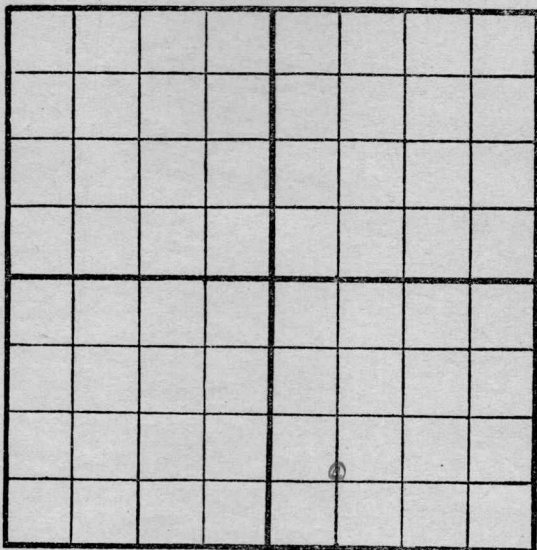

EAST

SOUTH

Location _____

Rig Up _____

Drilling and remarks

Fishing
2015'

RECORD

Cased _____ in. _____ Ft.

Sand _____

Gas _____

Oil _____

Total Depth _____

PRODUCTION

1st 24 hrs. Nat. _____

1st 24 hrs. after shot _____

Gas _____ Cu. Ft.

Dry Hole _____

Abandoned _____


Date

3/19, 191 *7*

Carly Scout

Map No. _____ Sec. 8 Twp. 28 R. 4
Well No. 18 varner Farm
Empires Company

NORTH

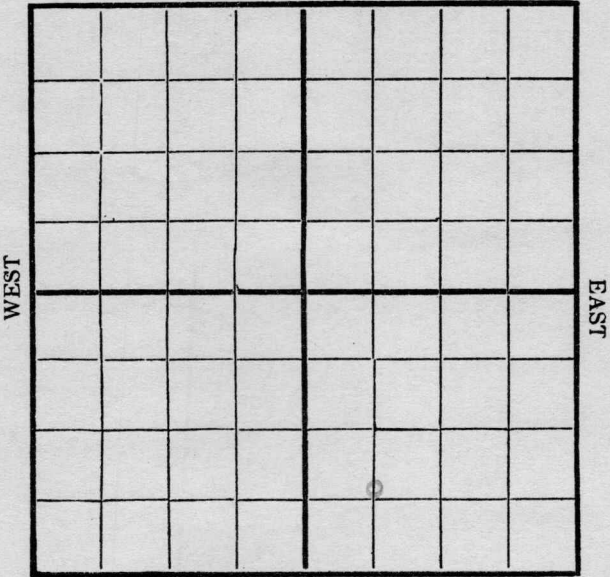

SOUTH

Location _____ Rig Up _____ Drilling and remarks <u>2205</u>	RECORD
	Cased _____ in. _____ Ft.
	Sand _____
	Gas _____
	Oil _____
Total Depth _____	
	PRODUCTION
	1st 24 hrs. Nat. _____
	1st 24 hrs. after shot _____
	Gas _____ Cu. Ft.
	Dry Hole _____
	Abandoned _____

Date 3/26, 1917 C. C. C. C. Scout

Map No. _____ Sec. 8 Twp. 28 R. 4
 Well No. 18 Varner Farm _____
Engine Company _____

NORTH

WEST

EAST

SOUTH

Location _____
 Rig Up _____
 Drilling and remarks

2275

RECORD

Cased _____ in. _____ Ft.
 Sand _____
 Gas _____
 Oil _____
 Total Depth _____

PRODUCTION


1st 24 hrs. Nat. _____
 First 24 hrs. after shot _____
 Gas _____ Cu. Ft.
 Dry Hole _____
 Abandoned _____

Date

4/4, 1917 Cord Scout

Map No. _____ Sec. 8 Twp. 28 R. 4
Well No. 18 Farmer Farm _____
Empire Company _____

NORTH

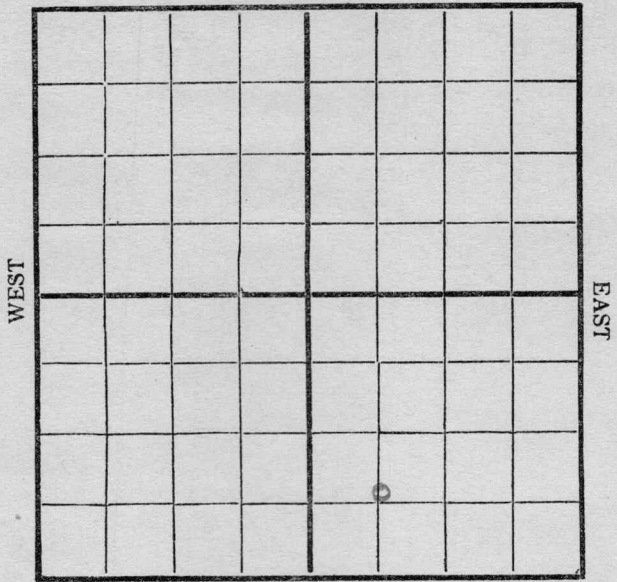

SOUTH

Location _____ Rig Up _____ Drilling and remarks _____ <u>2406'</u>	RECORD
	Cased _____ in. _____ Ft.
	Sand _____
	Gas _____
	Oil _____
Total Depth _____	
	PRODUCTION
	1st 24 hrs. Nat. _____
	1st 24 hrs. after shot _____
	Gas _____ Cu. Ft.
	Dry Hole _____
	Abandoned _____


Date 4/10, 1917 Carby Scout

Map No. _____ Sec. 8 Twp. 28 R. 4
 Well No. 18 Varner Farm _____

NORTH

WEST

EAST

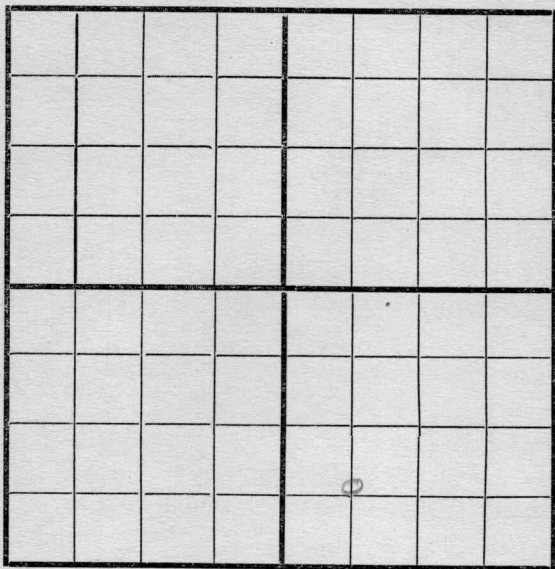

SOUTH

Location _____

Rig Up _____

Drilling and remarks

Thompson
2396'

RECORD

Cased _____ in. _____ Ft.

Sand _____

Gas _____

Oil _____

Total Depth _____

PRODUCTION

1st 24 hrs. Nat. _____

1st 24 hrs. after shot _____

Gas _____ Cu. Ft.

Dry Hole _____


Abandoned _____

Date

4/17, 1917 Carly Scout

Map No. K11 Sec. 8 Twp. 28 R. 4
 Well No. 18 Varner Farm
Empire Company

NORTH

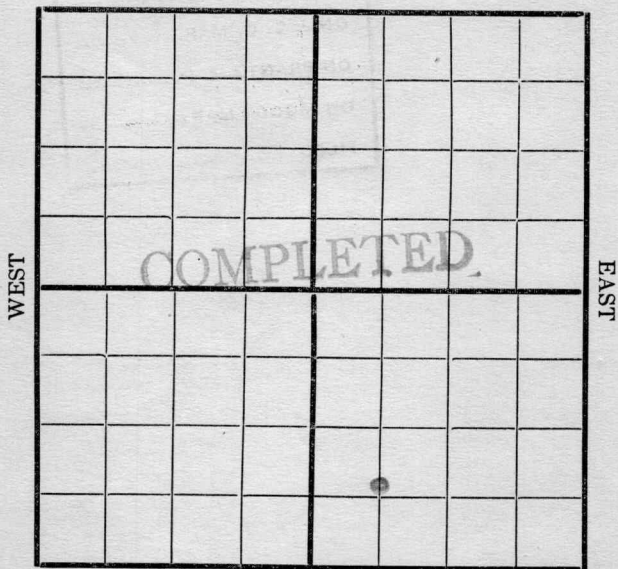

SOUTH

Location _____
 Rig Up _____
 Drilling and remarks _____

*Estimated
 at 60 Bbl*

RECORD

Cased _____ in. _____ Ft.
 Sand 2396-2448
 Gas _____
 Oil _____
 Total Depth _____

PRODUCTION

1st 24 hrs. Nat. _____
 1st 24 hrs. after shot _____
 Gas _____ Cu. Ft.
 Dry Hole _____
 Abandoned _____

Date

4/24 191 7 Conley Scout