


Map No. _____ Sec. 8 Twp. 28 R. K
Well No. 20 Varner Farm
_____Empire_____
Company

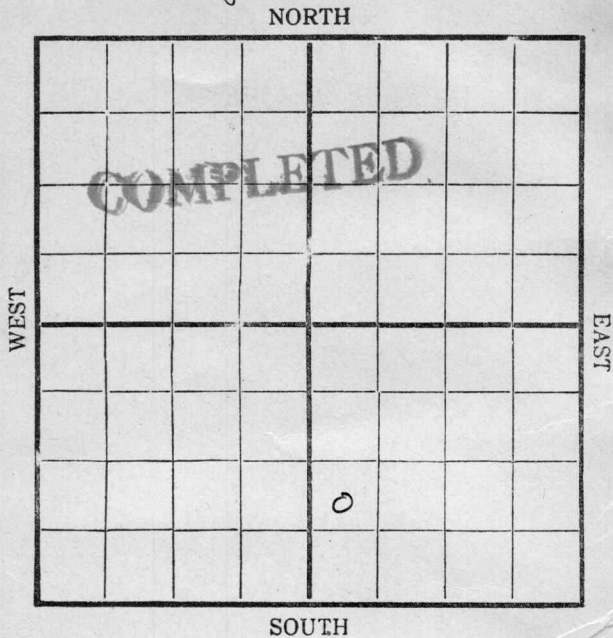

Location _____

Drilling Remarks:

RECORD

Cased _____ in _____ Ft.
Sand _____
Gas _____
Oil _____
Total Depth _____

Rig Up _____

Drilling Remarks:

PRODUCTION


1st 24 hrs. Nat. _____
1st 24 hrs. after shot _____
Gas _____ Cu. Ft.
Dry Hole _____
Abandoned _____

Map No. _____ Sec. 8 Twp. 28 R. 4
 Well No. 20.E.C. Varner Farm
Empire Company

NORTH

WEST

EAST

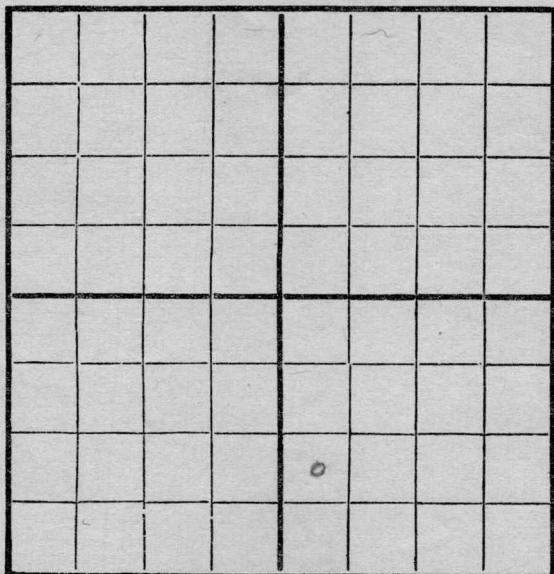

SOUTH

REMARKS:

901 ft N. of S. Line
 795 ft E. of W. Line


FIRST REPORT

3/12¹⁹¹⁷ L. A. Co. Liff

Map No. _____ Sec. 8 Twp. 28 R. 4Well No. 20 Harmon Farm
Empire Company

NORTH

WEST

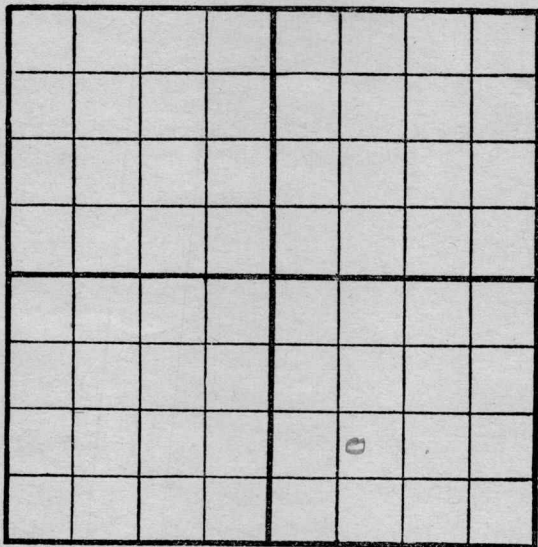

EAST

SOUTH

Location _____

Rig Up _____

Drilling and remarks _____

RECORD

Cased _____ in. _____ Ft.

Sand _____

Gas _____

Oil _____

Total Depth _____

PRODUCTION

1st 24 hrs. Nat. _____

1st 24 hrs. after shot _____

Gas _____ Cu. Ft.

Dry Hole _____

Abandoned _____

Date


3/30, 1912 Carroll Scout

Map No. _____ Sec. 8 Twp. 28 R. 4
 Well No. 20 EC Farmer Farm
Engine Company

NORTH

WEST

EAST

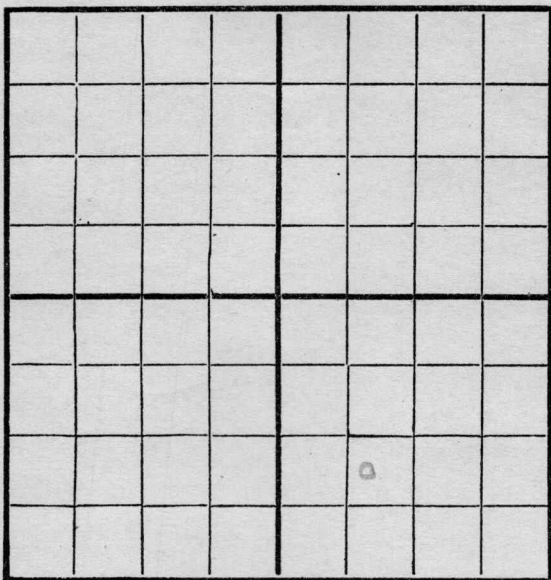

SOUTH

Location _____
 Rig Up ☒ _____
 Drilling and remarks _____

RECORD

Cased _____ in. _____ Ft.
 Sand _____
 Gas _____
 Oil _____
 Total Depth _____

PRODUCTION

1st 24 hrs. Nat. _____
 1st 24 hrs. after shot _____
 Gas _____ Cu. Ft.
 Dry Hole _____
 Abandoned _____


Date 3/26, 191 7 Carley Scout

Map No. _____ Sec. 8 Twp. 28 R. 4
 Well No. 20 Farmer Farm
Engine Company

NORTH

WEST

EAST

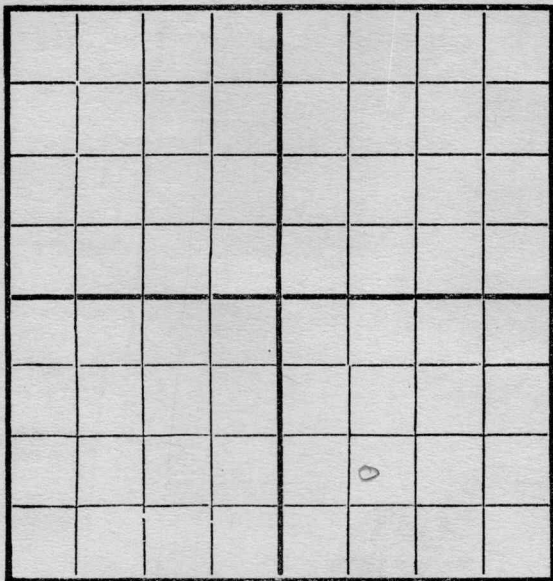

SOUTH

Location _____
 Rig Up _____
 Drilling and remarks

Rigging up

RECORD

Cased _____ in. _____ Ft.
 Sand _____
 Gas _____
 Oil _____
 Total Depth _____

PRODUCTION


1st 24 hrs. Nat. _____
 First 24 hrs. after shot _____
 Gas _____ Cu. Ft.
 Dry Hole _____
 Abandoned _____

Date

4/4, 191 7 *Cooley* Scout

Map No. _____ Sec. 8 Twp. 38 R. 4
 Well No. 20 Verrier Farm _____
Empire Company _____

NORTH

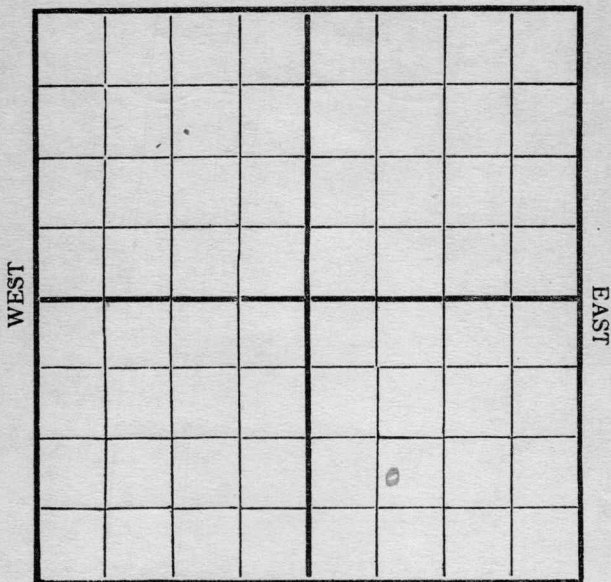

SOUTH

Location _____
 Rig Up _____
 Drilling and remarks _____

RECORD

Cased _____ in. _____ Ft.
 Sand _____
 Gas _____
 Oil _____
 Total Depth _____

PRODUCTION

1st 24 hrs. Nat. _____
 1st 24 hrs. after shot _____
 Gas _____ Cu. Ft.
 Dry Hole _____
 Abandoned _____

Date

4/10, 1917 Cardiff Scout


Map No. _____ Sec. 8 Twp. 28 R. 4Well No. 20 _____ Farm _____

_____ Company _____

NORTH

WEST

EAST

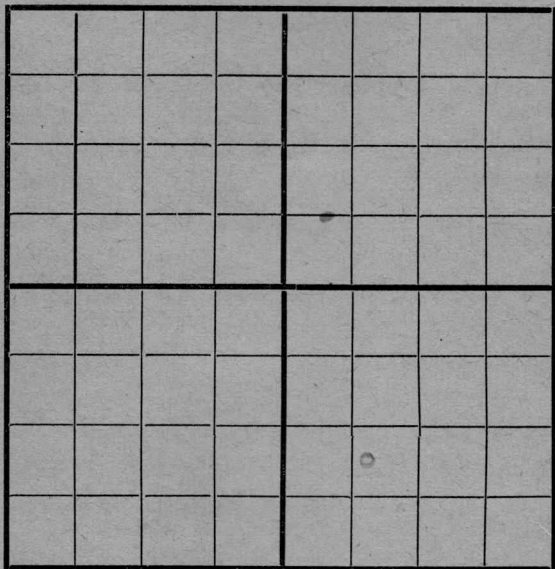

SOUTH

Location _____

Rig Up _____

Drilling and remarks

400

RECORD

Cased _____ in. _____ Ft.

Sand _____

Gas _____

Oil _____

Total Depth _____

PRODUCTION

1st 24 hrs. Nat. _____

1st 24 hrs. after shot _____

Gas _____ Cu. Ft.

Dry Hole _____

Abandoned _____

Date

4/17, 191 7 Conley Scout

Map No. _____ Sec. 8 Twp. 28 R. 4Well No. 20 Farm _____Engine Company _____

NORTH

WEST

EAST

SOUTH

Location _____

Rig Up _____

Drilling and remarks

1085'

RECORD

Cased _____ in. _____ Ft.

Sand _____

Gas _____

Oil _____

Total Depth _____

PRODUCTION

1st 24 hrs. Nat. _____

1st 24 hrs. after shot _____

Gas _____ Cu. Ft.

Dry Hole _____


Abandoned _____

Date

4/24 191 7 Car. P. J. Scout

Map No. _____ Sec. 8 Twp. 38 R. 4
 Well No. 30 Farm _____
Engine Company _____

NORTH

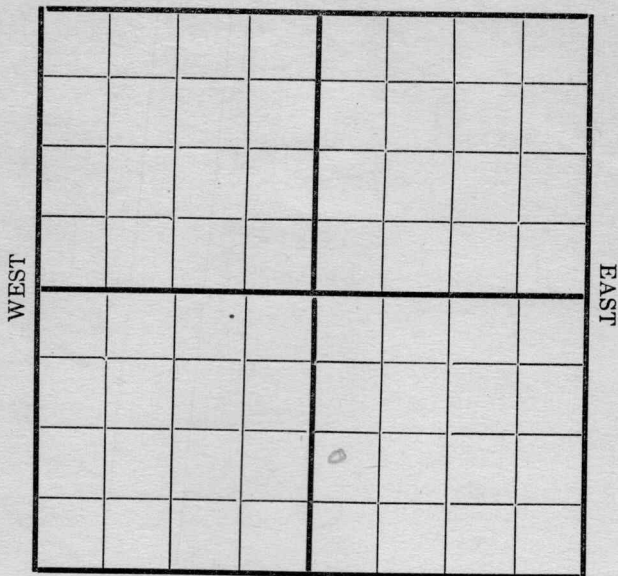

SOUTH

Location _____
 Rig Up _____
 Drilling and remarks _____

1370

RECORD


Cased _____ in. _____ Ft.
 Sand _____
 Gas _____
 Oil _____
 Total Depth _____

PRODUCTION

1st 24 hrs. Nat. _____
 1st 24 hrs. after shot _____
 Gas _____ Cu. Ft.
 Dry Hole _____
 Abandoned _____

Date 5/2, 1912 Early Scout

Map No. _____ Sec. 8 Twp. 28 R. 4
 Well No. 20 _____ Farm
Consigne _____ Company
 NORTH

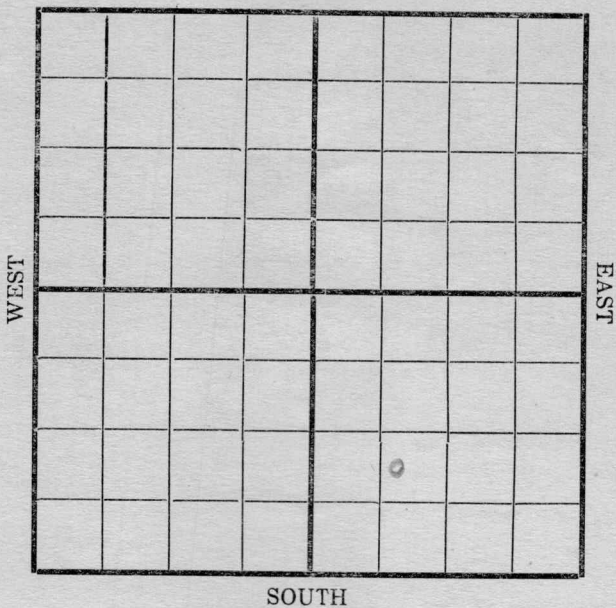

SOUTH

Location _____ Rig Up _____ Drilling and remarks <u>1390</u>	RECORD Cased _____ in. _____ Ft. Sand _____ Gas _____ Oil _____ Total Depth _____ PRODUCTION 1st 24 hrs. Nat. _____ 1st 24 hrs. after shot _____ Gas _____ Cu. Ft. Dry Hole _____ Abandoned _____
---	--


Date 5/8, 1917 Consigne Scout

Map No. _____ Sec. 8 Twp. 28 R. 4
 Well No. 20 Farm _____
Engine Company _____

NORTH

WEST

EAST

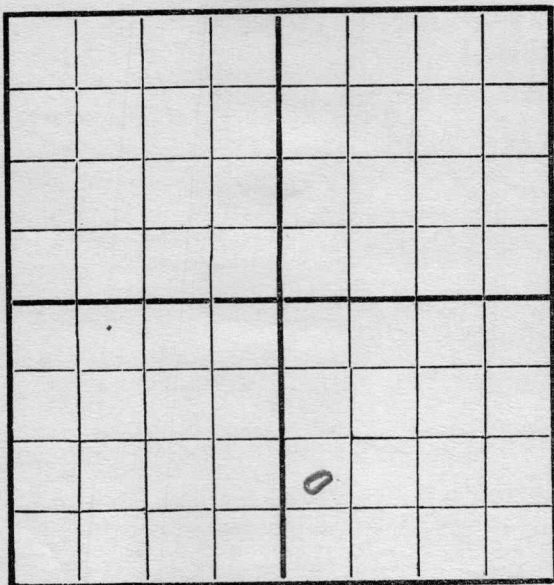

SOUTH

Location _____

Rig Up _____

Drilling and remarks

1870

RECORD

Cased _____ in. _____ Ft.

Sand _____

Gas _____

Oil _____

Total Depth _____

PRODUCTION

1st 24 hrs. Nat. _____

1st 24 hrs. after shot _____

Gas _____ Cu. Ft.

Dry Hole _____


Abandoned _____

Date

5/35 191 7 Conley Scout

Map No. _____ Sec. 8 Twp. 28 R. 4
 Well No. 90 Farmer Farm
Engine Company

NORTH

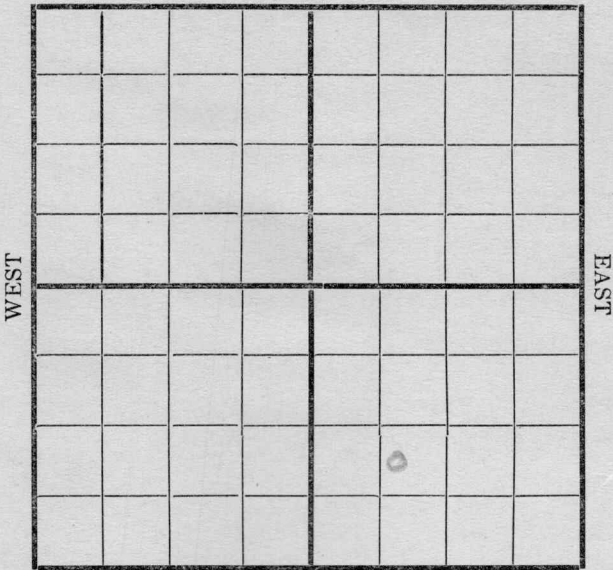

SOUTH

Location _____
 Rig Up _____
 Drilling and remarks _____

1990

RECORD

Cased _____ in. _____ Ft.
 Sand _____
 Gas _____
 Oil _____
 Total Depth _____

PRODUCTION

1st 24 hrs. Nat. _____
 1st 24 hrs. after shot _____
 Gas _____ Cu. Ft.
 Dry Hole _____
 Abandoned _____

Date 5/3/97 191 7 Conley Scout

Map No. K11 4007 Sec. 8 Twp. 28 R. 4
 Well No. 20 Varner Farm
Empire Company

NORTH

WEST

EAST

SOUTH

Location _____
 Rig Up _____
 Drilling and remarks

2385

RECORD

Cased _____ in. _____ Ft.
 Sand _____
 Gas _____
 Oil _____
 Total Depth _____


PRODUCTION

1st 24 hrs. Nat. _____
 1st 24 hrs. after shot _____
 Gas _____ Cu. Ft.
 Dry Hole _____
 Abandoned _____

Date

6/8, 191 7 Candiff Scout

Map No. _____ Sec. 8 Twp. 28 R. 4
 Well No. 20 Turner Farm
Engine Company
 NORTH

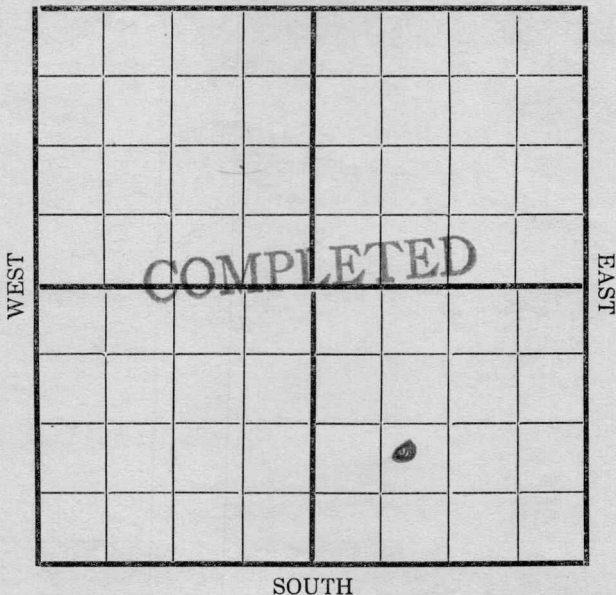

SOUTH

Location _____

Rig Up _____

Drilling and remarks

Est at
225
Bbls

RECORD

Cased _____ in. _____ Ft.
 Sand 2407-2458
 Gas _____
 Oil _____
 Total Depth _____

PRODUCTION

1st 24 hrs. Nat. _____
 1st 24 hrs. after shot _____
 Gas _____ Cu. Ft.
 Dry Hole _____
 Abandoned _____

Date

6/2 191 7 Carly Scout