


KANSAS

Greenwood

Section 11 Township 24 Range 12-E


Well No. #6 Mennonite

Company Aikman & Braden

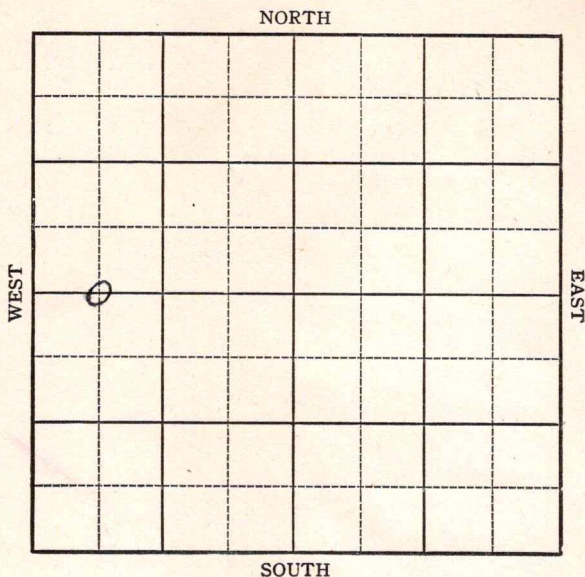

Sec. 11 Twp. 24 R. 12-EWell No. # 6 Menonite FarmAikman & Braden Company

NORTH

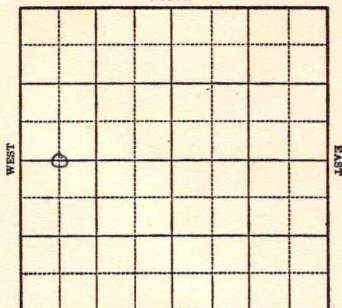

SOUTH

2640 Ft. from N. Line

_____ Ft. from S. Line

_____ Ft. from E. Line

660 Ft. from W. Line

1943

R E P O R T

12-22 Location

12/29 Machine

1944

1-5

"

1/12 10" @ 719'

TD 820

SD

"

1/19

1/26 7" @ 1732

Miss 1732

TD 1751

Pump 35 Pot.


Gravity 36

COMPLETED

KANSAS

Map No. 16 Sec. 11 Twp. 24 R. 12EWell No. 6 MenoniteAikman & Braden CompanyFIRST REPORT ContractorC $W\frac{1}{2}$ $W\frac{1}{2}$

SECTION PLAT

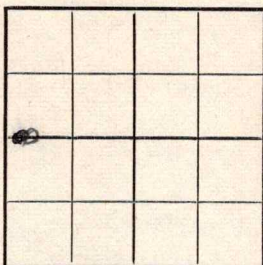2640 Ft. from N. Line Ft. from S. Line Ft. from E. Line660 Ft. from W. LineMiscellaneousLocation XRig up

Drilling and Remarks:

*close to dry
hole*

RECORD

Cased in., ft.Sand Gas Oil Total Depth

PRODUCTION


1st 24 hrs. Nat. 1st 24 hrs. after shot Gas Cu. Ft.Dry Hole Abandoned

Date

DEC 22 194319S. J. LEWIS Scout

KANSASMap No. 16 Sec. 11 Twp. 24 R. 12EWell No. 6 MenoniteAikman & Braden CompanyCOMPLETED ContractorC $W\frac{1}{2}$ $W\frac{1}{2}$

SECTION PLAT

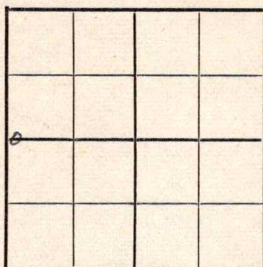2640 Ft. from N. Line Ft. from S. Line Ft. from E. Line660 Ft. from W. LineMiscellaneousLocation Rig up

Drilling and Remarks:

*Miss 1732.**7" @ 1732.**Pump 850 ft**260 ft*RECORDCased in., ft.Sand Gas Oil Total Depth 1751PRODUCTION1st 24 hrs. Nat. 1st 24 hrs. after shot Gas Cu. Ft.Dry Hole Abandoned

Date

JAN 26 1944 19S. J. LEWIS Scout