

Map No. 3^{on 24} Sec 10 Twp 27 R 4Well No. 3- Robertson FarmMc Mass Company

NORTH

WEST

EAST

SOUTH

Location -----

Rig Up 1-22-17

Drilling Remarks:

Drilling Remarks:

RECORD

PRODUCTION

Cased ----- in ----- Ft.

1st 24 hrs. Nat -----

Sand -----

1st 24 hrs. after shot -----

Gas -----

Gas ----- Cu. Ft.

Oil -----


Dry Hole -----

Total Depth -----

Abandoned -----

Map No. 11 Sec. 10 Twp. 37 R. 4
 Well No. 3 Robertson Farm
McNair Company

NORTH

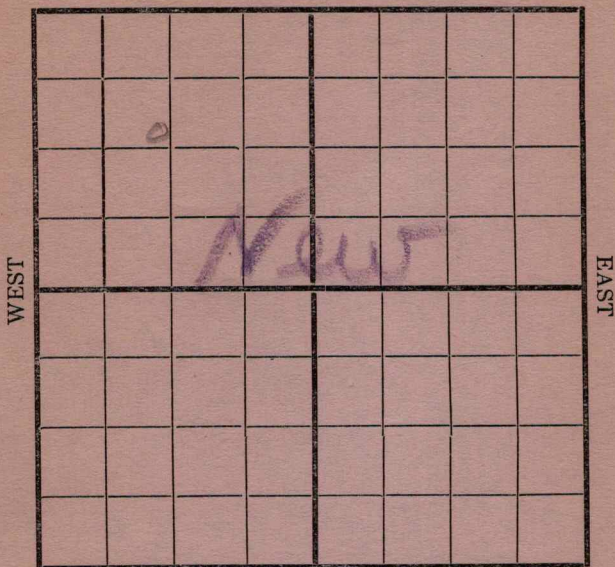

SOUTH

Location ✓Rig Up ✓

Drilling and remarks

RECORD

Cased _____ in. _____ Ft.

Sand _____

Gas _____

Oil _____

Total Depth _____

PRODUCTION

1st 24 hrs. Nat. _____

1st 24 hrs. after shot _____

Gas _____ Cu. Ft.

Dry Hole _____


Abandoned _____

Date

1/22, 1917 Cordell Scout

Map No. _____ Sec. 10 Twp. 27 R. 4
 Well No. 2 Robertson Farm
Mc Union Company

NORTH

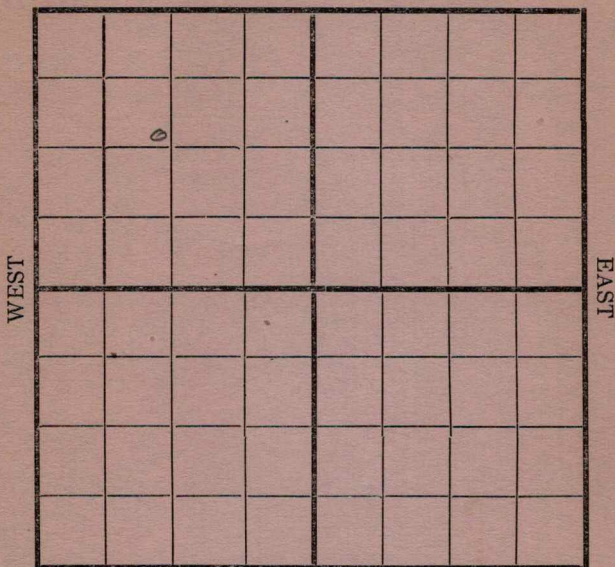

SOUTH

Location _____

Rig Up ☒ _____

Drilling and remarks _____

RECORD

Cased _____ in. _____ Ft.

Sand _____

Gas _____

Oil _____

Total Depth _____

PRODUCTION

1st 24 hrs. Nat. _____

1st 24 hrs. after shot _____

Gas _____ Cu. Ft.

Dry Hole _____


Abandoned _____

Date

1/29, 1917 Condit Scout

Map No. _____ Sec. 10 Twp. 27 R. 4
 Well No. 2 Robertson Farm _____
Ma-More Company _____

NORTH

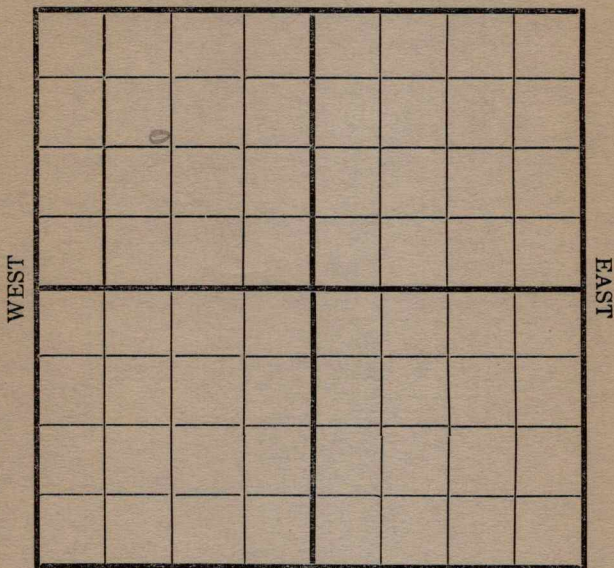

SOUTH

Location _____
 Rig Up ☒ _____
 Drilling and remarks _____

RECORD

Cased _____ in. _____ Ft.
 Sand _____
 Gas _____
 Oil _____
 Total Depth _____

PRODUCTION


1st 24 hrs. Nat. _____
 1st 24 hrs. after shot _____
 Gas _____ Cu. Ft.
 Dry Hole _____
 Abandoned _____

Date

2/5, 191 7 Condy Scout

Map No. _____ Sec. 10 Twp. 22 R. 4
Well No. 2 Robertson Farm
Mormon Company

NORTH

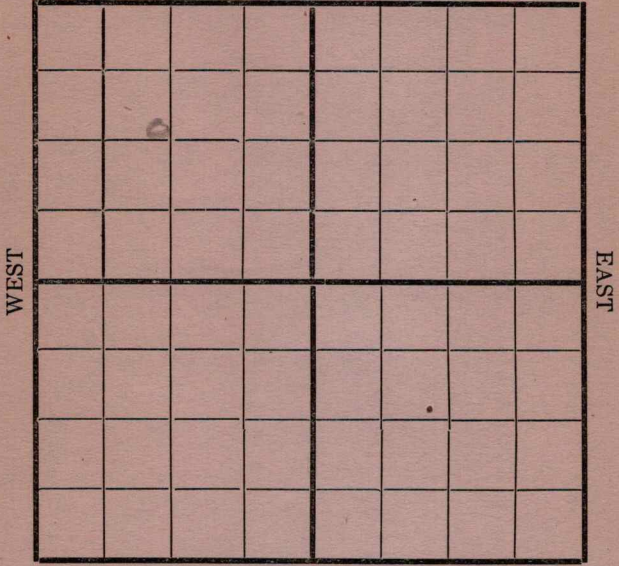

SOUTH

Location _____
Rig Up _____
Drilling and remarks _____

150'

RECORD

Cased _____ in. _____ Ft.
Sand _____
Gas _____
Oil _____
Total Depth _____

PRODUCTION


1st 24 hrs. Nat. _____
1st 24 hrs. after shot _____
Gas _____ Cu. Ft.
Dry Hole _____
Abandoned _____

Date 2/12 1912 Cordell Scout

Map No. _____ Sec. 10 Twp. 27 R. 4
 Well No. 2 Robertson Farm _____
McMurry Company _____

NORTH

WEST

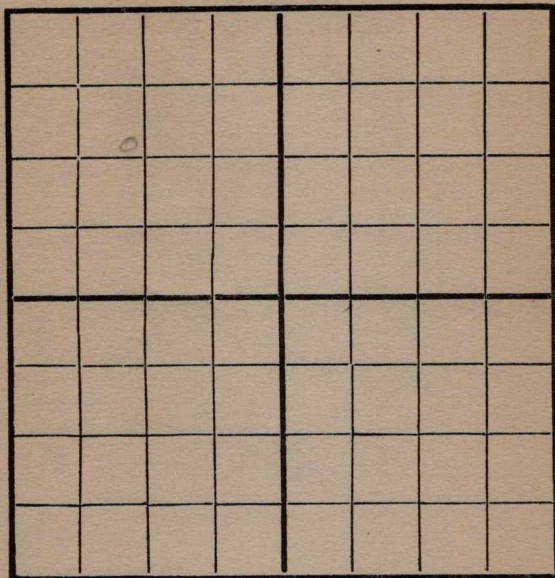

EAST

SOUTH

Location _____

Rig Up _____

Drilling and remarks

625

RECORD

Cased _____ in. _____ Ft

Sand _____

Gas _____

Oil _____

Total Depth _____

PRODUCTION

1st 24 hrs. Nat. _____

1st 24 hrs. after shot _____

Gas _____ Cu. Ft

Dry Hole _____

Abandoned _____


Date

2/9, 1917 Carney Scot

Map No. _____ Sec. 10 Twp. 27 R. 4
 Well No. 2 Robertson Farm
McNair Company

NORTH

WEST

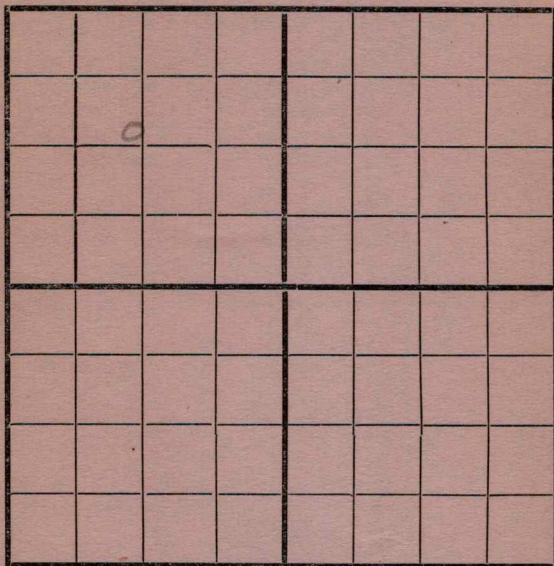

EAST

SOUTH

Location _____
 Rig Up _____
 Drilling and remarks

1775

RECORD

Cased _____ in. _____ Ft.
 Sand _____
 Gas _____
 Oil _____
 Total Depth _____

PRODUCTION

1st 24 hrs. Nat. _____
 1st 24 hrs. after shot _____
 Gas _____ Cu. Ft.
 Dry Hole _____
 Abandoned _____

Date

2/26 191 7 Cordy Scout

Map No. _____ Sec. 10 Twp. 22 R. 4Well No. 2 Robertson Farm
Magruder Company

NORTH

WEST

EAST

SOUTH

REMARKS:

1260

Date

3-5-17, 1917 Cardiff Scout

Map No. _____ Sec. 10 Twp. 27 R. 4
 Well No. 2 Robertson Farm
McNair Company

NORTH

WEST

EAST

SOUTH

Location _____

Rig Up _____

Drilling and remarks

1330'

RECORD

Cased _____ in. _____ Ft.

Sand _____

Gas _____

Oil _____

Total Depth _____

PRODUCTION

1st 24 hrs. Nat. _____

1st 24 hrs. after shot _____

Gas _____ Cu. Ft.


Dry Hole _____

Abandoned _____

Date

3/12, 191 7 Conley Scout

Map No. Sec. 10 Twp. 27 R. 4
 Well No. 2 Robertson Farm
McMan Company

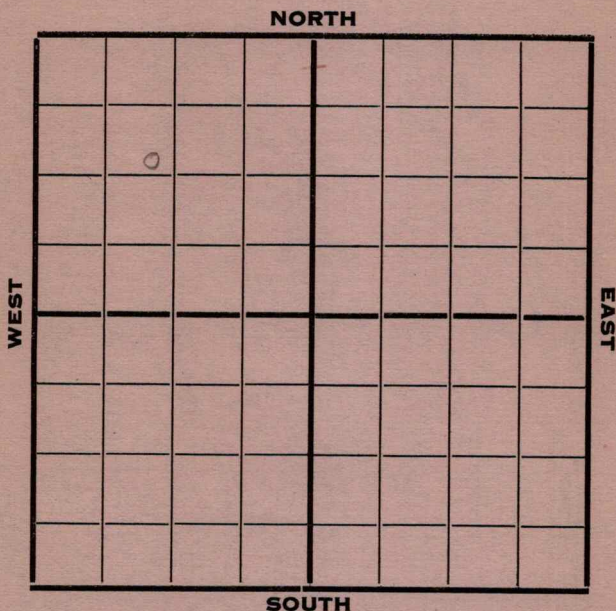

Location

Rig up

Drilling and Remarks:

1830

RECORD

Cased in. Ft.

Sand

Gas

Oil

Total Depth

PRODUCTION

1st 24 hrs. Nat.

1st 24 hrs. after shot

Gas..... Cu. Ft.

Dry Hole

Abandoned


Date

3/19, 1917, Carly Scout

Map No. _____ Sec. 10 Twp. 27 R. 4
 Well No. 2 Robertson Farm _____
McMan Company _____

NORTH

WEST

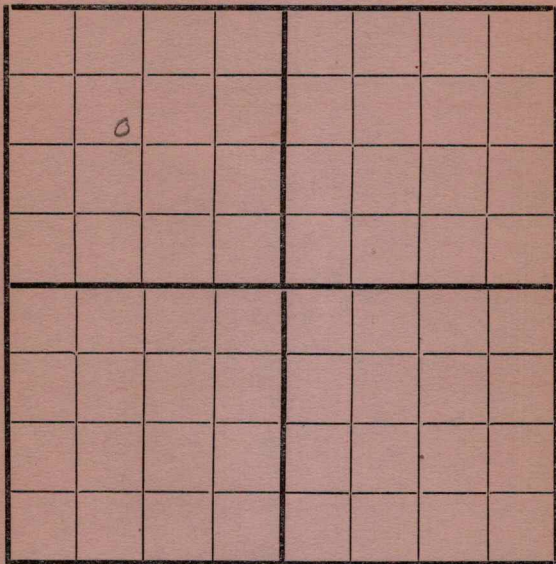

EAST

SOUTH

Location _____

Rig Up _____

Drilling and remarks

2100'

RECORD

Cased _____ in. _____ Ft.

Sand _____

Gas _____

Oil _____

Total Depth _____

PRODUCTION

1st 24 hrs. Nat. _____

1st 24 hrs. after shot _____

Gas _____ Cu. Ft.

Dry Hole _____

Abandoned _____

Date


3/26 191 7 Casey Scout

Map No. _____ Sec. 10 Twp. 27 R. 4
 Well No. 2 Robertson Farm
McMann Company

NORTH

WEST

EAST

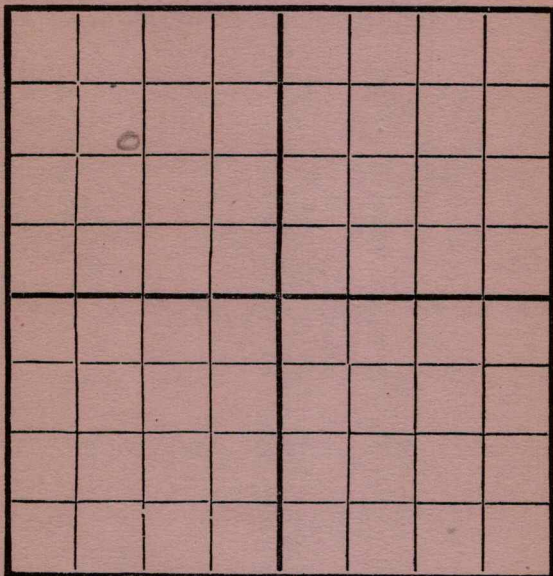

SOUTH

Location _____

Rig Up _____

Drilling and remarks

2225'

RECORD

Cased _____ in. _____ Ft.

Sand _____

Gas _____

Oil _____

Total Depth _____

PRODUCTION

1st 24 hrs. Nat. _____

First 24 hrs. after shot _____

Gas _____ Cu. Ft.

Dry Hole _____


Abandoned _____

Date

4/4, 1917 C. C. C. Scout

Map No. _____ Sec. 10 Twp. 32 R. 4
Well No. 2 Robertson Farm _____
McNamee Company _____

NORTH

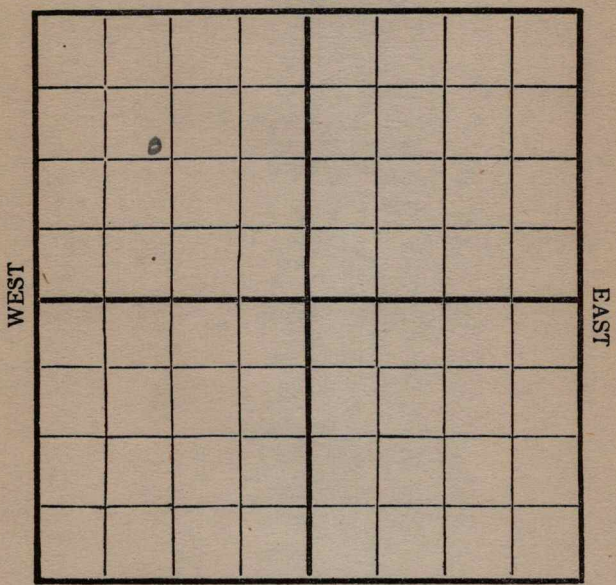

SOUTH

Location _____
Rig Up _____
Drilling and remarks
Shut Down
2225'

RECORD

Cased _____ in. _____ Ft.
Sand _____
Gas _____
Oil _____
Total Depth _____

PRODUCTION

1st 24 hrs. Nat. _____
1st 24 hrs. after shot _____
Gas _____ Cu. Ft.
Dry Hole _____
Abandoned _____

Date 4/10, 1917 C. C. C. Scout _____

Map No. _____ Sec. 10 Twp. 27 R. 4
 Well No. 2 Robertson Farm _____
Magnolia Company _____

NORTH

WEST

EAST

COMPLETED

SOUTH

Location _____
 Rig Up _____
 Drilling and remarks _____

*Estimated
 good for
 30 Bbls*

RECORD

Cased _____ in. _____ Ft.
 Sand 594-2610
 Gas _____
 Oil _____
 Total Depth _____


PRODUCTION

1st 24 hrs. Nat. _____
 1st 24 hrs. after shot _____
 Gas _____ Cu. Ft.
 Dry Hole _____
 Abandoned _____

Date

4/17, 191 7 Candif Scout

Map No. _____ Sec. 10 Twp. 27 R. 4
 Well No. 3 Robertson Farm
Magnolia Company
 NORTH

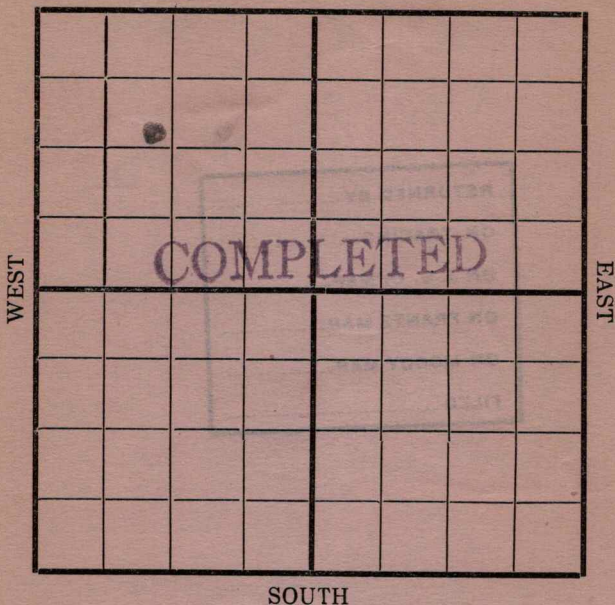

Location _____
 Rig Up _____
 Drilling and remarks _____

*Estimated
 good for
 30 Bbls*

RECORD

Cased _____ in. _____ Ft.
 Sand 2594-2610
 Gas _____
 Oil _____
 Total Depth _____

PRODUCTION

1st 24 hrs. Nat. _____
 1st 24 hrs. after shot _____
 Gas _____ Cu. Ft.
 Dry Hole _____
 Abandoned _____

Date

4/17, 191 7 Cordiff Scout