


Map No. _____ Sec. 10 Twp. 27 R. 4Well No. 2 x Robertson Farm _____McMan Company _____

NORTH

WEST

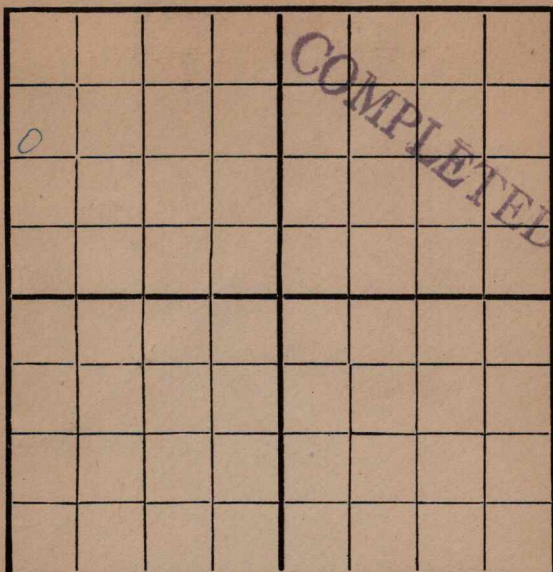

EAST

SOUTH

Location 8/30

Drilling Remarks

10/10 = 10/17 = 10/23 =
325 = 11/9 =
800 = 11/14
1360 = 11/20
1770 = 11/27
1825 = 12/4
2020 = 12/11 = top sand
2145 = 12/18
2245 = 12/28

Rig Up 10/2/16

Drilling Remarks

RECORD

Cased _____ in. _____ Ft.

Sand _____

Gas _____

Oil _____

Total Depth _____

PRODUCTION

1st 24 hrs. Nat. _____

1st 24 hrs. after shot _____

Gas _____ Cu. Ft.

Dry Hole _____


Abandoned _____

Map No. _____ Sec. 10 Twp. 22 R. 4Well No. #2 Robertson Farm_____McKean Company

NORTH

WEST

EAST

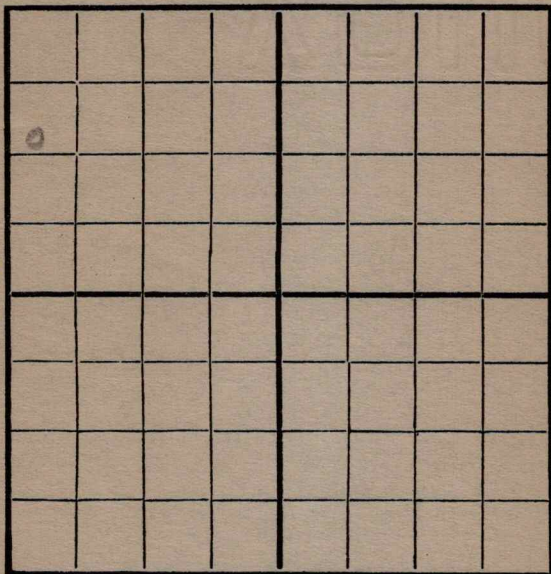

SOUTH

Location _____

Rig Up _____

Drilling and remarks

*No. Changed
from 1 to 2*

RECORD

Cased _____ in. _____ Ft.

Sand _____

Gas _____

Oil _____

Total Depth _____

PRODUCTION

1st 24 hrs. Nat. _____

1st 24 hrs. after shot _____

Gas _____ Cu. Ft.

Dry Hole _____

Abandoned _____

Date


12/2, 1916, Cardiff Scout

Map No. _____ Sec. 10 Twp. 27 R. 4Well No. 2 Robertson Farm _____
McMurry Company

NORTH

WEST

EAST

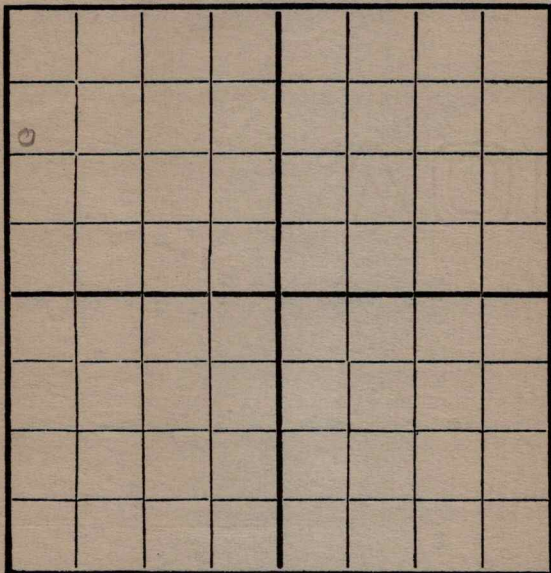

SOUTH

Location _____

Rig Up _____

Drilling and remarks

1825

RECORD

Cased _____ in. _____ Ft.

Sand _____

Gas _____

Oil _____

Total Depth _____

PRODUCTION

1st 24 hrs. Nat. _____

1st 24 hrs. after shot _____

Gas _____ Cu. Ft.

Dry Hole _____

Abandoned _____


Date

12-4, 1916, Cordiff Scout

Map No. _____ Sec. 10 Twp. 27 R. 4Well No. 2 Robertson FarmMc Uen Company

NORTH

WEST

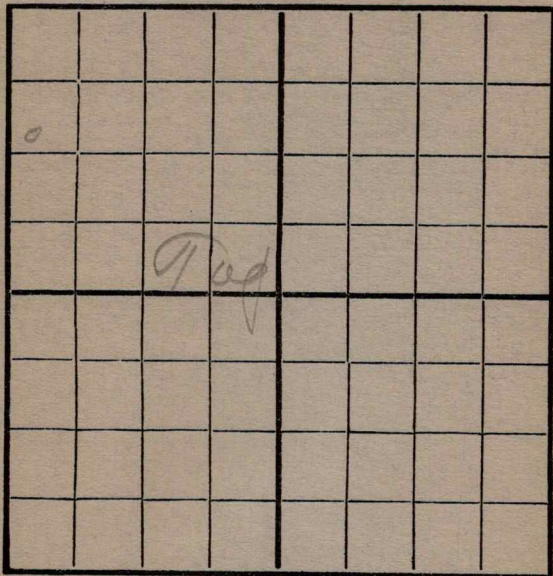

EAST

SOUTH

RECORD

Location _____

Cased _____ in. _____ Ft.

Rig Up _____

Sand 2020

Drilling and remarks

Gas _____

Oil _____

Total Depth _____

PRODUCTION

1st 24 hrs. Nat. _____

1st 24 hrs. after shot _____

Gas _____ Cu. Ft.


Dry Hole _____

Abandoned _____

Date

12/11, 1916, Cordell Scout

Map No. _____ Sec. 10 Twp. 27 R. 4
 Well No. 2 Robertson Farm _____
 _____ Company

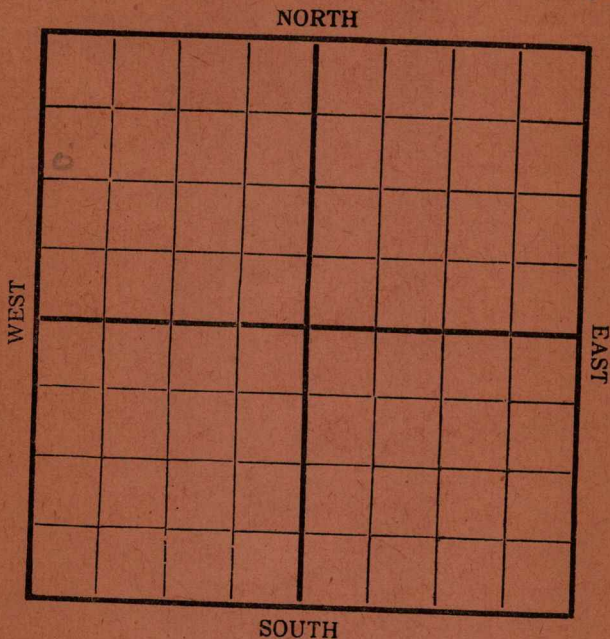

Location _____
 Rig Up _____
 Drilling and remarks _____

RECORD

Cased _____ in. _____ Ft.
 Sand _____
 Gas _____
 Oil _____
 Total Depth _____

PRODUCTION

1st 24 hrs. Nat. _____
 1st 24 hrs. after shot _____
 Gas _____ Cu. Ft.
 Dry Hole _____
 Abandoned _____


Date 12/18/6 _____ Scout _____

Map No. _____ Sec. 10 Twp. 27 R. 4
 Well No. 2 Robinson Farm _____
His Honor Company _____

NORTH

WEST

EAST

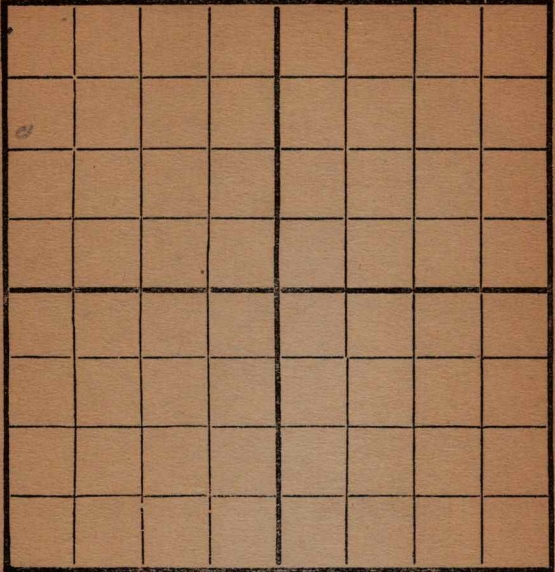

SOUTH

Location _____
 Rig Up _____
 Drilling and remarks _____

2245

RECORD

Cased _____ in. _____ Ft.
 Sand _____
 Gas _____
 Oil _____
 Total Depth _____

PRODUCTION


1st 24 hrs. Nat. _____
 First 24 hrs. after shot _____
 Gas _____ Cu. Ft.
 Dry Hole _____
 Abandoned _____

Date 12/28, 1916 C. C. C. C. Scout _____

Map No. _____ Sec. 10 Twp. 27 R. 4
 Well No. 2 Roberts Farm
Ma Union Company

NORTH

WEST

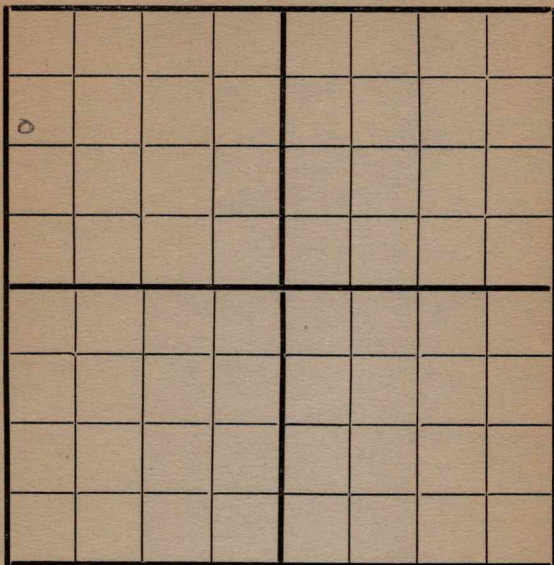

EAST

SOUTH

Location _____
 Rig Up _____
 Drilling and remarks

2330'

RECORD

Cased _____ in. _____ Ft.
 Sand _____
 Gas _____
 Oil _____
 Total Depth _____

PRODUCTION

1st 24 hrs. Nat. _____
 1st 24 hrs. after shot _____
 Gas _____ Cu. Ft.
 Dry Hole _____
 Abandoned _____

Date

1/1

191

7

Carly

Scout

Map No. _____ Sec. 10 - Twp. 22 R. 4
 Well No. 2 Robertson Farm
Nea Union Company

NORTH

WEST

EAST

SOUTH

Location _____
 Rig Up _____
 Drilling and remarks

*Est at 300
 or 400 Bbls*

RECORD

Cased _____ in. _____ Ft.
 Sand 2525-2527
 Gas _____
 Oil _____
 Total Depth _____

PRODUCTION

1st 24 hrs. Nat. _____
 1st 24 hrs. after shot _____
 Gas _____ Cu. Ft.
 Dry Hole _____
 Abandoned _____

Date

1/8, 1917 Co. 2 Scout