


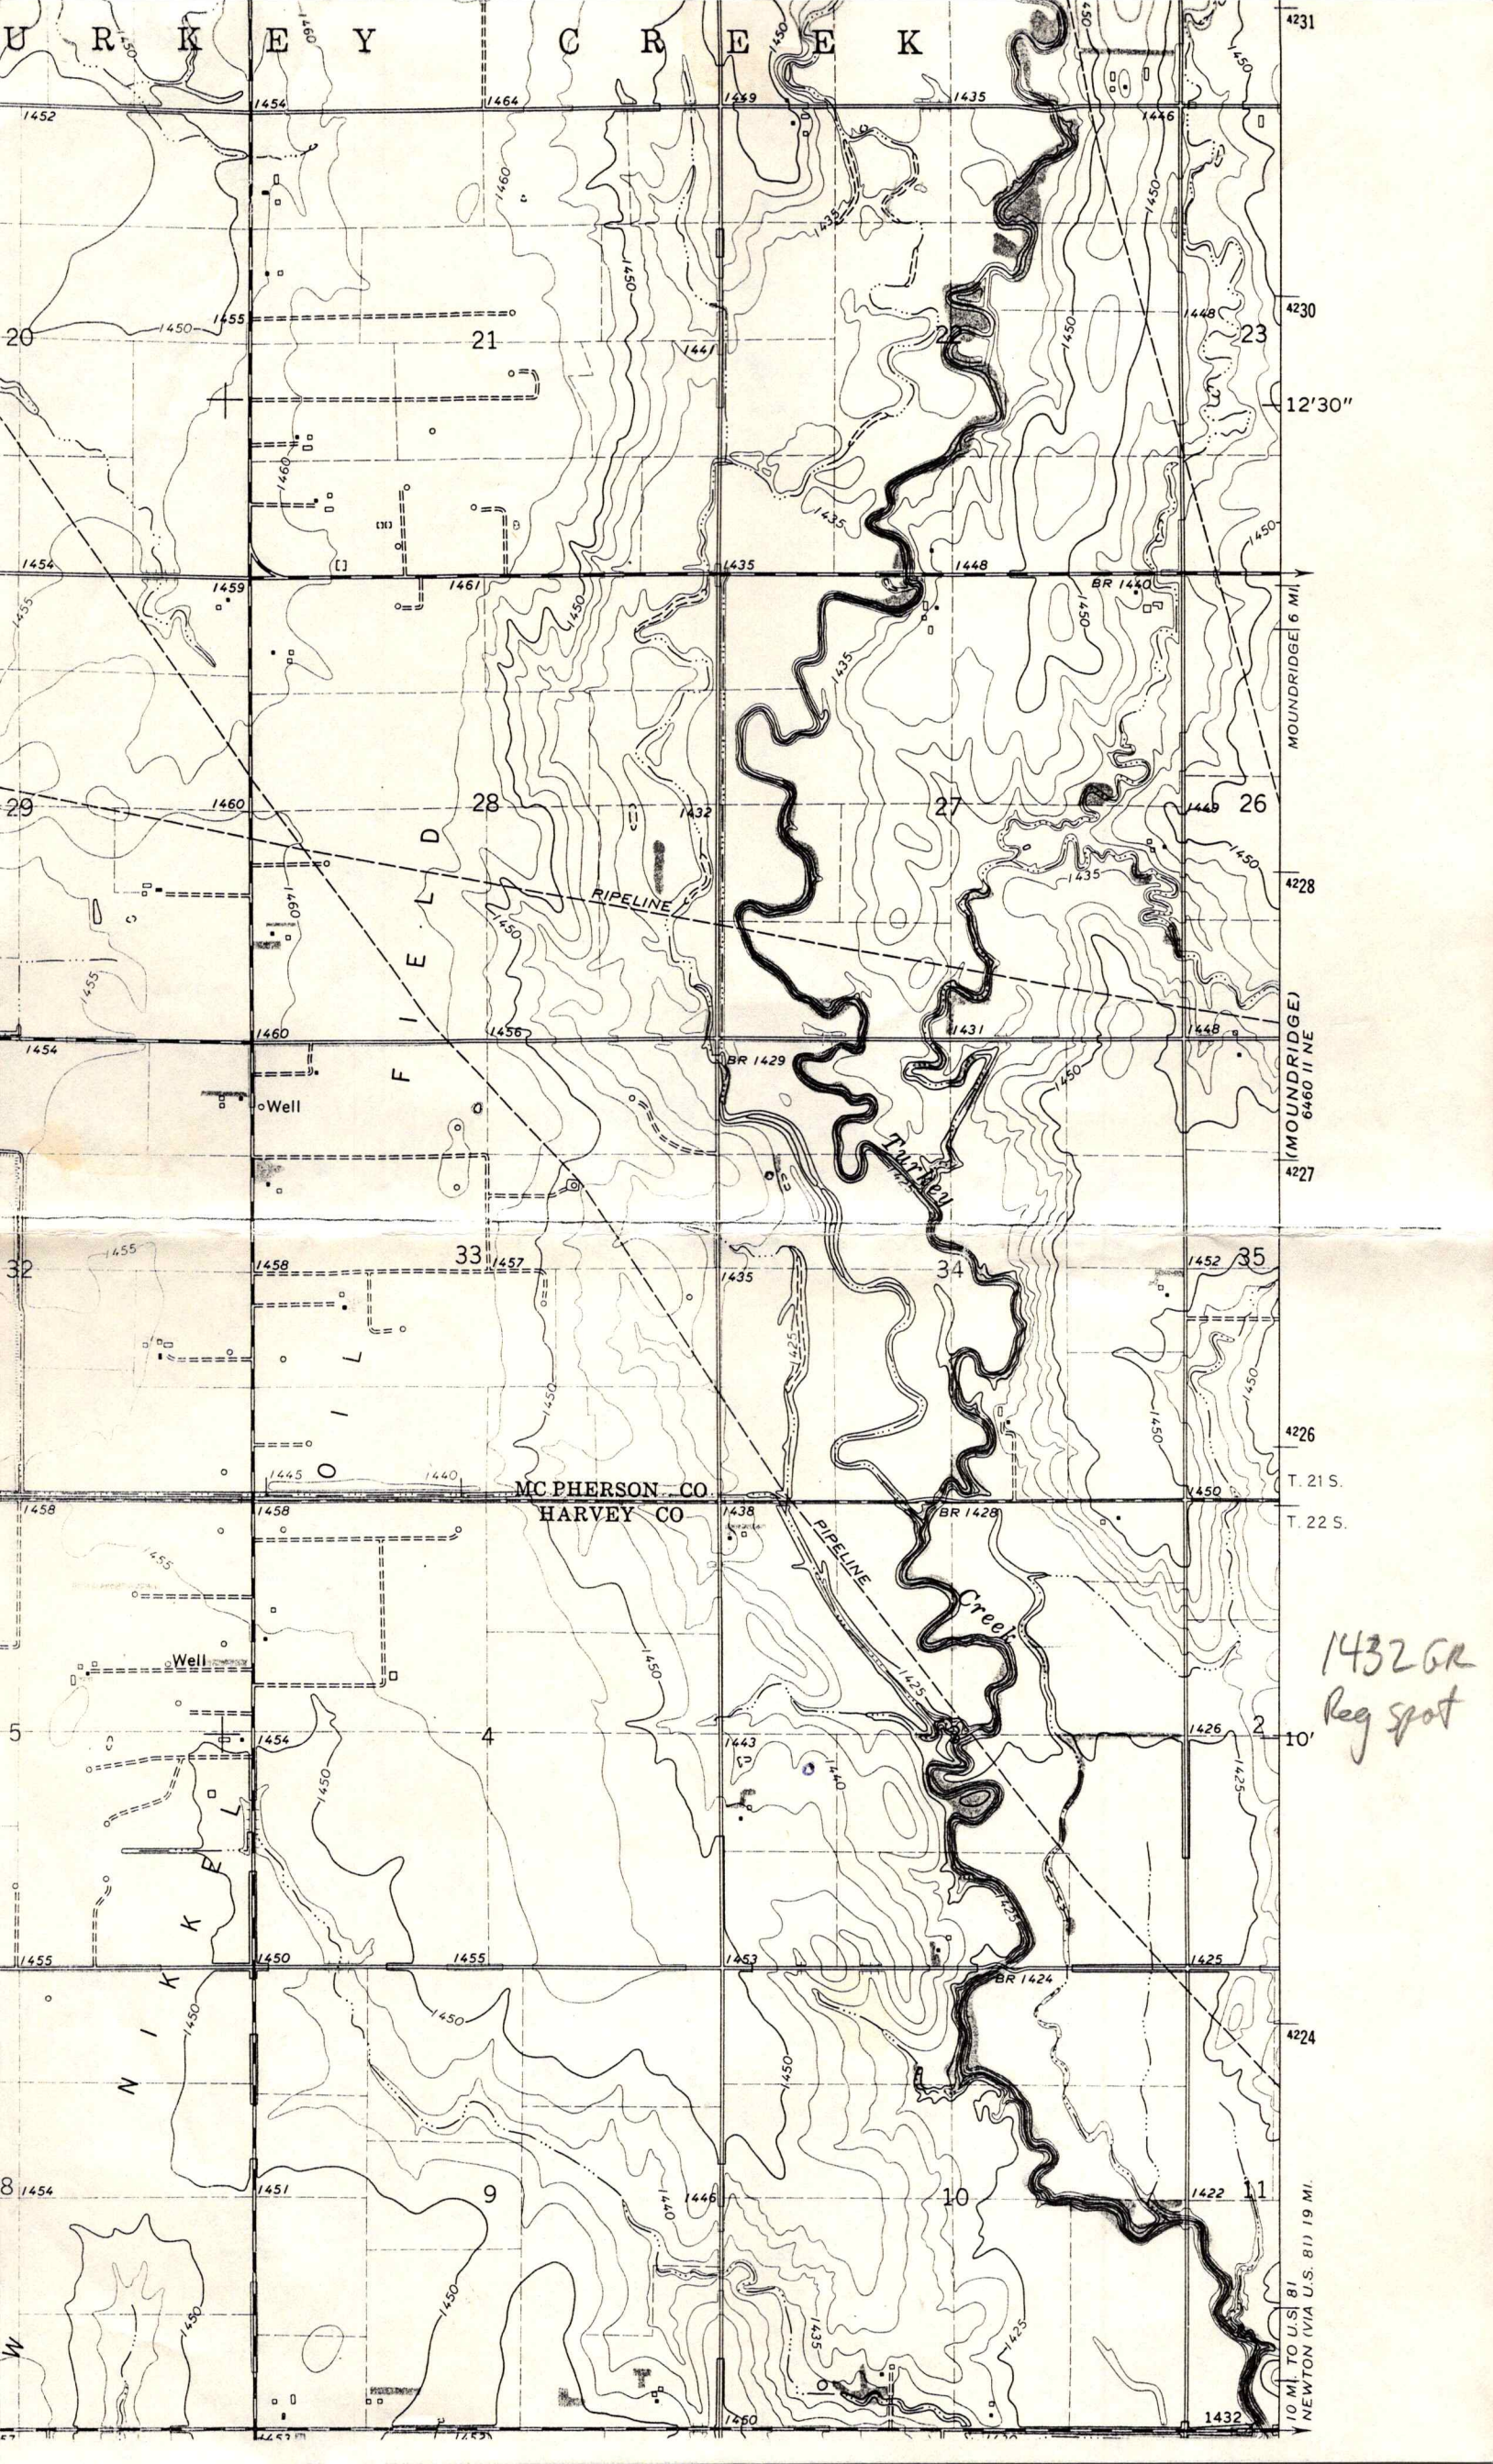

1432 GR
Reg spot