

KANSAS

Butler

Section 26 Township 28 Range 3E

Well No. 8 Hawks

Company Padco & Sohio

Misc.
NORTH

WEST

SOUTH

EAST

Sec. 26 Twp. 28 R. 3-E ✓

Well No. #8 Hawks Farm

Padco & Sohio

Company

Miscellaneous


990 Ft. from N. Line

 Ft. from S. Line

 Ft. from E. Line

990 Ft. from W. Line

SE NW NW

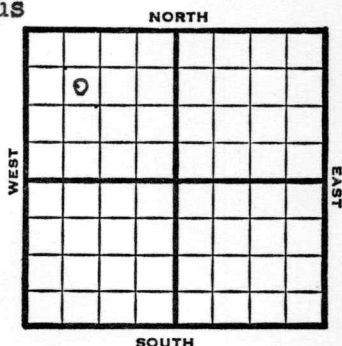

1948

Eli 1323'

REPORT

9/29

Location

10/6

"

10/13

8" @ 165'

KC 2300'

Drlg. 2360'

10/19

Drlg. 2975'

10/27

TD 3000'

Simp 2984

5" @ 2965

Pump 75 oil Pot

43° Gr.

Comp

COMPLETED

Map No. _____ Sec. 26 Twp. 28 R. 3E


Well No. 8 Hawks

Padco & Sohio Company

FIRST REPORT Contractor

SE NW NW

SECTION PLAT

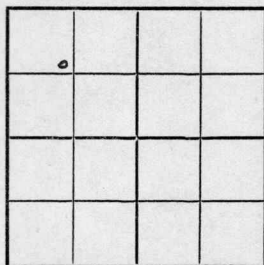

990 Ft. from N. Line

_____ Ft. from S. Line

_____ Ft. from E. Line

990 Ft. from W. Line

Butler County

Location X

Rig up _____

Drilling and Remarks:

RECORD

Cased _____ in., _____ ft.

Sand _____

Gas _____

Oil _____

Total Depth _____

PRODUCTION

1st 24 hrs. Nat. _____

1st 24 hrs. after shot _____

Gas _____ Cu. Ft.

Dry Hole _____

Abandoned _____

Date

SEP 29 1948 19 _____ S. J. LEWIS Scout

Map No. 12 Sec. 26 Twp. 28 R. 3E

Well No. 8 Hawks

Padco & Sohio

Company

COMPLETE

Contractor

SE NW NW

E1, 1328
SECTION PLAT

990 Ft. from N. Line

_____ Ft. from S. Line

_____ Ft. from E. Line

990 Ft. from W. Line

0			

Butler County

Location _____

Rig up _____

Drilling and Remarks:

Drill 2954

502965

Pump 25 oil Bt

43 2/3

RECORD

Cased _____ in., _____ ft.

Sand _____

Gas _____

Oil ☒

Total Depth 2000

PRODUCTION

1st 24 hrs. Nat. _____

1st 24 hrs. after shot _____

Gas _____ Cu. Ft.

Dry Hole _____

Abandoned _____

Date

OCT 27 1948

19

S. J. LEWIS

Scout