

KANSAS

Butler


Section 26 Township 28 Range 3-E

Well No. #9 Hawks

Company Padco etal

Miscellaneous

NORTH

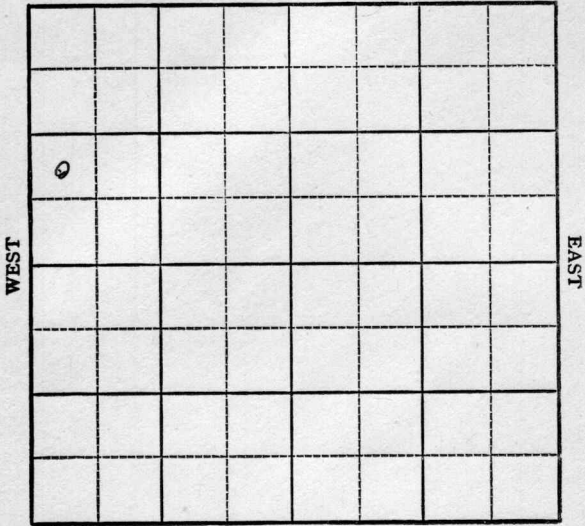

SOUTH

KANSAS

Butler

Sec. 26 Twp. 28 R. 3-E ✓

Well No. #9 Hawks Farm

Padco et al. Company
Miscellaneous


_____ Ft. from N. Line

990 Ft. from S. Line

_____ Ft. from E. Line

330 Ft. from W. Line

NW SW NW

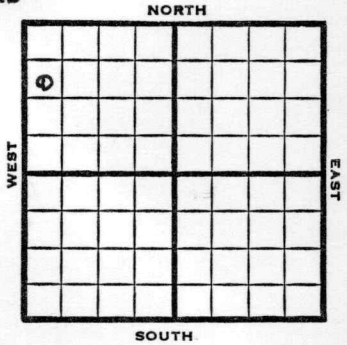

1948

Eli 1320

REPORT

10/13

Location

10/19

8" @ 168'

Drlg. 2500'

10/27

TD 3003

Simp 2985'

5" @ 2960'

Pump 75 oil Pot

43° Gr.

Comp

COMPLETED

Map No. _____ Sec. 26 Twp. 28 R. 3E

Well No. 9 Hawks

Padco etal. Company

-IRST REPORT

Contractor

NW SW NW

SECTION PLAT

_____ Ft. from N. Line

990 Ft. from S. Line

_____ Ft. from E. Line

330 Ft. from W. Line

o			

Butler County

Location x

Rig up _____

Drilling and Remarks:

RECORD

Cased _____ in., _____ ft.

Sand _____

Gas _____

Oil _____

Total Depth _____

PRODUCTION

1st 24 hrs. Nat. _____

1st 24 hrs. after shot _____

Gas _____ Cu. Ft.

Dry Hole _____

Abandoned _____

Date

OCT, 13 1948 19

S. J. LEWIS Scout

