

Map No. _____ Sec. 0 Twp. 10 R. 12
Well No. 24 CC Warner Farm
Empire Company

NORTH

WEST

EAST

SOUTH

Location _____

Drilling Remarks:

Rig Up-----

Drilling Remarks:

RECORD

Cased_____ in._____ft.

Sand _____

Gas _____

Oil _____

Total Depth_____

PRODUCTION

1st 24 hrs. Nat.-----

1st 24 hrs. after shot-----

Gas-----cu. ft


Dry Hole_____

Abandoned -----

Map No. K-11 Sec. 8 Twp. 28 R. 4
 Well No. 24 E C Varner Farm
Empire Company

NORTH

WEST

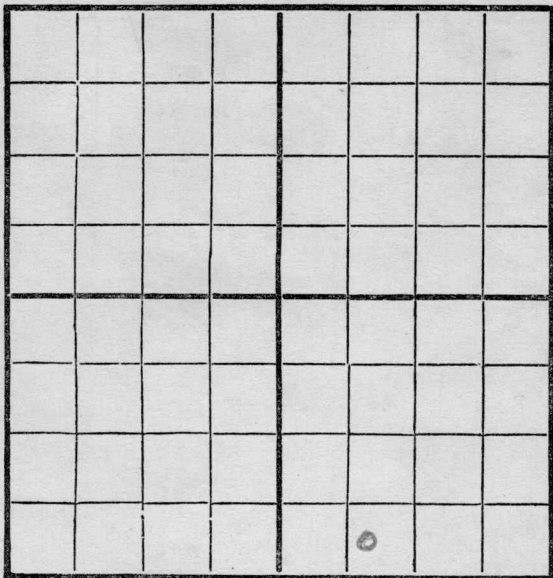

EAST

SOUTH

Location -----

Rig Up -----

Drilling and remarks

RECORD

Cased ----- in. ----- Ft.

Sand -----

Gas -----

Oil -----

Total Depth -----

PRODUCTION

1st 24 hrs. Nat. -----

1st 24 hrs. after shot -----

Gas ----- Cu. Ft.

Dry Hole -----

Abandoned -----

First Report


Date

6/12, 1917, Condit Scout

*1126' E of Centerline
200' N of S.L.*

Map No. _____ Sec. 8 Twp. 28 R. 4
 Well No. 24 E. C. Varner Farm _____
Empire Company _____

NORTH

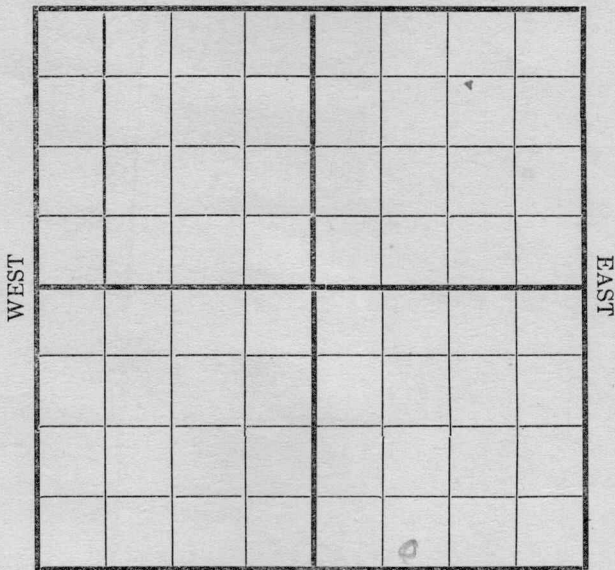

SOUTH

Location _____
 Rig Up _____
 Drilling and remarks _____

Spending

RECORD

Cased _____ in. _____ Ft.
 Sand _____
 Gas _____
 Oil _____
 Total Depth _____

PRODUCTION

1st 24 hrs. Nat. _____
 1st 24 hrs. after shot _____
 Gas _____ Cu. Ft.
 Dry Hole _____
 Abandoned _____


Date

6/28, 1917 Conley Scout

Map No. _____ Sec. 8 Twp. 28 R. 4
 Well No. 24 E C Verner Farm _____
Company Company _____

NORTH

WEST

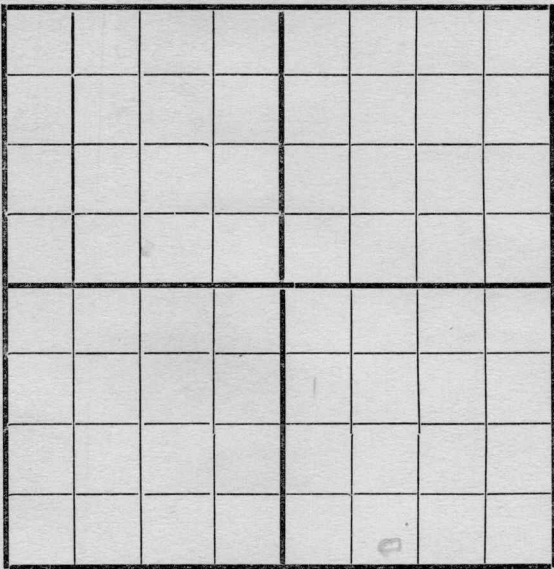

EAST

SOUTH

Location _____
 Rig Up _____
 Drilling and remarks _____

RECORD

Cased _____ in. _____ Ft.
 Sand _____
 Gas _____
 Oil _____
 Total Depth _____

PRODUCTION

1st 24 hrs. Nat. _____
 1st 24 hrs. after shot _____
 Gas _____ Cu. Ft.
 Dry Hole _____
 Abandoned _____


Date

6/27 191 2 Carroll Scout

Map No. _____ Sec. 8 Twp. 28 R. 4Well No. 24 Harmer FarmEmpire Company

NORTH

WEST

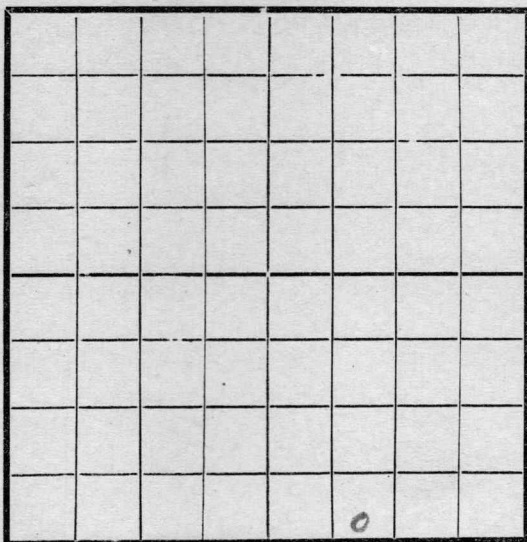

EAST

SOUTH

Location _____

Rig Up _____

Drilling and remarks

800'

RECORD

Cased _____ in. _____ Ft.

Sand _____

Gas _____

Oil _____

Total Depth _____

PRODUCTION

1st 24 hrs. Nat. _____

1st 24 hrs. after shot _____

Gas _____ Cu. Ft.

Dry Hole _____

Abandoned _____

Date

7/6, 1917 Clay Scout


Map No. _____ Sec. 8 Twp. 28 R. 4

Well No. 24 Varner Farm _____

_____ Company _____

NORTH

WEST

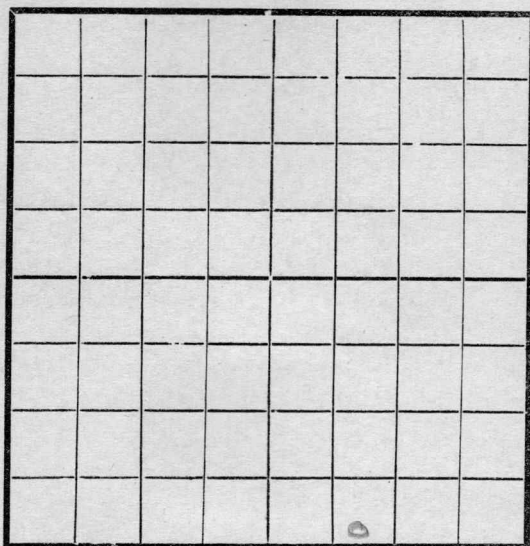

EAST

SOUTH

Location _____

Rig Up _____

Drilling and remarks

1075'

RECORD

Cased _____ in. _____ Ft.

Sand _____

Gas _____

Oil _____

Total Depth _____

PRODUCTION

1st 24 hrs. Nat. _____

1st 24 hrs. after shot _____

Gas _____ Cu. Ft.

Dry Hole _____

Abandoned _____


Date

7/13, 1912 Condy Scout

Map No. _____ Sec. 8 Twp. 28 R. 4Well No. 24 E. C. Varner FarmEmpire Company

NORTH

WEST

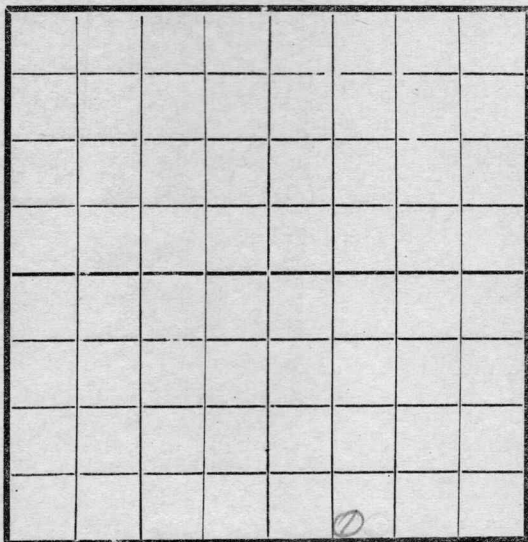

EAST

SOUTH

Location _____

Rig Up _____

Drilling and remarks

at 2020

RECORD

Cased _____ in. _____ Ft.

Sand _____

Gas _____

Oil _____

Total Depth _____

PRODUCTION

1st 24 hrs. Nat. _____

1st 24 hrs. after shot _____

Gas _____ Cu. Ft.

Dry Hole _____

Abandoned _____

Date

8-31, 1917Lantry Scout

Map No. _____ Sec. 8 Twp. 28 R. 4Well No. 24 Farmer Farm _____Engine Company _____

NORTH

WEST

EAST

SOUTH

Location _____

Rig Up _____

Drilling and remarks

Top sand
2400

RECORD

Cased _____ in. _____ Ft.

Sand _____

Gas _____

Oil _____

Total Depth _____

PRODUCTION

1st 24 hrs. Nat. _____

1st 24 hrs. after shot _____

Gas _____ Cu. Ft.

Dry Hole _____

Abandoned _____


Date

9/5, 1917 C. A. Smith Scout

Map No. _____ Sec. 8 Twp. 28 R. 4
 Well No. 24 runner Farm _____
Engine Company _____

NORTH

WEST

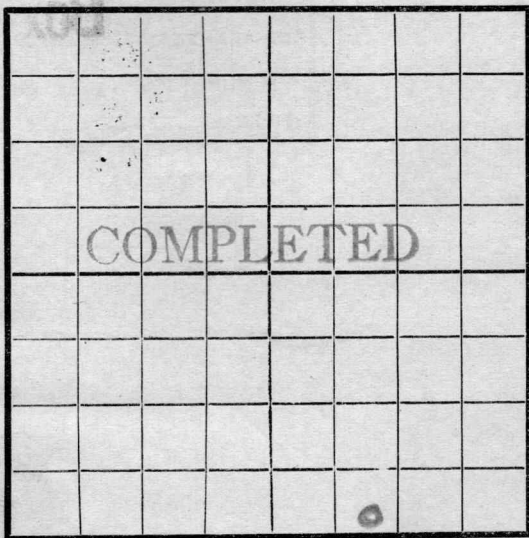

EAST

SOUTH

Location _____

Rig Up _____

Drilling and remarks

Ext at
100
1366

RECORD

Cased _____ in. _____ Ft.
 Sand 2396 - 2420
 Gas _____
 Oil _____
 Total Depth _____

PRODUCTION

1st 24 hrs. Nat. _____
 1st 24 hrs. after shot _____
 Gas _____ Cu. Ft.
 Dry Hole _____
 Abandoned _____

Date

9/28 1917 Candley Scout