


Map No. _____ Sec. 9 Twp. 28 R. 4Well No. T. Alexander Farm _____McMan Company _____

NORTH

WEST

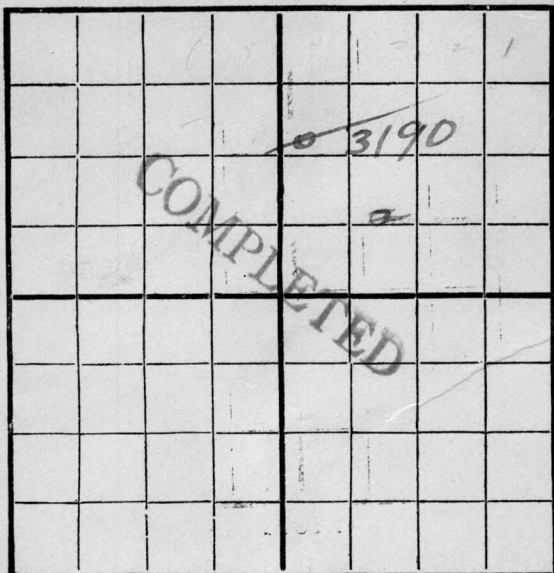

EAST

SOUTH

Location _____

Rig Up _____

Drilling Remarks:

Drilling Remarks:

Dry & Plugged

RECORD

Cased _____ in _____ Ft.

Sand _____

Gas _____

Oil _____

Total Depth _____

PRODUCTION

1st 24 hrs. Nat. _____

1st 24 hrs. after shot _____

Gas _____ Cu. Ft.

Dry Hole _____

Abandoned _____

Map No. _____ Sec. 9 Twp. 28 R. 4

Well No. I Alexander Farm

Mr Man

Company

NORTH

WEST

EAST

SOUTH

Location -----

Rig up -----

Drilling and remarks

2570 cable means
showing of oil in
top of sand
cave and one joint
of pipe not lowered
cleaning out and
will run steel
line and drill
in to night

RECORD

Cased · _____ in. _____ Ft.

Sand -----

Gas _____

Oil _____

Total Depth -----

PRODUCTION

1st 24 hrs. Nat-----

1st 24 hrs. after shot-----

Gas ----- Cu. Ft.

Dry Hole -----

Abandoned -----

Date _____

to night || Abandoned -----
will get log tomorrow and report


3/30

191-6-

Kickland

Scout

Map No. _____ Sec. 9 Twp. 28 R. 4
 Well No. 1 Alexander Farm _____
McMan Company _____

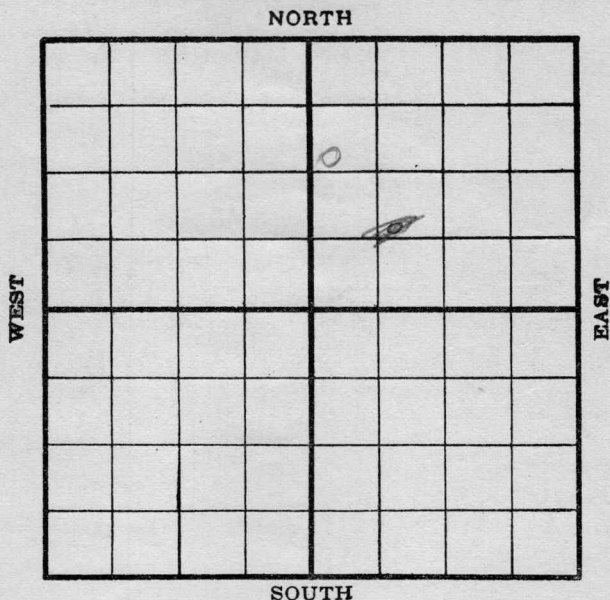

Location _____

Rig up _____

Drilling and remarks

*Reported pumping
about 15 bbls*

RECORD

Cased _____ in. _____ Ft.

Sand _____

Gas _____

Oil _____

Total Depth _____

PRODUCTION

1st 24 hrs. Nat. _____

1st 24 hrs. after shot _____

Gas _____ Cu. Ft.

Dry Hole _____

Abandoned _____

Date


4/2, 1916, Harland Scout

Map No. _____ Sec. 9 Twp. 28 R. 4
 Well No. 1 Alexander Farm _____
McMurray Company _____

NORTH

WEST

EAST

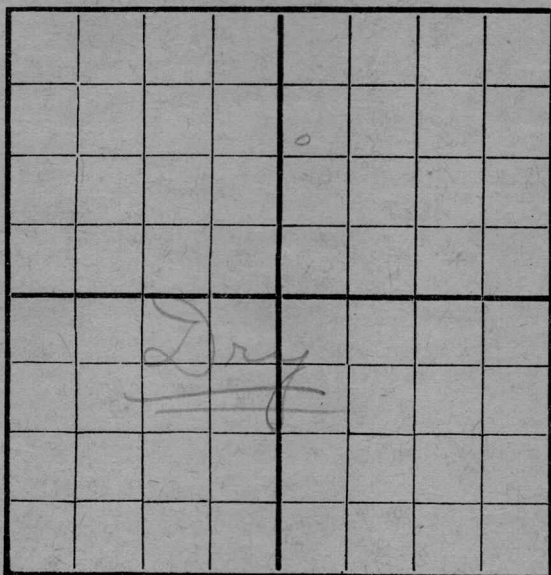

SOUTH

Location _____
 Rig Up _____
 Drilling and remarks _____

RECORD
 Cased _____ in. _____ Ft.
 Sand _____
 Gas _____
 Oil _____
 Total Depth _____

PRODUCTION
 1st 24 hrs. Nat. _____
 1st 24 hrs. after shot _____
 Gas _____ Cu. Ft.
 Dry Hole _____
 Abandoned _____


Date

5/22, 1916 Scout Scout

Map No. _____ Sec. 9 Twp. 28 R. 4
 Well No. 1 Alexander Farm _____
McMan Company _____

NORTH

WEST

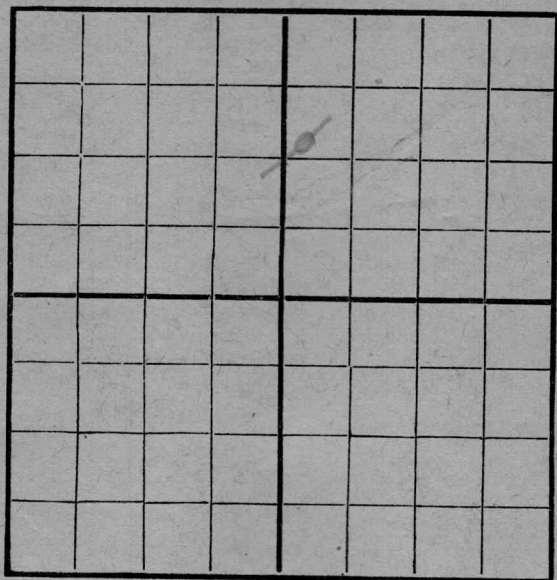

EAST

SOUTH

Location _____

Rig Up _____

Drilling and remarks

RECORD

Cased _____ in. _____ Ft.

Sand _____

Gas _____

Oil _____

Total Depth _____

PRODUCTION

1st 24 hrs. Nat. _____

1st 24 hrs. after shot _____

Gas _____ Cu. Ft.

Dry Hole _____

Abandoned _____

Date

5/30, 1916 Scout

Butler
 K 11 KANSAS MAP NO. _____ SEC. 9 TWP. 28S R. 1E
 WELL NO. 1 Alexander
M. S. Mann COMPANY

CONTRACTOR _____

ABANDONED

SECTION PLAT

		0	

_____ FT. FROM N. LINE
 _____ FT. FROM S. LINE
 _____ FT. FROM E. LINE
 _____ FT. FROM W. LINE

RECORD

LOCATION 11
 RIG UP _____
 DRILLING AND REMARKS:

CASED _____ IN. _____ FT.
 SAND _____
 GAS _____
 OIL _____
 TOTAL DEPTH 3250

PRODUCTION

1ST 24 HRS. NAT. _____
 1ST 24 HRS. AFTER SHOT _____
 GAS _____ CU. FT.
 DRY HOLE ✓
 ABANDONED ✓

DATE

5-30-14 192 _____ SCOUT