

Map No. _____ Sec. 9 Twp. 28 R. 4Well No. 1-Alexander Farm _____National Company _____

NORTH

WEST

EAST

SOUTH

Location _____

Rig Up 10/23/16

Drilling Remarks:

Drilling Remarks:

Rig up - 10/301500' = 11/91640' = 11/141360' = 11/27-12/41390' = 12/111450' = 12/181600' = 12/28

RECORD

PRODUCTION

Cased _____ in _____ Ft.

1st 24 hrs. Nat. _____

Sand _____

1st 24 hrs. after shot _____

Gas _____

Gas _____ Cu. Ft.

Oil _____

Dry Hole _____

Total Depth _____


Abandoned _____

Map No. _____ Sec. 9 Twp. 28 R. 4
 Well No. Calymander Farm _____
Nation Company _____

NORTH

WEST

EAST

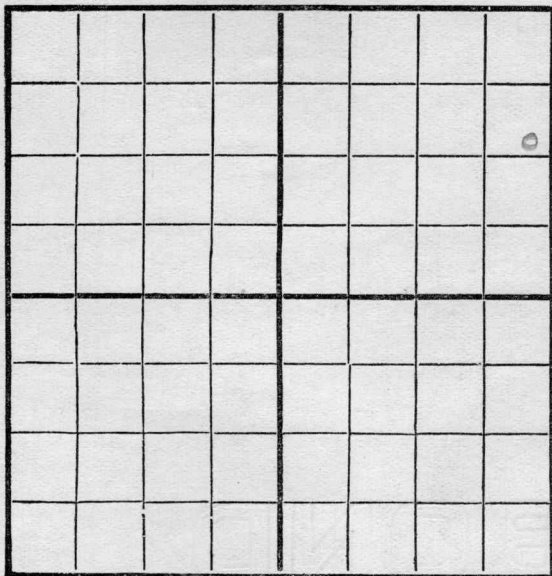

SOUTH

Location _____
 Rig Up _____
 Drilling and remarks _____

RECORD

Cased _____ in. _____ Ft.
 Sand _____
 Gas _____
 Oil _____
 Total Depth _____

PRODUCTION

1st 24 hrs. Nat. _____
 First 24 h. s. after shot _____
 Gas _____ Cu. Ft.
 Dry Hole _____
 Abandoned _____

Date

1935 191 6 Peary Scout

Map No. _____ Sec. 7 Twp. 8 R. 9

Well No. 1444 Farm

----- McDonald's Company

NORTH

WEST

EAST

SOUTH

Location _____

Rig Up _____

Drilling and remarks

RECORD

Cased _____ in. _____ Ft.

Sand

Gas _____

Oil _____

Total Depth.....

PRODUCTION

1st 24 hrs. Nat. _____

First 24 h_s. after shot_____

Gas_____Cu. Ft.

Dry Hole -----

Abandoned-----

Date _____

1910 Scout

Map No. _____ Sec. 9 Twp. 4 R. 1

Well No. 10-1-1 Farm _____

_____ Company

NORTH

WEST

EAST

SOUTH

Location _____

Rig Up-----

Drilling and remarks

1500'

(Reported 2 11/9 as
only Rig)

RECORD

Cased _____ in. _____ Ft.

Sand _____

Gas _____

Oil _____

Total Depth.....

PRODUCTION

1st 24 hrs. Nat.-----

First 24 hrs. after shot-----

Gas _____ Cu. Ft.

Dry Hole_____


Abandoned.....

Date _____

11/9, 1916. 6 Leaves Scout

Map No. _____ Sec. 9 Twp. 28 R. 4
 Well No. 1640 Farm _____
 _____ Company _____

NORTH

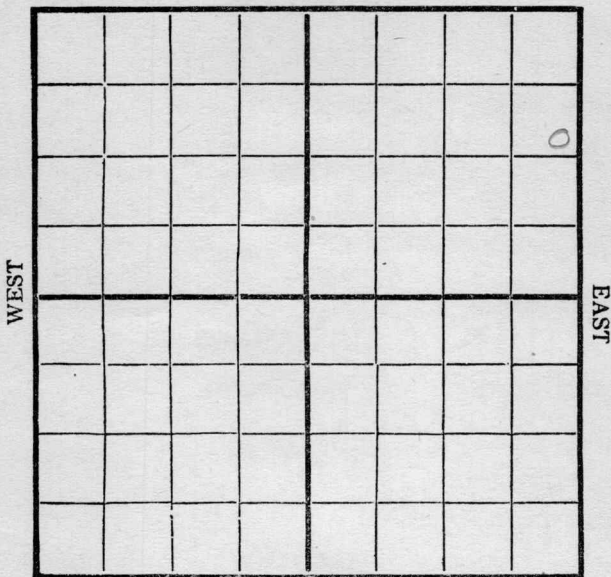

SOUTH

Location _____
 Rig Up _____
 Drilling and remarks _____

1640

RECORD

Cased _____ in. _____ Ft.
 Sand _____
 Gas _____
 Oil _____
 Total Depth _____

PRODUCTION

1st 24 hrs. Nat. _____
 First 24 hrs. after shot _____
 Gas _____ Cu. Ft.
 Dry Hole _____
 Abandoned _____

Date


11/14, 1916 Cordiff Scout

Map No. _____ Sec. 9 Twp. 28 R. 4
 Well No. 1 Adams Farm _____
National Company _____

NORTH

WEST

EAST

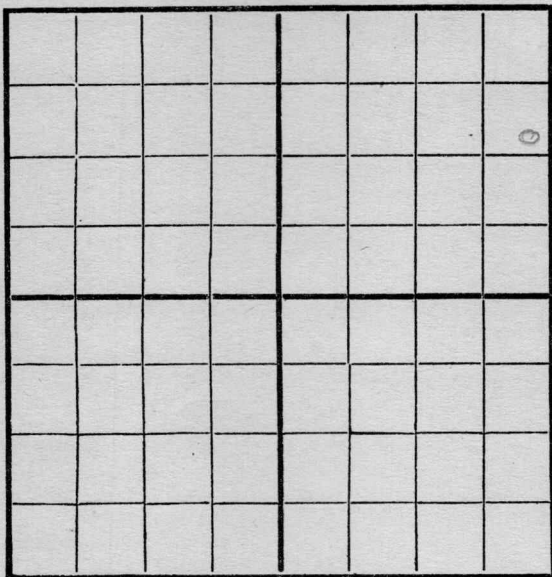

SOUTH

Location _____
 Rig Up _____
 Drilling and remarks _____

Shut Down
at 1640

RECORD

Cased _____ in. _____ Ft.
 Sand _____
 Gas _____
 Oil _____
 Total Depth _____

PRODUCTION

1st 24 hrs. Nat. _____
 1st 24 hrs. after shot _____
 Gas _____ Cu. Ft.
 Dry Hole _____
 Abandoned _____

Date

11/20, 1916 Can. oil Scout

Map No. _____ Sec. 9 Twp. 28 R. 4
 Well No. 1 Alexander Farm _____
National Ref Company _____

NORTH

WEST

EAST

SOUTH

Location _____

Rig Up _____

Drilling and remarks

Shut Down
at 1360'

RECORD

Cased _____ in. _____ Ft.

Sand _____

Gas _____

Oil _____

Total Depth _____

PRODUCTION

1st 24 hrs. Nat. _____

1st 24 hrs. after shot _____

Gas _____ Cu. Ft.

Dry Hole _____

Abandoned _____


Date

4/27, 1916 Cordiff Scout

Map No. _____ Sec. 9 Twp. 28 R. 4Well No. 1 Alexander Farm _____National Ref Company _____

NORTH

WEST

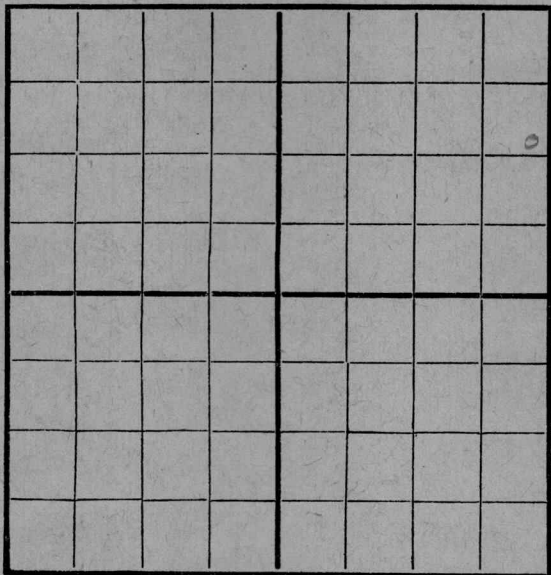

EAST

SOUTH

Location _____

Rig Up _____

Drilling and remarks _____

*Shut Down
at 1360'*

RECORD

Cased _____ in. _____ Ft.

Sand _____

Gas _____

Oil _____

Total Depth _____

PRODUCTION

1st 24 hrs. Nat. _____

1st 24 hrs. after shot _____

Gas _____ Cu. Ft.

Dry Hole _____


Abandoned _____

Date

12/4, 191 *6*, *Cordis* Scout

Map No. _____ Sec. 9 Twp. 28 R. 4
 Well No. 1 Alexander Farm _____
National Company _____

NORTH

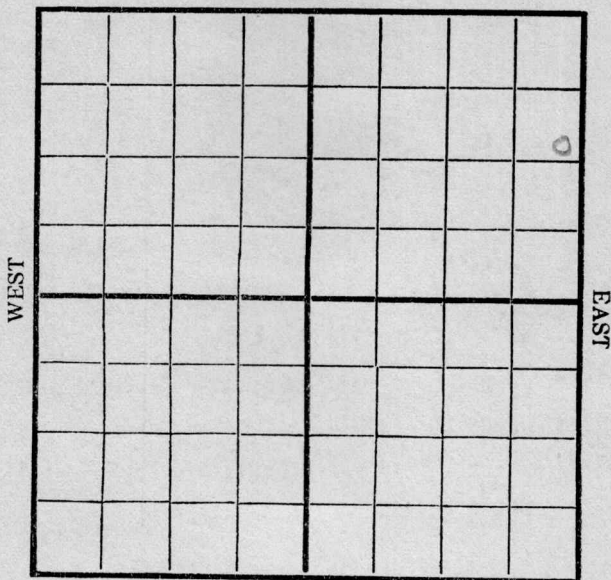

SOUTH

Location _____
 Rig Up _____
 Drilling and remarks

1390'

RECORD

Cased _____ in. _____ Ft.
 Sand _____
 Gas _____
 Oil _____
 Total Depth _____

PRODUCTION

1st 24 hrs. Nat. _____
 1st 24 hrs. after shot _____
 Gas _____ Cu. Ft.
 Dry Hole _____
 Abandoned _____

Date

12/11, 1916, Candiff Scout

Map No. _____ Sec. 9 Twp. 28 R. 4Well No. 1 Alexander FarmNational Ry Company

NORTH

WEST

EAST

SOUTH

RECORD

Location _____

Cased _____ in. _____ Ft.

Rig Up _____

Sand _____

Drilling and remarks

Gas _____

Oil _____

Total Depth _____

PRODUCTION

1st 24 hrs. Nat. _____

1st 24 hrs. after shot _____

Gas _____ Cu. Ft.

Dry Hole _____

Abandoned _____

Date

12/18, 1916 Cord Scout

Map No. _____ Sec. 9 Twp. 28 R. 4
 Well No. 1600 Farm _____
National Company

NORTH

WEST

EAST

SOUTH

Location _____
 Rig Up _____
 Drilling and remarks

1600

RECORD

Cased _____ in. _____ Ft.
 Sand _____
 Gas _____
 Oil _____
 Total Depth _____

PRODUCTION

1st 24 hrs. Nat. _____
 First 24 hrs. after shot _____
 Gas _____ Cu. Ft.
 Dry Hole _____
 Abandoned _____


Date

12/28/6 Cond. _____ Scout
 _____, 191 _____

Map No. _____ Sec. 9 Twp. 28 R. 4Well No. 1 Alexander Farm _____National Company _____

NORTH

WEST

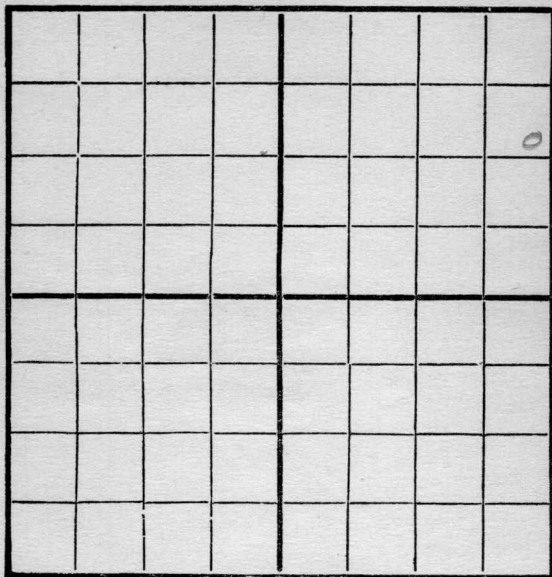

EAST

SOUTH

Location _____

Rig Up _____

Drilling and remarks

2150

RECORD

Cased _____ in. _____ Ft.

Sand _____

Gas _____

Oil _____

Total Depth _____

PRODUCTION

1st 24 hrs. Nat. _____

First 24 hrs. after shot _____

Gas _____ Cu. Ft.

Dry Hole _____

Abandoned _____


Date

1/1, 1917 Condy Scout

Map No. _____ Sec. 9 Twp. 28 R. 4
 Well No. 1 Alexander Farm _____
National Ref Company _____

NORTH

WEST

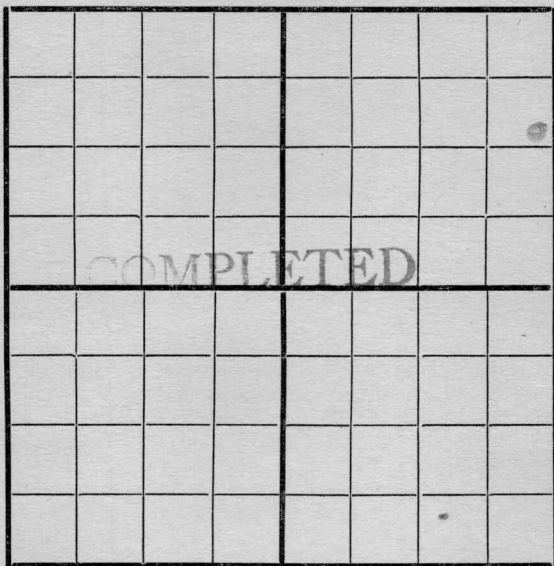

EAST

SOUTH

Location _____

Rig Up _____

Drilling and remarks

*Estimated
 good for
 100/13 bbls.
 Has 1400'
 oil in hole*

RECORD

Cased _____ in. _____ Ft.

Sand 2612-2623

Gas _____

Oil _____

Total Depth _____

PRODUCTION

1st 24 hrs. Nat. _____

1st 24 hrs. after shot _____

Gas _____ Cu. Ft.

Dry Hole _____

Abandoned _____

Date

1/8, 1917 Carroll Scout