


Map No. _____ Sec. 9 Twp. 28 R. K

Well No. 2 Alexander Farm
National Ref Company

NORTH

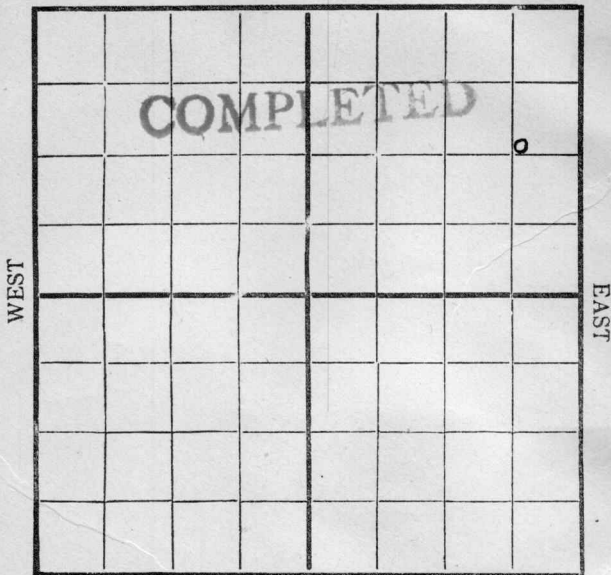

SOUTH

Location _____

Drilling Remarks:

RECORD

Cased _____ in _____ Ft.
 Sand _____
 Gas _____
 Oil _____
 Total Depth _____

Rig Up _____

Drilling Remarks:


PRODUCTION

1st 24 hrs. Nat. _____
 1st 24 hrs. after shot _____
 Gas _____ Cu. Ft.
 Dry Hole _____
 Abandoned _____

Map No. 11 Sec. 9 Twp. 28 R. 4
 Well No. 2 Alexander Farm
Kill River Company

NORTH

WEST

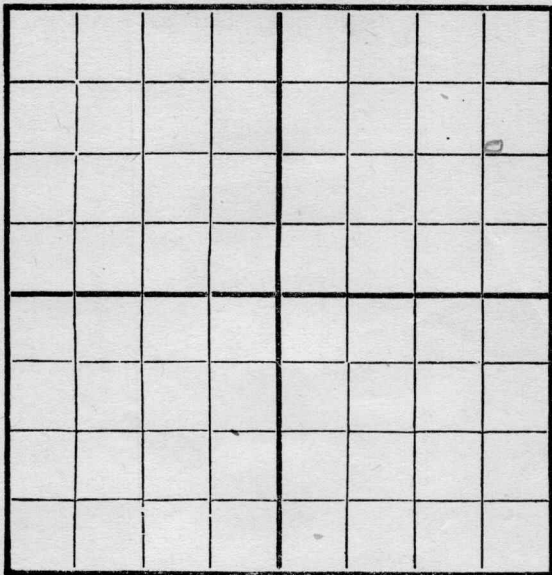

EAST

SOUTH

Location ✓

Rig Up ✓

Drilling and remarks

FIRST REPORT

150' from
South line
420' from
East line

RECORD

Cased _____ in. _____ Ft.

Sand _____

Gas _____

Oil _____

Total Depth _____

PRODUCTION

1st 24 hrs. Nat. _____

First 24 hrs. after shot _____

Gas _____ Cu. Ft.

Dry Hole _____

Abandoned _____

Date

2/20, 1917 Condit Scout


L1002

Map No. K11 Sec. 9 Twp. 28 R. 4

Well No. 2 Alexander Farm

W. J. Ray Company

NORTH

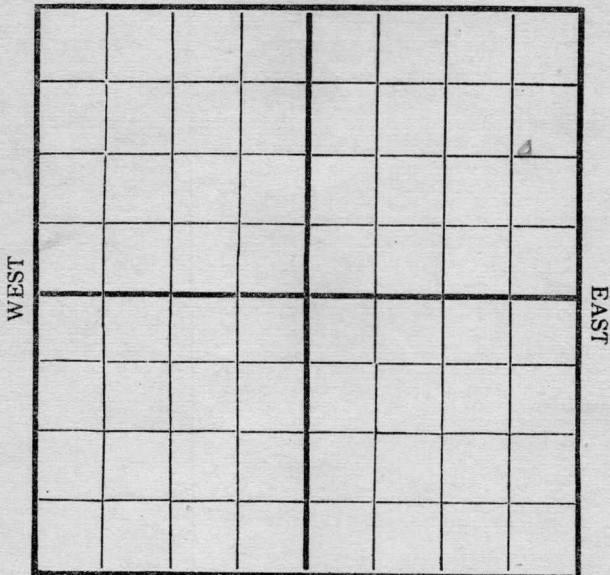

SOUTH

REMARKS:

Spreading

Date

3-5-7, 1917


Card

Scout

Map No. _____ Sec. 9 Twp. 28 R. 4
 Well No. 2 _____ Farm _____
Katy Ref _____ Company _____

NORTH

WEST

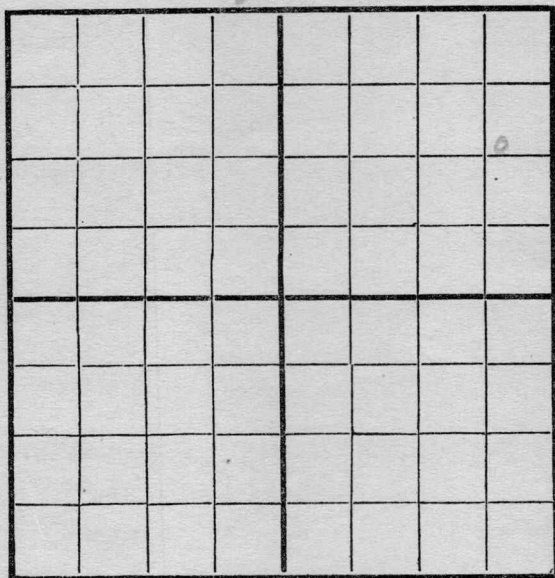

EAST

SOUTH

Location _____
 Rig Up _____
 Drilling and remarks _____

690'

RECORD

Cased _____ in. _____ Ft.
 Sand _____
 Gas _____
 Oil _____
 Total Depth _____

PRODUCTION

1st 24 hrs. Nat. _____
 1st 24 hrs. after shot _____
 Gas _____ Cu. Ft.
 Dry Hole _____
 Abandoned _____

Date

3/12, 1912 C. E. Jeff Scout

Map No. _____ Sec. 9 Twp. 28 R. 4
 Well No. 2366-10-10 Farm _____
National Ref Company _____

NORTH

WEST

EAST

SOUTH

Location _____

Rig Up _____

Drilling and remarks

1380

RECORD

Cased _____ in. _____ Ft.

Sand _____

Gas _____

Oil _____

Total Depth _____

PRODUCTION

1st 24 hrs. Nat. _____

1st 24 hrs. after shot _____

Gas _____ Cu. Ft.

Dry Hole _____

Abandoned _____

Date

3/20


191

7Candiff

Scout

Map No. _____ Sec. 9 Twp. 28 R. 4
 Well No. 2 Alexander Farm _____
National Ref Company _____

NORTH

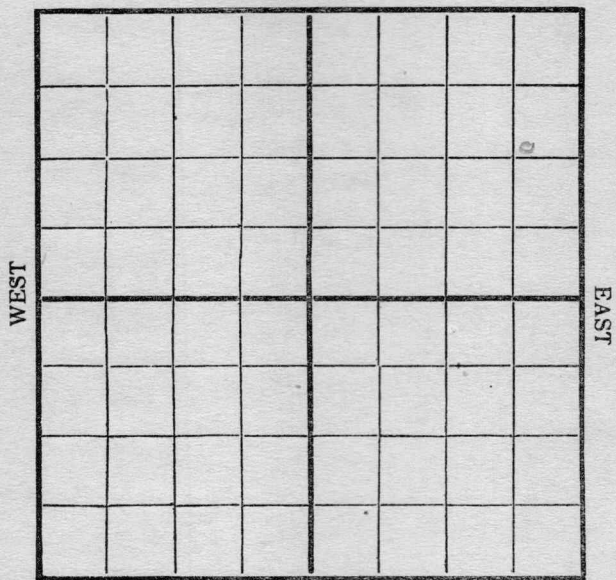

SOUTH

Location _____
 Rig Up _____
 Drilling and remarks

1590

RECORD

Cased _____ in. _____ Ft.
 Sand _____
 Gas _____
 Oil _____
 Total Depth _____

PRODUCTION

1st 24 hrs. Nat. _____
 1st 24 hrs. after shot _____
 Gas _____ Cu. Ft.
 Dry Hole _____
 Abandoned _____


Date 3/26 1917 Cordiff Scout

Map No. _____ Sec. 9 Twp. 38 R. 4
 Well No. 2 Alexander Farm
National Ref Company

NORTH

WEST

EAST

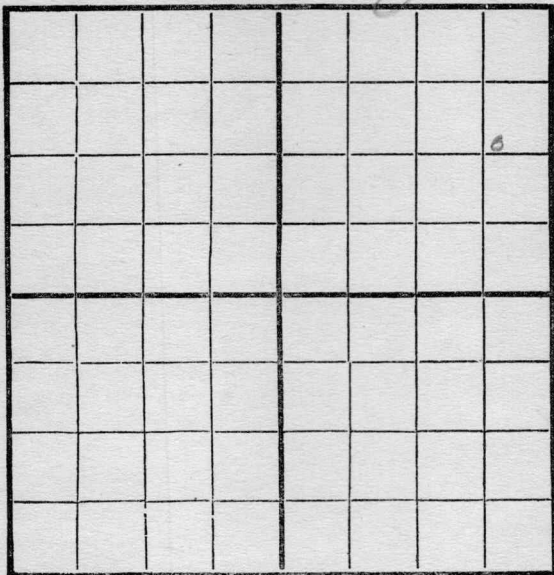

SOUTH

Location _____
 Rig Up _____
 Drilling and remarks

1860'

RECORD

Cased _____ in. _____ Ft.
 Sand _____
 Gas _____
 Oil _____
 Total Depth _____

PRODUCTION


1st 24 hrs. Nat. _____
 First 24 hrs. after shot _____
 Gas _____ Cu. Ft.
 Dry Hole _____
 Abandoned _____

Date

4/4, 1917 C. C. Cady Scout

Map No. _____ Sec. 9 Twp. 28 R. 4Well No. 2 Alexander Farm _____National Ref. Company _____

NORTH

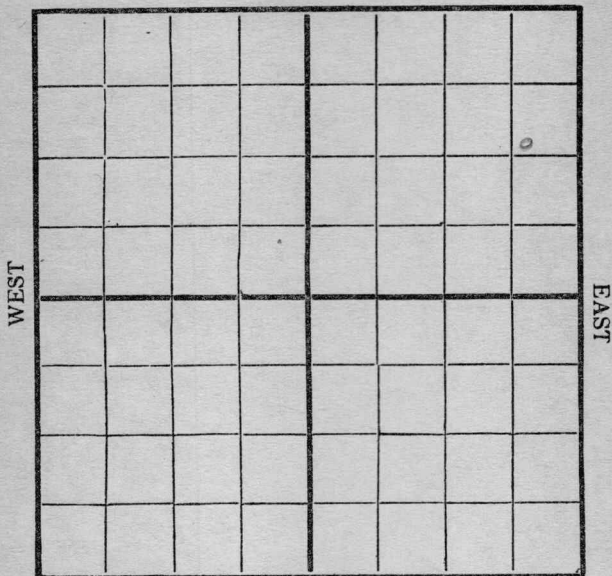

SOUTH

Location _____

Rig Up _____

Drilling and remarks

2275'

RECORD

Cased _____ in. _____ Ft.

Sand _____

Gas _____

Oil _____

Total Depth _____

PRODUCTION

1st 24 hrs. Nat. _____

1st 24 hrs. after shot _____

Gas _____ Cu. Ft.

Dry Hole _____

Abandoned _____

Date


4/10, 1917 Cordell Scout _____

Map No. _____ Sec. 9 Twp. 28 R. 4
 Well No. 2 Alexander Farm _____
Northwind Key Company _____

NORTH

WEST

EAST

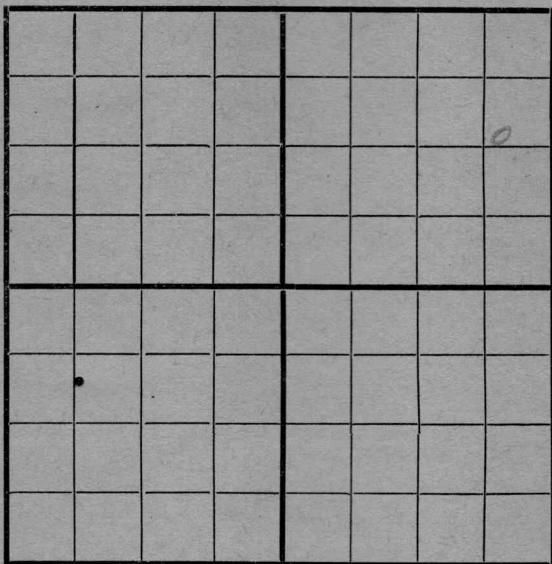

SOUTH

Location _____

Rig Up _____

Drilling and remarks

2510'

RECORD

Cased _____ in. _____ Ft.

Sand _____

Gas _____

Oil _____

Total Depth _____

PRODUCTION

1st 24 hrs. Nat. _____

1st 24 hrs. after shot _____

Gas _____ Cu. Ft.

Dry Hole _____

Abandoned _____


Date

4/17, 1917Condy Scout

Map No. _____ Sec. 7 Twp. 28 R. 4Well No. 2011 Farm _____National Ry Company _____

NORTH

WEST

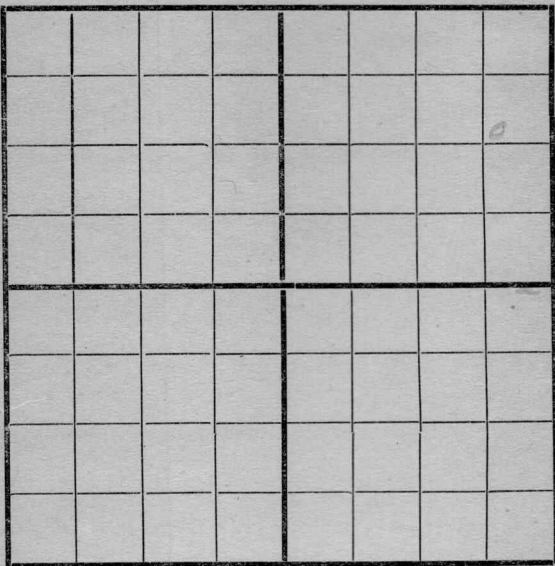

EAST

SOUTH

Location _____

Rig Up _____

Drilling and remarks

Tap sand
2.603

RECORD

Cased _____ in. _____ Ft.

Sand _____

Gas _____

Oil _____

Total Depth _____

PRODUCTION

1st 24 hrs. Nat. _____

1st 24 hrs. after shot _____

Gas _____ Cu. Ft.

Dry Hole _____


Abandoned _____

Date

4/24 191 7 Carney Scout

Map No. _____ Sec. 9 Twp. 28 R 4
 Well No. 2 Alexander Farm _____
National Ref Company _____

NORTH

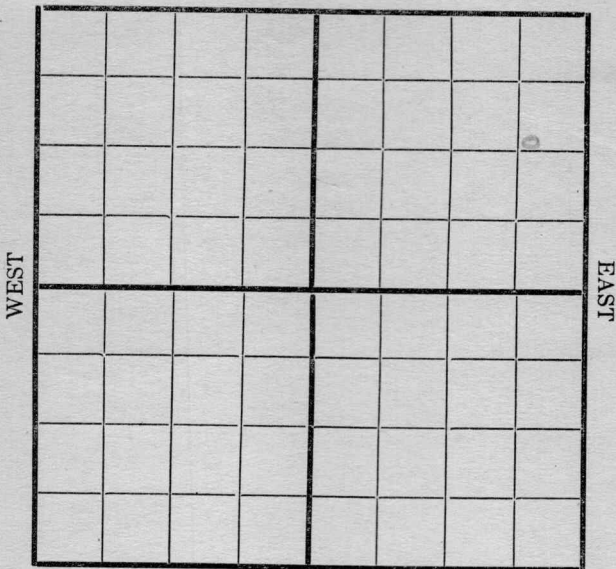

SOUTH

Location _____
 Rig Up _____
 Drilling and remarks _____

Top sand
2603
Drilling
2643

RECORD

Cased _____ in. _____ Ft.
 Sand _____
 Gas _____
 Oil _____
 Total Depth _____

PRODUCTION

1st 24 hrs. Nat. _____
 1st 24 hrs. after shot _____
 Gas _____ Cu. Ft.
 Dry Hole _____
 Abandoned _____

Date _____

5/2, 1912 2 Scout

Map No. _____ Sec. 9 Twp. 28 R. 9

Well No. 2 Allison Ave. Farm

National Ref Company

NORTH

WEST

EAST

SOUTH

Location _____

Rig Up.....

Drilling and remarks

RECORD

Cased-----in. -----Ft.

Sand_____

Gas _____

Oil

Total Depth_____

PRODUCTION

1st 24 hrs. Nat.

1st 24 hrs. after shot-----

Gas _____ Cu. Ft.

Dry Hole_____

Abandoned-----

Date _____

578, 1917. Carl Scout

MAP NO. K11 KANSAS SEC. 9 TWP. 28S R. ✓E

WELL NO. 2 Alexander

Nat'l Ref. COMPANY

CONTRACTOR

SECTION PLAT

ABANDONED

			10

_____ FT. FROM N. LINE

_____ FT. FROM S. LINE

_____ FT. FROM E. LINE

_____ FT. FROM W. LINE

RECORD

LOCATION _____

CASED _____ IN. _____ FT.

RIG UP _____

SAND _____

DRILLING AND REMARKS:

GAS _____

OIL _____

TOTAL DEPTH 2706

PRODUCTION

1ST 24 HRS. NAT. _____

1ST 24 HRS. AFTER SHOT _____

GAS _____ Cu. Ft.

DRY HOLE ☒

ABANDONED ☒

DATE

5-8-17 192 _____ SCOUT