


Map No. _____ Sec. 9 Twp. 28 R. 4Well No. 7 Denton Farm
Leonard Company

NORTH

WEST

EAST

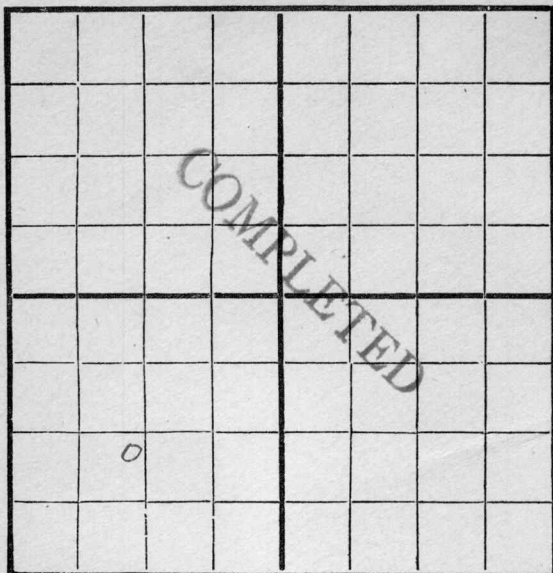

SOUTH

Location _____

Rig Up _____

Drilling Remarks:

Drilling Remarks:

3/28 Rigging up725 Completed350 bbl.

RECORD

Cased _____ in _____ Ft.

Sand _____

Gas _____

Oil _____

Total Depth _____

PRODUCTION

1st 24 hrs. Nat. _____

1st 24 hrs. after shot _____

Gas _____ Cu. Ft.

Dry Hole _____


Abandoned _____

Map No. _____ Sec. 9 Twp. 28 R. 4
 Well No. 7 Danton Farm _____
Leonard et al Company _____

NORTH

WEST

EAST

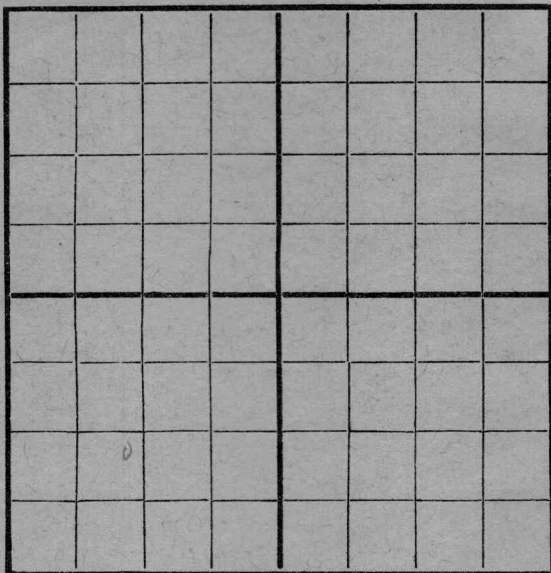

SOUTH

Location _____
 Rig Up _____
 Drilling and remarks _____

Rigging up

RECORD

Cased _____ in. _____ Ft.
 Sand _____
 Gas _____
 Oil _____
 Total Depth _____

PRODUCTION

1st 24 hrs. Nat. _____
 1st 24 hrs. after shot _____
 Gas _____ Cu. Ft.
 Dry Hole _____
 Abandoned _____

Date

5/28, 1916 Leonard et al Scout

Map No. _____ Sec. 9 Twp. 28 R. 4Well No. 7 Denton Farm _____Company Leonard et al

NORTH

WEST

EAST

SOUTH

Location _____

Rig Up _____

Drilling and remarks

350'

RECORD

Cased _____ in. _____ Ft.

Sand _____

Gas _____

Oil _____

Total Depth _____

PRODUCTION

1st 24 hrs. Nat. _____

1st 24 hrs. after shot _____

Gas _____ Cu. Ft.

Dry Hole _____

Abandoned _____

Date

6/7

191

Leonard et al


Scout

Map No. _____ Sec. 9 Twp. 28 R. 4Well No. 7 D. Leonard Farm _____
Leonard et al Company _____

NORTH

WEST

EAST

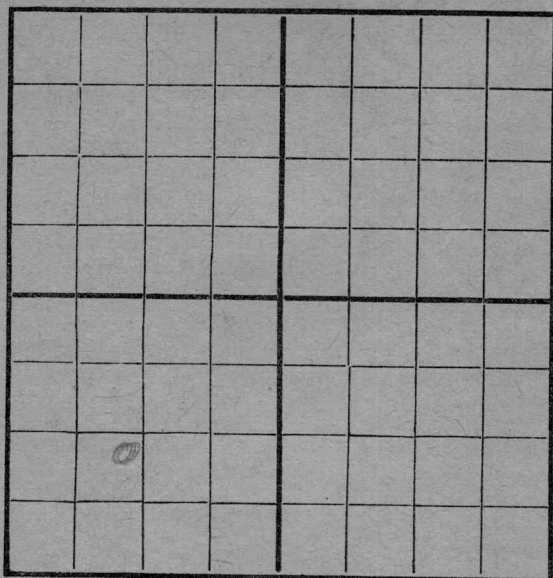

SOUTH

Location _____

Rig Up _____

Drilling and remarks

1680'

RECORD

Cased _____ in. _____ Ft.

Sand _____

Gas _____

Oil _____

Total Depth _____

PRODUCTION

1st 24 hrs. Nat. _____

1st 24 hrs. after shot _____

Gas _____ Cu. Ft.

Dry Hole _____

Abandoned _____

Date


6/30, 1916Leonard Scout

Map No. _____ Sec. 9 Twp. 28 R. 4
 Well No. 7 Denton Farm _____
LC & Hume Company _____

NORTH

WEST

EAST

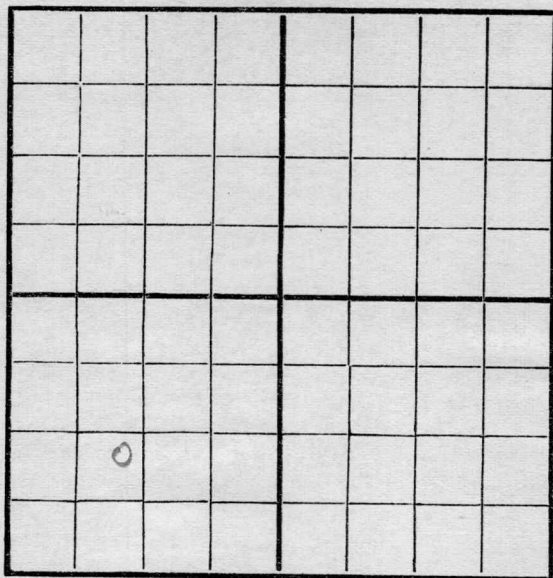

SOUTH

Location _____
 Rig Up _____
 Drilling and remarks _____

2230

RECORD

Cased _____ in. _____ Ft.
 Sand _____
 Gas _____
 Oil _____
 Total Depth _____

PRODUCTION

1st 24 hrs. Nat. _____
 1st 24 hrs. after shot _____
 Gas _____ Cu. Ft.
 Dry Hole _____
 Abandoned _____

Date

7/12

191


Scout

Map No. _____ Sec. 9 Twp. 28 R. 4
 Well No. 7 Drinton Farm _____
L. C. & Haines Company _____

NORTH

WEST

EAST

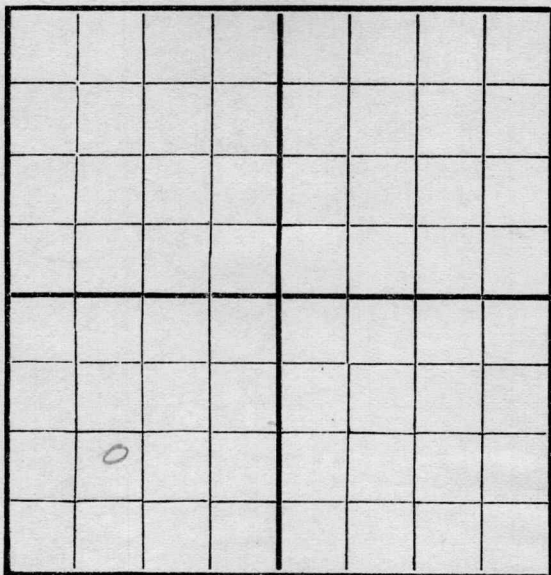

SOUTH

Location _____
 Rig Up _____
 Drilling and remarks _____

*2490-2498
 showing for 9
 big well*

RECORD

Cased _____ in. _____ Ft.
 Sand _____
 Gas _____
 Oil _____
 Total Depth _____

PRODUCTION

1st 24 hrs. Nat. _____
 1st 24 hrs. after shot _____
 Gas _____ Cu. Ft.
 Dry Hole _____
 Abandoned _____

Date


7/21, 1916 Stoney Scout _____

Map No. _____ Sec. 9 Twp. 28 R. 4
 Well No. 7 Denton Farm _____
Leander et al Company _____

NORTH

WEST

EAST

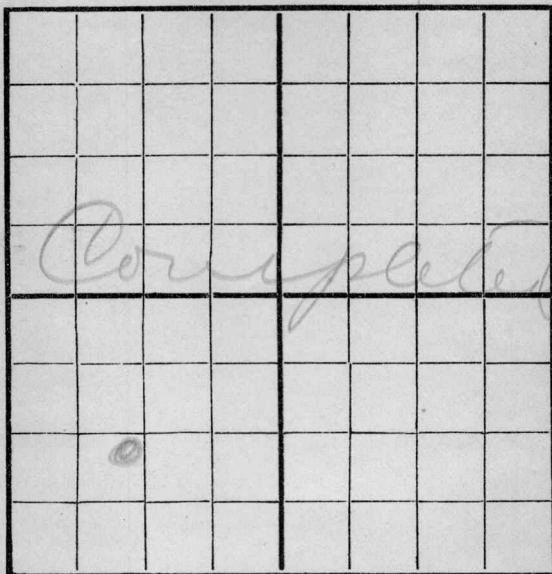

SOUTH

Location _____

Rig Up _____

Drilling and remarks

350 fll

RECORD

Cased _____ in. _____ Ft.

Sand 2490-2518

Gas _____

Oil _____

Total Depth _____

PRODUCTION

1st 24 hrs. Nat. _____

1st 24 hrs. after shot _____

Gas _____ Cu. Ft.

Dry Hole _____

Abandoned _____

Date

7/25, 1916 Leander et al Scout