


Map No. _____ Sec. 9 Twp. 28 R. 4Well No. 15 Denton Farm _____Leonard et al Company _____

NORTH

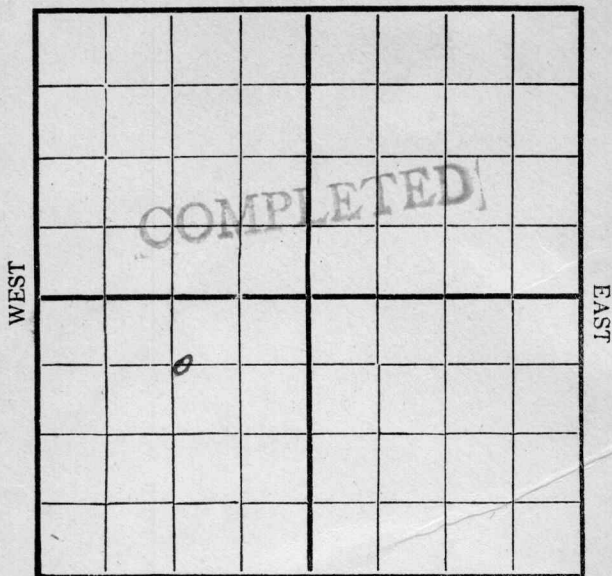

SOUTH

Location _____

Rig Up _____

Drilling Remarks:

Drilling Remarks:

RECORD

PRODUCTION

Cased _____ in _____ Ft.

1st 24 hrs. Nat _____

Sand _____

1st 24 hrs. after shot _____

Gas _____

Gas _____ Cu. Ft.

Oil _____


Dry Hole _____

Total Depth _____

Abandoned _____

Map No. _____ Sec. 9 Twp. 28 R. 4
 Well No 152 section Farm _____
Leonard et al Company

NORTH

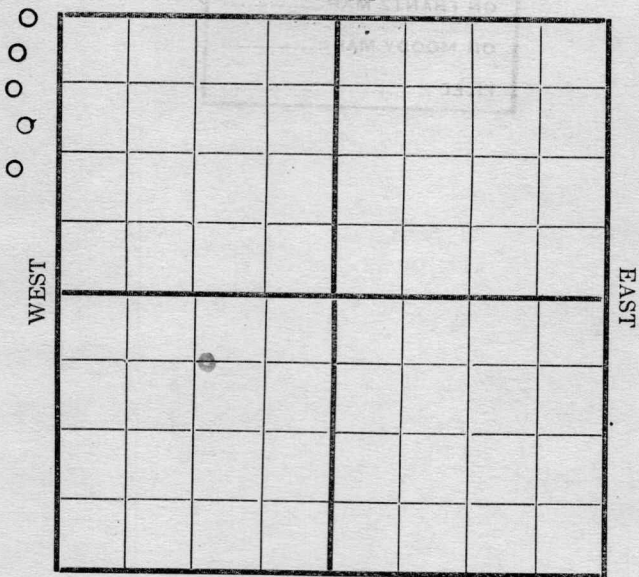

SOUTH

Location _____
 Rig Up ☒
 Drilling and remarks _____

First Report**RECORD**

Cased _____ in. _____ Ft.
 Sand _____
 Gas _____
 Oil _____
 Total Depth _____

PRODUCTION

1st 24 hrs. Nat. _____
 1st 24 hrs. after shot _____
 Gas _____ Cu. Ft.
 Dry Hole _____
 Abandoned _____

Date 5/2, 1917 Carly Scout

Map No. _____ Sec. 9 Twp. 28 R. 4
 Well No. 15 Denton Farm _____
Leonard et al Company _____

NORTH

WEST

EAST

SOUTH

Location _____
 Rig Up ☒ _____
 Drilling and remarks _____

RECORD

Cased _____ in. _____ Ft.
 Sand _____
 Gas _____
 Oil _____
 Total Depth _____


PRODUCTION

1st 24 hrs. Nat. _____
 1st 24 hrs. after shot _____
 Gas _____ Cu. Ft.
 Dry Hole _____
 Abandoned _____

Date 5/8, 1917 Conduff Scout

Map No. _____ Sec. 9 Twp. 28 R. 4
Well No. 15 Denton Farm _____
Leonard et al Company _____

NORTH

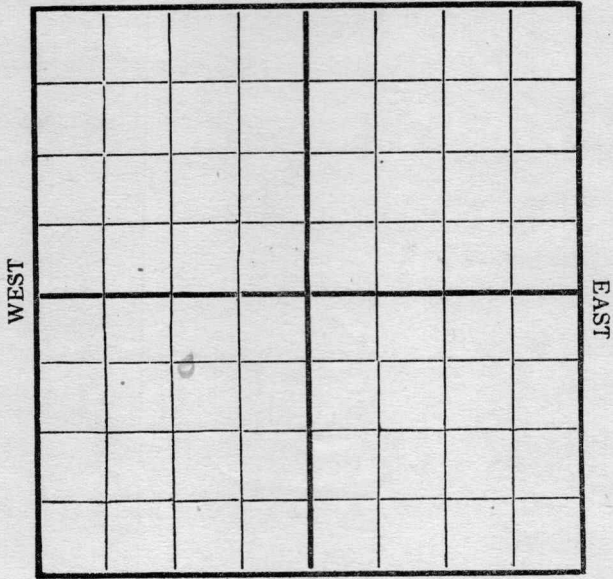

SOUTH

Location _____
Rig Up _____
Drilling and remarks
250'

RECORD

Cased _____ in. _____ Ft.
Sand _____
Gas _____
Oil _____
Total Depth _____


PRODUCTION

1st 24 hrs. Nat. _____
1st 24 hrs. after shot _____
Gas _____ Cu. Ft.
Dry Hole _____
Abandoned _____

Date 5/25, 1917 Carley Scout

Map No. _____ Sec. 9 Twp. 28 R. 4
 Well No. 15 Denton Farm _____
Leonard et al Company

NORTH

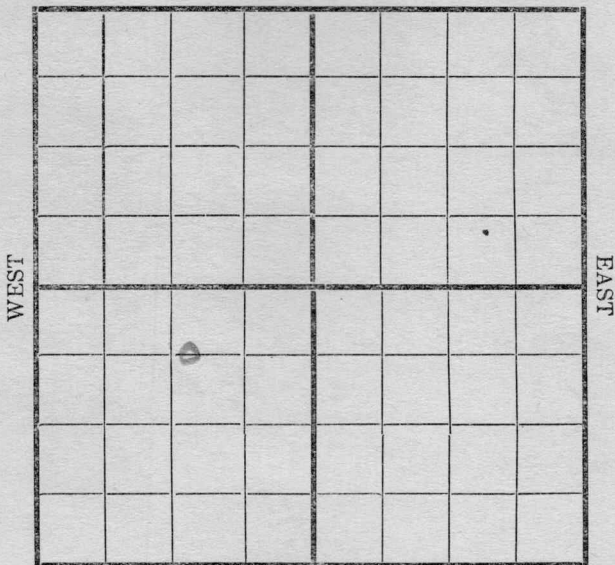

SOUTH


Location _____ Rig Up _____ Drilling and remarks _____ <u>400</u>	RECORD
	Cased _____ in. _____ Ft.
	Sand _____
	Gas _____
	Oil _____
	Total Depth _____
	PRODUCTION
	1st 24 hrs. Nat. _____
	1st 24 hrs. after shot _____
	Gas _____ Cu. Ft.
	Dry Hole _____
	Abandoned _____

Date 5/39, 191 7 Conley Scout

Map No. _____ Sec. 9 Twp. 28 R. 4Well No. 152 _____ Farm _____Leander et al _____ Company _____

NORTH

WEST

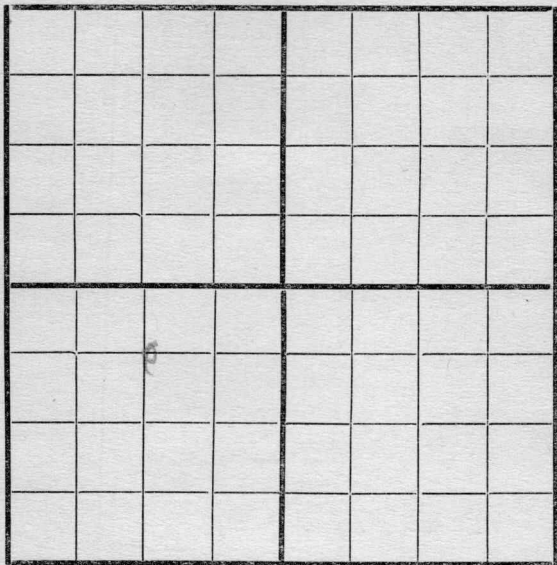

EAST

SOUTH

Location _____

Rig Up _____

Drilling and remarks

580

RECORD

Cased _____ in. _____ Ft.

Sand _____

Gas _____

Oil _____

Total Depth _____

PRODUCTION

1st 24 hrs. Nat. _____

1st 24 hrs. after shot _____

Gas _____ Cu. Ft.

Dry Hole _____

Abandoned _____


Date

6/8, 1917 Carley Scout

Map No. _____ Sec. 9 Twp. 28 R. 4
 Well No. 152-Denton Farm _____
Leander et al Company _____

NORTH

WEST

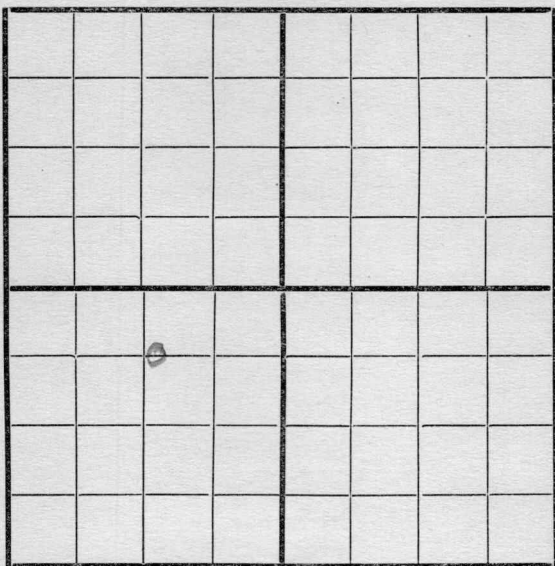

EAST

SOUTH

Location _____

Rig Up _____

Drilling and remarks

620

RECORD

Cased _____ in. _____ Ft.

Sand _____

Gas _____

Oil _____

Total Depth _____

PRODUCTION

1st 24 hrs. Nat. _____

1st 24 hrs. after shot _____

Gas _____ Cu. Ft.

Dry Hole _____


Abandoned _____

Date

6/12, 1917 Leander et al Scout

Map No. _____ Sec. 9 Twp. 28 R. 4Well No. 15 Denton Farm _____Leominster Company _____

NORTH

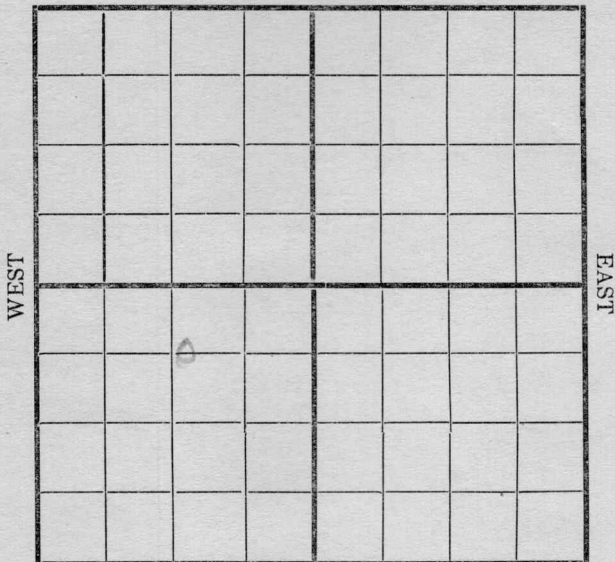

SOUTH

Location _____

Rig Up _____

Drilling and remarks

1230

RECORD

Cased _____ in. _____ Ft.

Sand _____

Gas _____

Oil _____

Total Depth _____

PRODUCTION

1st 24 hrs. Nat. _____

1st 24 hrs. after shot _____

Gas _____ Cu. Ft.

Dry Hole _____


Abandoned _____

Date

6/20, 1911 D. Conroy Scout

Map No. _____ Sec. 9 Twp. 28 R. 4
 Well No. 15 Denton Farm _____
Levinson et al Company _____

NORTH

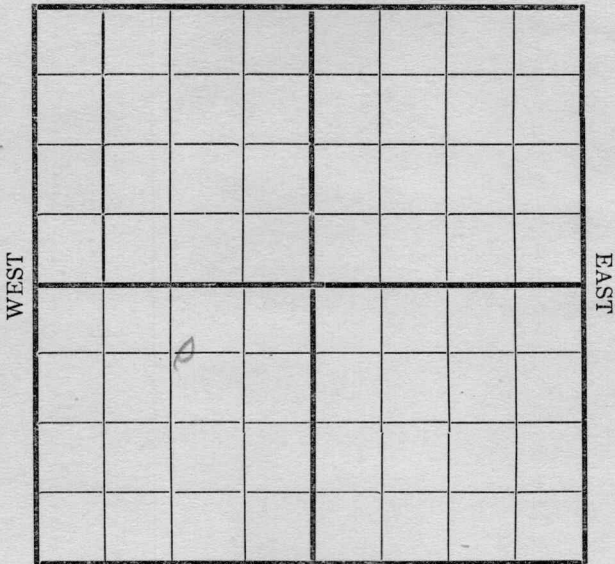

SOUTH

Location _____
 Rig Up _____
 Drilling and remarks _____

1400

RECORD

Cased _____ in. _____ Ft.
 Sand _____
 Gas _____
 Oil _____
 Total Depth _____

PRODUCTION


1st 24 hrs. Nat. _____
 1st 24 hrs. after shot _____
 Gas _____ Cu. Ft.
 Dry Hole _____
 Abandoned _____

Date 6/27 1917 Cardiff Scout

Map No. _____ Sec. 9 Twp. 28 R. 4Well No. 15 Denton Farm _____Leiman et al Company _____

NORTH

WEST

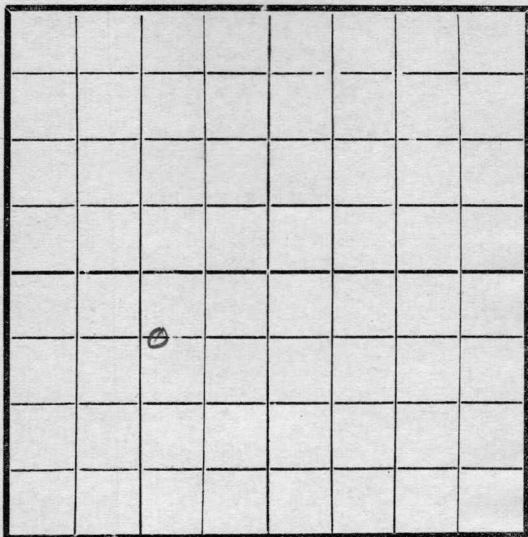

SOUTH

Location _____

Rig Up _____

Drilling and remarks

*Shut Down
at 1400*

RECORD

Cased _____ in. _____ Ft.

Sand _____

Gas _____

Oil _____

Total Depth _____

PRODUCTION

1st 24 hrs. Nat. _____

1st 24 hrs. after shot _____

Gas _____ Cu. Ft.

Dry Hole _____

Abandoned _____


Date

7/6, 191 *7* _____ Scout

Map No. _____ Sec. 9 Twp. 28 R. 4Well No. 15 Denton Farm
Leonard & Co. Company

NORTH

WEST

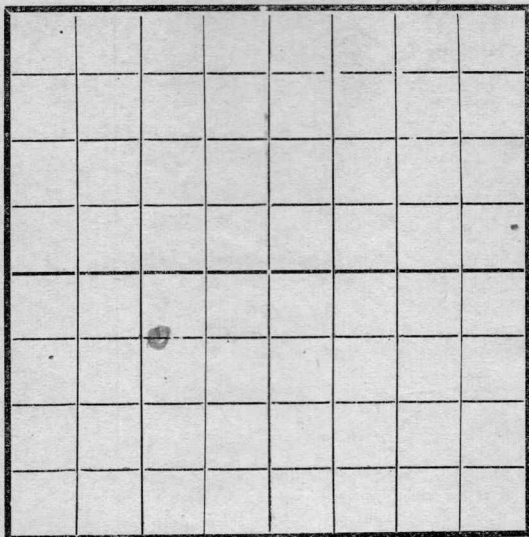

EAST

SOUTH

Location _____

Rig Up _____

Drilling and remarks

1908

RECORD

Cased _____ in. _____ Ft.

Sand _____

Gas _____

Oil _____

Total Depth _____

PRODUCTION

1st 24 hrs. Nat. _____

1st 24 hrs. after shot _____

Gas _____ Cu. Ft.

Dry Hole _____

Abandoned _____


Date

7/27, 1917 Carroll Scout

Map No. _____ Sec. 9 Twp. 28 R. 4Well No. 15. Denton Farm
Leonard et al Company

NORTH

WEST

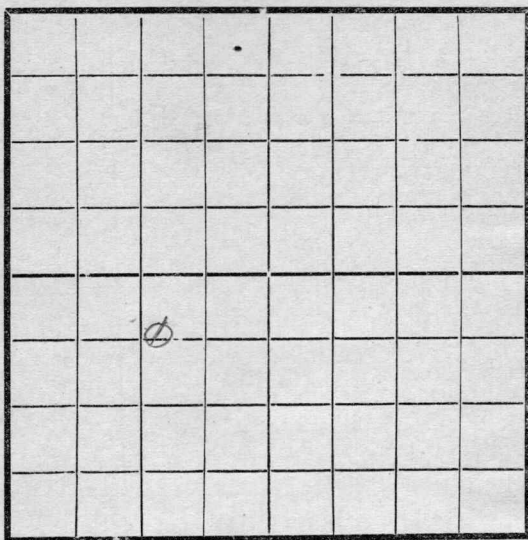

EAST

SOUTH

Location _____

Rig Up _____

Drilling and remarks

Setting 5"
at 2375

RECORD

Cased _____ in. _____ Ft.

Sand _____

Gas _____

Oil _____

Total Depth _____

PRODUCTION

1st 24 hrs. Nat. _____

1st 24 hrs. after shot _____

Gas _____ Cu. Ft.

Dry Hole _____

Abandoned _____

Date

8-20, 1917

Lantz Scout

Form S-101—2-21-17—100 Books of 100 Sheets.


Map No. _____ Sec. 9, Twp. 28, R. 4

Well No. 15 Denton

Leonard et al Company

NORTH

WEST

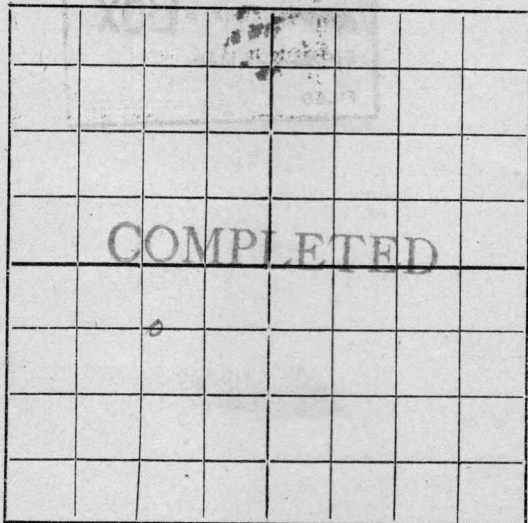

EAST

SOUTH

Location _____

Rig up _____

Drilling and remarks:

*making
500 Bbls
natural*

RECORD

Cased _____ in., _____ Ft.

Sand 2490 - 2501

Gas _____

Oil _____

Total Depth _____

PRODUCTION

1st 24 hrs. Nat. _____

1st 24 hrs. after shot _____

Gas _____ Cu. ft.

Dry Hole _____

Abandoned _____

Date

9/5 1917 Condy Scout