


1002

Form 51-12-17-5M-Mid-West.

Map No. K-11 Sec. 9 Twp. 28 R. 4Well No. 17 Denton Farm
Leonard et al Company

NORTH

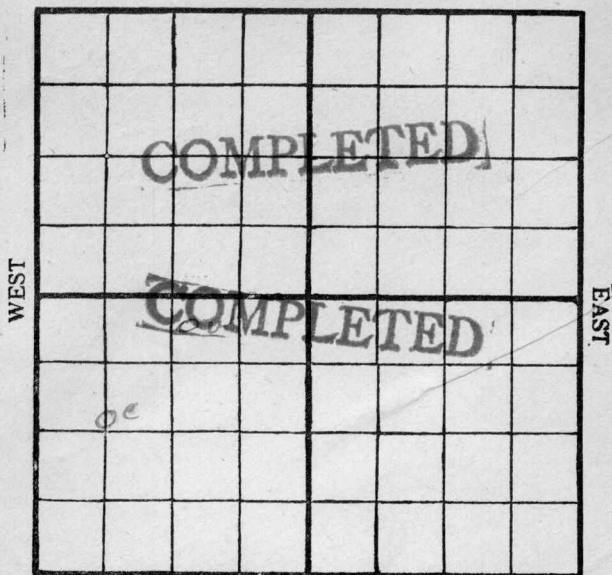

SOUTH

Location -----

Rig Up -----

Drilling Remarks:

Drilling Remarks:

RECORD

Cased ----- in. ----- ft.

Sand -----

Gas -----

Oil -----

Total Depth -----

PRODUCTION

1st 24 hrs. Nat. -----

1st 24 hrs. after shot -----

Gas ----- cu. ft.

Dry Hole -----

Abandoned -----

100v
Map No. 111 Sec. 9 Twp. 28 R. 4


Well No. 172 Denton

Leander et al. Company

Contractor

NORTH

WEST

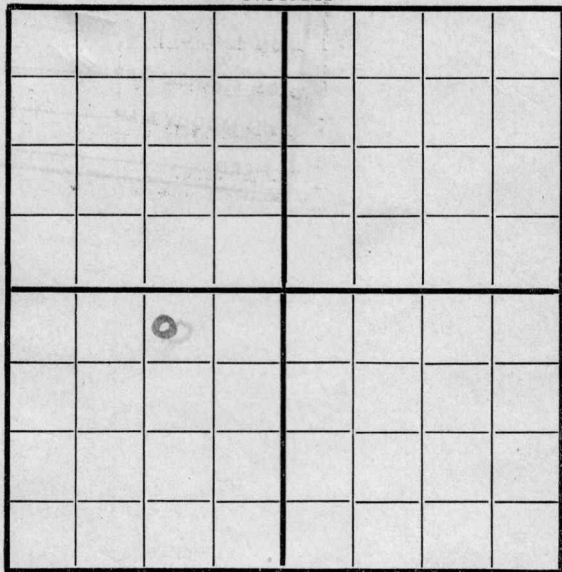

EAST

SOUTH

Location _____

Rig up _____

Drilling and Remarks:

RECORD

Cased _____ in., _____ ft.

Sand _____

Gas _____

Oil _____

Total Depth _____

PRODUCTION

1st 24 hrs. Nat. _____

1st 24 hrs. after shot _____

Gas _____ Cu. Ft.

Dry Hole _____

Abandoned _____

FIRST REPORT

Date

7/26/18 Condy Scout


1002411
Map No. 111 Sec. 9 Twp. 28 R. 4

Well No. 17 Denton

Leonard et al Company

P. W. Pine Drilling Co. Contractor

Augusta NORTH Kb

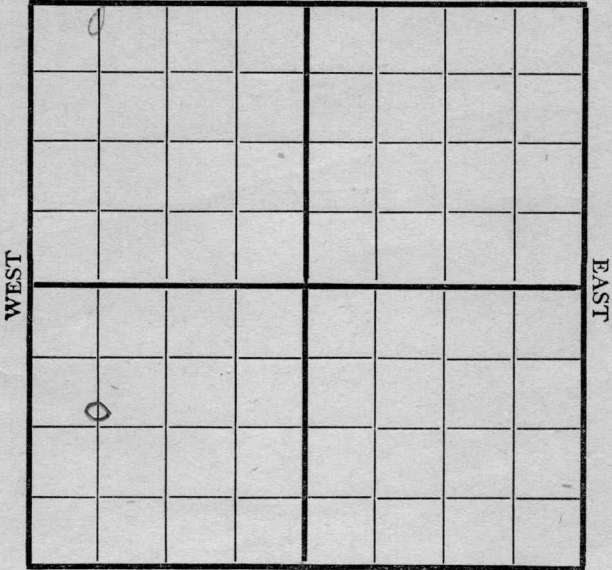

SOUTH

117051-660 W

Location _____

Rig up _____

Drilling and Remarks:

280

FIRST REPORT

RECORD

Cased _____ in., _____ ft.

Sand _____

Gas _____

Oil _____

Total Depth _____

PRODUCTION

1st 24 hrs. Nat. _____

1st 24 hrs. after shot _____

Gas _____ Cu. Ft.

Dry Hole _____

Abandoned _____

Date

8/1

1918

Candey Scout


Map No. _____ Sec. 9 Twp. 38 R. 4Well No. 172 _____
Leander _____ Company

Contractor _____

NORTH

WEST

EAST

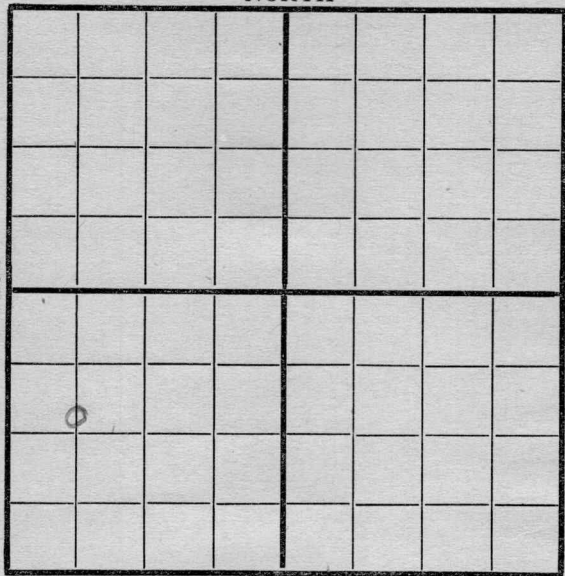

SOUTH

1120 N 660 WLocation 970

Rig up _____

Drilling and Remarks:

1150

RECORD

Cased _____ in., _____ ft.

Sand _____

Gas _____

Oil _____

Total Depth _____

PRODUCTION

1st 24 hrs. Nat. _____

1st 24 hrs. after shot _____

Gas _____ Cu. Ft.

Dry Hole _____

Abandoned _____


Date

8/7 _____ 191 _____ Scout

Map No. _____ Sec. 9 Twp. 28 R. 4Well No. 178 centerLeonard et al CompanyR. W. Pine Drill Co ContractorAugusta NORTH Ks

WEST

EAST

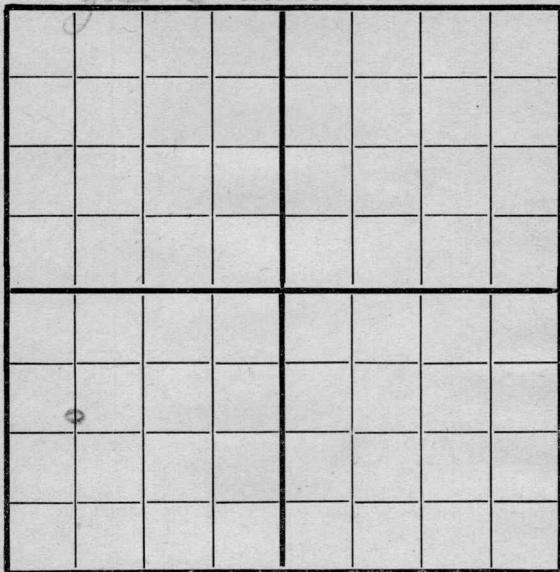

SOUTH

RECORD

Location 660 W

Cased _____ in., _____ ft.

Rig up _____

Sand _____

Drilling and Remarks:

Gas _____

Oil _____

Total Depth _____

PRODUCTION

1st 24 hrs. Nat. _____

1st 24 hrs. after shot _____

Gas _____ Cu. Ft.

Dry Hole _____

Abandoned _____

Date


8/14 1918 J. C. Candy Scout

Map No. _____ Sec. 9 Twp. 28 R. 4

Well No. 172 _____
Leander _____ Company

Contractor _____

NORTH

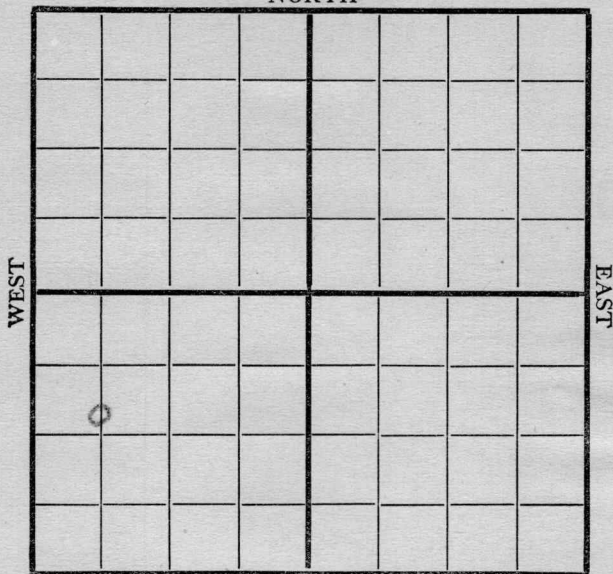

SOUTH

1120' N - 660' W

Location _____

Rig up _____

Drilling and Remarks:

1650

RECORD

Cased _____ in., _____ ft.

Sand _____

Gas _____

Oil _____

Total Depth _____

PRODUCTION

1st 24 hrs. Nat. _____

1st 24 hrs. after shot _____

Gas _____ Cu. Ft.

Dry Hole _____

Abandoned _____

Date

8/21 1918

Candy

Scout

Map No. 1511 Sec. 9 Twp. 28 R. 4

Well No. 17

Leonard et al Company

Contractor

NORTH

WEST

EAST

SOUTH

Location _____

Rig up _____

Drilling and Remarks:

RECORD

Cased _____ in., _____ ft.

Sand _____

Gas _____

Oil _____

Total Depth _____

PRODUCTION

1st 24 hrs. Nat. _____

1st 24 hrs. after shot _____

Gas _____ Cu. Ft.

Dry Hole _____

Abandoned _____

Date

8/28 1918 Carley Scout


Map No. 1511 Sec. 9 Twp. 28 R. 4Well No. 17 Denton
Levinson et al Company

Contractor

NORTH

WEST

EAST

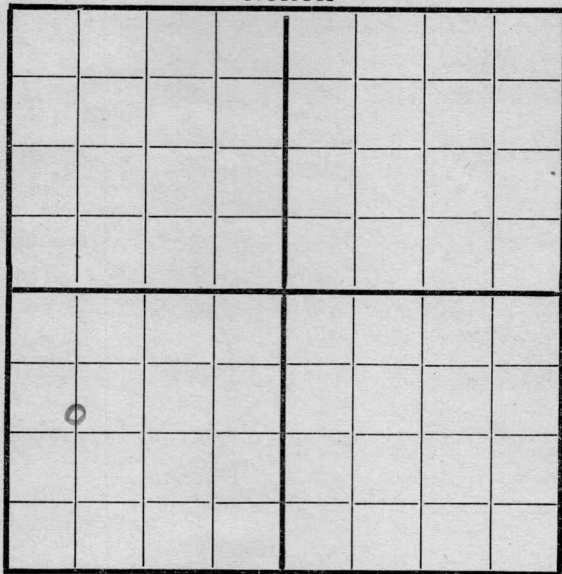

SOUTH

1120x660W

Location _____

Rig up _____

Drilling and Remarks:

WR
2491

RECORD

Cased _____ in., _____ ft.

Sand _____

Gas _____

Oil _____

Total Depth _____

PRODUCTION

1st 24 hrs. Nat. _____

1st 24 hrs. after shot _____

Gas _____ Cu. Ft.

Dry Hole _____

Abandoned _____

Date

9/2 1918 C. Condy Scout

Map No. 511 Sec. 9 Twp. 28 R. 4Well No. 17 DentonLeonard et al Company

Contractor

NORTH

WEST

EAST

SOUTH

660 W 1120 N

Location _____

Rig up _____

Drilling and Remarks:

T.S. sand 2487 (water)
 2497 1/2
 oil sand 2497 1/2 - 2498
 1000' oil in hole
 under running
 2487 to 2498

RECORD

Cased _____ in., _____ ft.

Sand _____

Gas _____

Oil _____

Total Depth _____

PRODUCTION

1st 24 hrs. Nat. _____

1st 24 hrs. after shot _____

Gas _____ Cu. Ft.

Dry Hole _____

Abandoned _____

Date

9/4 191 8 Conley Scout

Map No. 1511 Sec. 9 Twp. 28 R. 4Well No. 178 DentonLevensworth Company

Contractor

NORTH

WEST

EAST

COMPLETED

SOUTH

1120 X 660 W

Location _____

Rig up. ☒

Drilling and Remarks:

Est at125186e

RECORD

Cased _____ in., _____ ft.

Sand 2498-2499

Gas _____

Oil _____

Total Depth _____

PRODUCTION

1st 24 hrs. Nat. _____

1st 24 hrs. after shot _____

Gas _____ Cu. Ft.

Dry Hole _____

Abandoned _____

Date

9/30191Condy Scout