


Map No. _____ Sec. 9 Twp. 28 R. 4Well No. 69 H Benton Farm _____Lemard vital. Company _____

NORTH

WEST

EAST

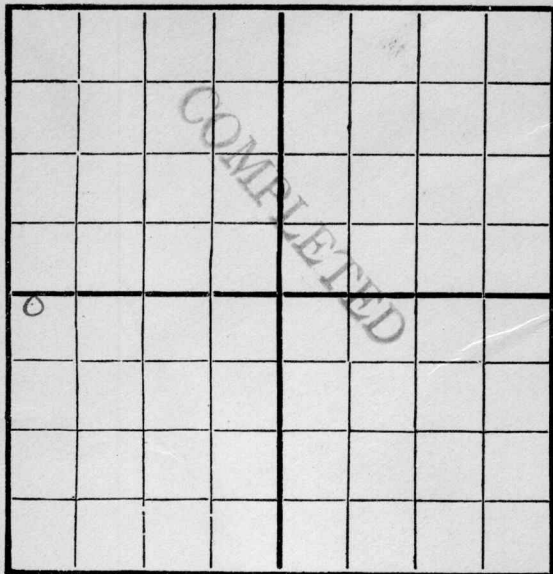

SOUTH

Location _____

Rig Up 5/2

Drilling Remarks:

Drilling Remarks:

8/1 - 2482 - 2506
1000 bbls

RECORD

Cased _____ in _____ Ft.

Sand _____

Gas _____

Oil _____

Total Depth _____

PRODUCTION

1st 24 hrs. Nat. _____

1st 24 hrs. after shot _____

Gas _____ Cu. Ft.


Dry Hole _____

Abandoned _____

Map No. _____ Sec. 9 Twp. 28 R. 4Well No. 68 W. Danton Farm _____Leeman and et al Company _____

NORTH

WEST

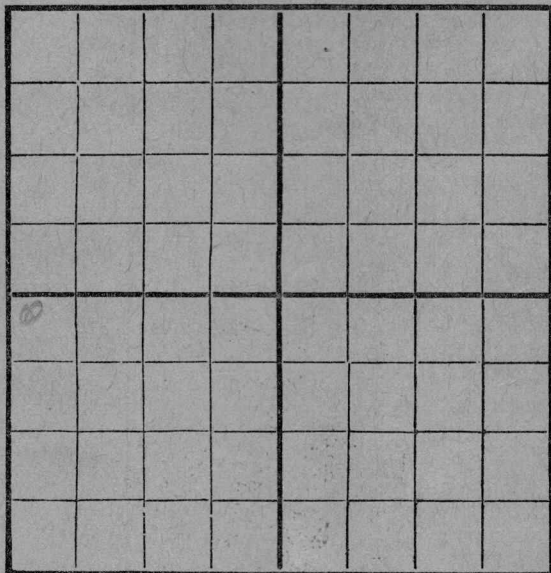

EAST

SOUTH

Location _____

Rig Up _____

Drilling and remarks _____

RECORD

Cased _____ in. _____ Ft.

Sand _____

Gas _____

Oil _____

Total Depth _____

PRODUCTION

1st 24 hrs. Nat. _____

1st 24 hrs. after shot _____

Gas _____ Cu. Ft.

Dry Hole _____

Abandoned _____


Date _____

191 6L. P. Randiff Scout

Map No. _____ Sec. 9 Twp. 28 R. 4
 Well No. 6 Denison Farm _____
Samuel et al Company _____

NORTH

WEST

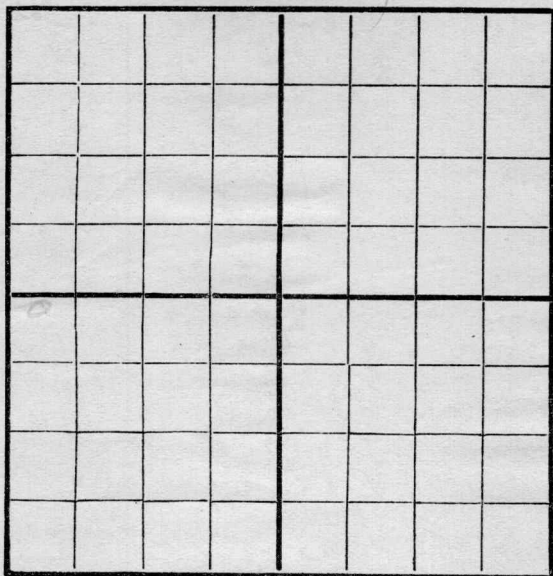

EAST

SOUTH

Location _____
 Rig Up _____
 Drilling and remarks _____

2115

RECORD

Cased _____ in. _____ Ft.
 Sand _____
 Gas _____
 Oil _____
 Total Depth _____

PRODUCTION

1st 24 hrs. Nat. _____
 1st 24 hrs. after shot _____
 Gas _____ Cu. Ft.
 Dry Hole _____
 Abandoned _____


Date

6/23, 1916 6/23/16 Scout

Map No. _____ Sec. 9 Twp. 28 R. 4Well No. 6 Denton Farm _____Leander Company _____

NORTH

WEST

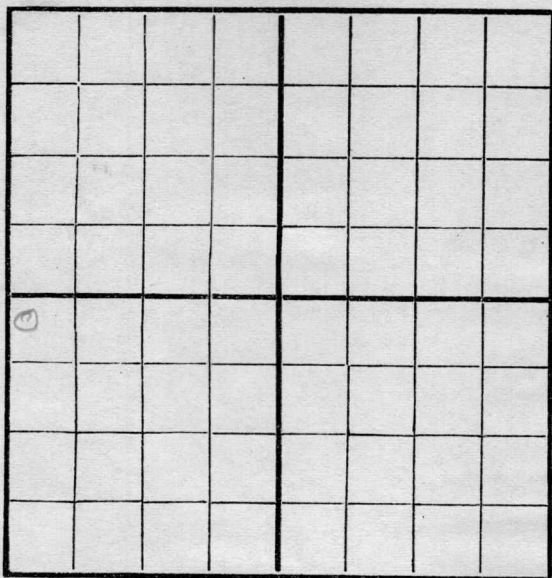

EAST

SOUTH

Location _____

Rig Up _____

Drilling and remarks

Shut Down

RECORD

Cased _____ in. _____ Ft.

Sand _____

Gas _____

Oil _____

Total Depth _____

PRODUCTION

1st 24 hrs. Nat. _____

1st 24 hrs. after shot _____

Gas _____ Cu. Ft.

Dry Hole _____

Abandoned _____


Date

6/30, 1916 L. C. Duff Scout

Map No. _____ Sec. 9 Twp. 28 R. 4
 Well No. 16 Denton Farm _____
L.O. & Haines Company _____

NORTH

WEST

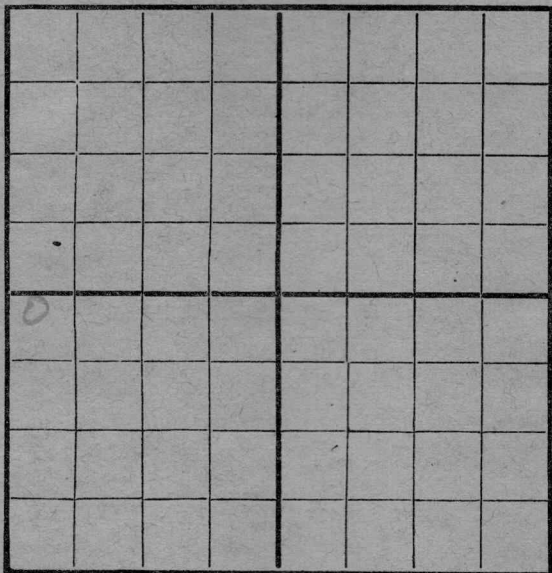

EAST

SOUTH

Location _____

Rig Up _____

Drilling and remarks

1820 -Correction

RECORD

Cased _____ in. _____ Ft.

Sand _____

Gas _____

Oil _____

Total Depth _____

PRODUCTION

1st 24 hrs. Nat. _____

1st 24 hrs. after shot _____

Gas _____ Cu. Ft.

Dry Hole _____

Abandoned _____


Date

7/12, 1916 LLC & Haines Scout

Map No. _____ Sec. 9 Twp. 28 R. 4
 Well No. 6 Denton Farm _____
Lee, & Howell Company _____

NORTH

WEST

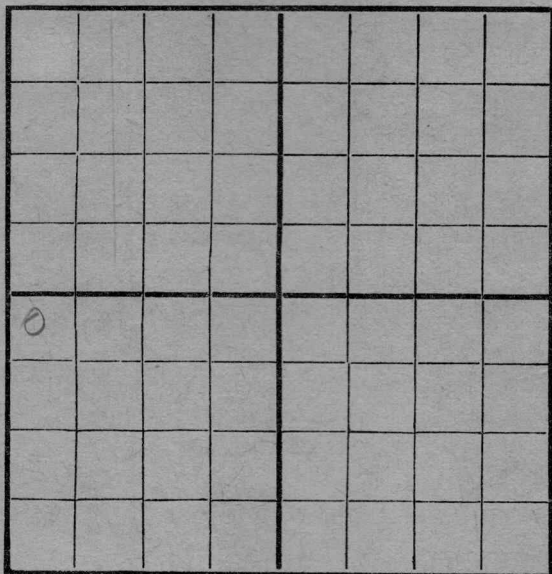

EAST

SOUTH

Location _____

Rig Up _____

Drilling and remarks

2250'

RECORD

Cased _____ in. _____ Ft.

Sand _____

Gas _____

Oil _____

Total Depth _____

PRODUCTION

1st 24 hrs. Nat. _____

1st 24 hrs. after shot _____

Gas _____ Cu. Ft.

Dry Hole _____

Abandoned _____

Date

7/21, 1916 Alford Scout

Map No. _____ Sec. 9 Twp. 28 R. 4Well No. 6 _____ Farm _____D. C. & H. H. Hume Company

NORTH

WEST

EAST

SOUTH

Location _____

Rig Up _____

Drilling and remarks

RECORD

Cased _____ in. _____ Ft.

Sand _____

Gas _____

Oil _____

Total Depth _____

PRODUCTION

1st 24 hrs. Nat. _____

1st 24 hrs. after shot _____

Gas _____ Cu. Ft.

Dry Hole _____


Abandoned _____

Date

7/25, 1911 Alfred J. Scout

Map No. _____ Sec. 9 Twp. 28 R. 4
 Well No. 6 _____ Farm _____
L. C. & H. H. Hume _____ Company _____

NORTH

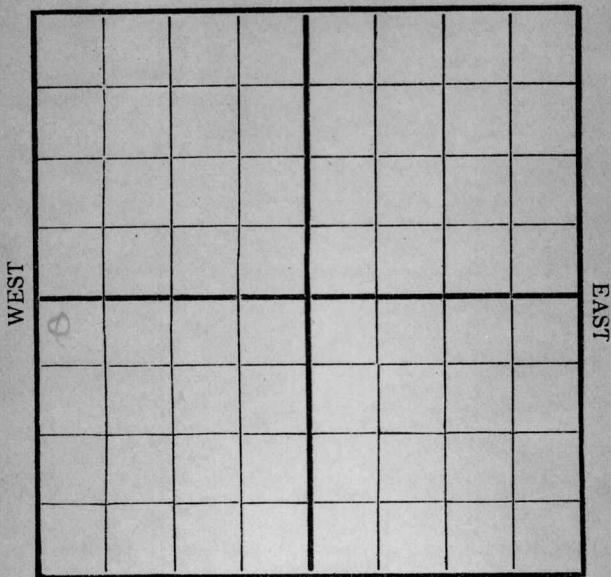

SOUTH

Location _____
 Rig Up _____
 Drilling and remarks _____

*on top sand
 24 10'*

RECORD

Cased _____ in. _____ Ft.
 Sand _____
 Gas _____
 Oil _____
 Total Depth _____

PRODUCTION

1st 24 hrs. Nat. _____
 1st 24 hrs. after shot _____
 Gas _____ Cu. Ft.
 Dry Hole _____
 Abandoned _____

Date

7/31, 1916 L. C. & H. H. Hume Scout

Map No. _____ Sec. 9 Twp. 28 R. 4


Well No. 6 Farm _____

Company _____

NORTH

WEST

EAST

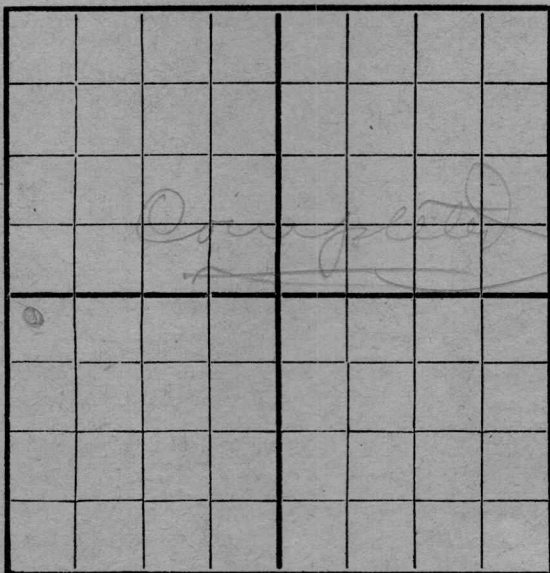

SOUTH

Location _____

Rig Up _____

Drilling and remarks

RECORD

Cased _____ in. _____ Ft.

Sand 2482-3506

Gas _____

Oil _____

Total Depth _____

PRODUCTION

1st 24 hrs. Nat. _____

1st 24 hrs. after shot _____

Gas _____ Cu. Ft.

Dry Hole _____

Abandoned _____

Date

8/1, 1916 LLC Scout

*good for
1000 bbl*