


Kansas

Map No. _____ Sec. 12 Twp. 24 R. 12
Well No. 8 Dagne Farm _____
Marshall Oil Company _____

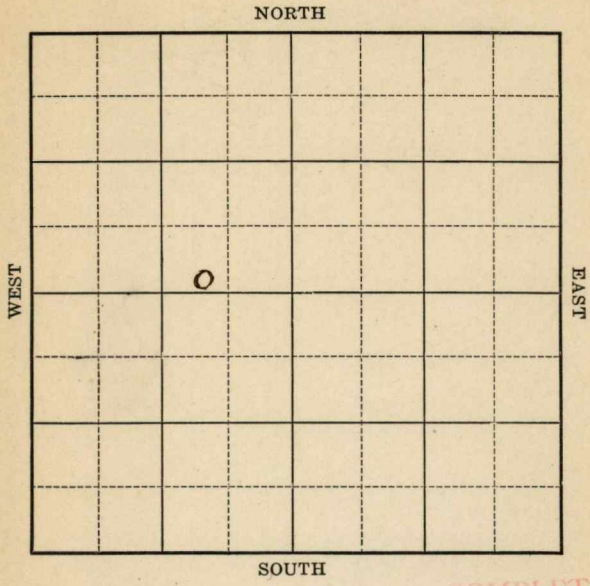

COMPLETED

Location _____
Drilling Remarks: _____

RECORD

Cased _____ in. _____ ft.
Sand _____
Gas _____
Oil _____
Total Depth _____

Rig Up _____
Drilling Remarks: _____

PRODUCTION

1st 24 hrs. Nat. _____
1st 24 hrs. after shot _____
Gas _____ cu. ft.
Dry Hole _____
Abandoned _____

Map No. _____ Sec. 12 Twp. 24 R. 12

Well No. 78 Name Home Farm


Marshall Oil Company

_____ Ft. from N. Line

200 Ft. from S. Line

800 Ft. from E. Line

_____ Ft. from W. Line

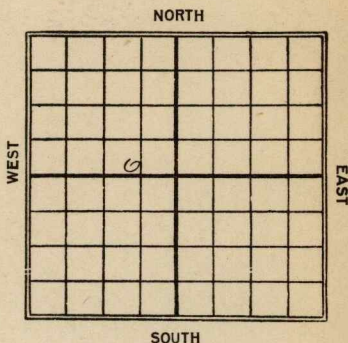

Date _____

1922

REPORT

7/2	2
-----	---

Sign up

9/16

Sand 1676-95 - Shot 30
gts. 15 Bblo.

Map No. 16 Sec. 12 Twp. 24 R. 12Well No. 8 40 ameMarshall oil Company

Contractor

FIRST REPORT

Ft. from N. Line

200 Ft. from S. Line800 Ft. from E. Line

Ft. from W. Line

SECTION PLAT

Location

Rig up

Drilling and Remarks:

Rign up

RECORD

Cased _____ in., _____ ft.

Sand _____

Gas _____

Oil _____

Total Depth _____

PRODUCTION

1st 24 hrs. Nat. _____

1st 24 hrs. after shot _____

Gas _____ Cu. Ft.

Dry Hole _____

Abandoned _____

Date

JUL 22 1922191 M. A. BENEAR Scout

Map No. **KANSAS** ¹⁶ Sec. 12 Twp. 24 R. 12Well No. 8 LeameMarshall Company

Contractor

COMPLETED SECTION PLAT

Ft. from N. Line

200 Ft. from S. Line200 Ft. from E. Line

Ft. from W. Line

	0		

Location

Rig up

Drilling and Remarks:

Sept. 16, 1921
shot 30 gals

RECORD

Cased _____ in., _____ ft.

Sand _____

Gas _____

Oil 1676-95Total Depth 1695

PRODUCTION

1st 24 hrs. Nat. _____

1st 24 hrs. after shot 13

Gas _____ Cu. Ft.

Dry Hole _____

Abandoned _____

Date

SEP 16 1922

M. A. BENEAR

_____ 191 _____

_____ Scout