


Map No. _____ Sec. 12 Twp. 24 R. 12
 Well No. 7 Dame Farm _____
Hazel Oil Company _____

NORTH

WEST

EAST

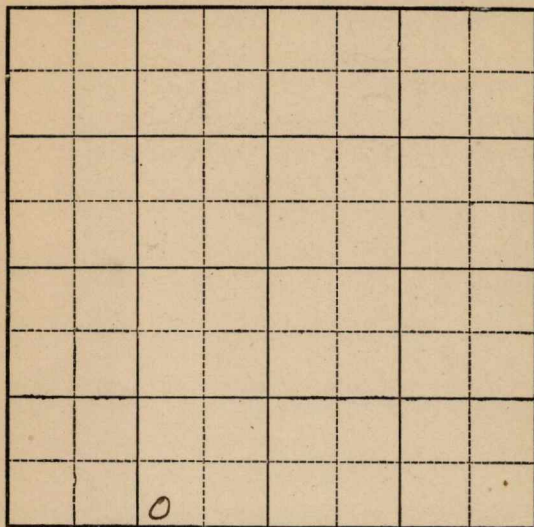

SOUTH

OK 20 40

Location _____

Drilling Remarks:

Rig up _____

Drilling Remarks:

RECORD

Cased _____ in. _____ ft.

Sand _____

Gas _____

Oil _____

Total Depth _____

PRODUCTION

1st 24 hrs Nat. _____

1st 24 hrs. after shot _____

Gas _____ cu. ft.

Dry Hole _____

Abandoned _____

Map No. _____ Sec. 12 Twp. 24 R. 12

Well No. 7 Darnie Farm _____
Hazel Oil Company _____

NORTH

_____ Ft. from N. Line


200 Ft. from S. Line

1120 Ft. from E. Line

_____ Ft. from W. Line

WEST

EAST

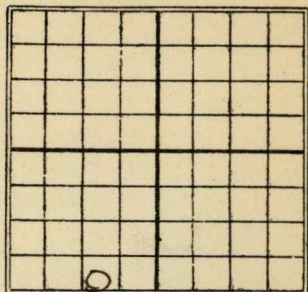

SOUTH

Date

REPORT

1923

2/24

3/22

Dr. 1000'
Pay 1695-1706 - Shot
60 gts. 20 Bbls.

Map No. **KANSAS** *16* Sec. *12* Twp. *34* R. *12*Well No. *7 Leane**Hagel* Company

Contractor

FIRST REPORT

SECTION PLAT

Ft. from N. Line

200 Ft. from S. Line*1120* Ft. from E. Line

Ft. from W. Line

*Was Gas well
but is dry. deeper*

RECORD

Location

Rig up

Drilling and Remarks:

dry 1000

Cased _____ in., _____ ft.

Sand _____

Gas _____

Oil _____

Total Depth _____

PRODUCTION

1st 24 hrs. Nat. _____

1st 24 hrs. after shot _____

Gas _____ Cu. Ft.

Dry Hole _____

Abandoned _____

Date

FEB 24 1923

M. A. BENEAR

191

Scout

Map No. **KANSAS** 16 Sec. 12 Twp. 24 R. 12

Well No. 7 Leanne

Hazel Oil Company

Gas well by Leanne Contractor

COMPLETED**SECTION PLAT**

	0		

Ft. from N. Line

200' Ft. from S. Line

1120' Ft. from E. Line

Ft. from W. Line

Location

Rig up

Drilling and Remarks:

Pay { 1695
1706
Shot 6096
20 Hrs.

RECORD

Cased _____ in., _____ ft.

Sand _____

Gas _____

Oil _____

Total Depth _____

PRODUCTION

1st 24 hrs. Nat. _____

1st 24 hrs. after shot _____

Gas _____ Cu. Ft.

Dry Hole _____

Abandoned _____

Date

M. A. BENEAR

MAR 22 1923

192

Scout