


KANSAS

Butler

FORM 51 25M 3-49 PETROL

Section 9 Township 28 Range 4-E
Well No. #3 Haynes *(Haines)*
Company Dunn & Strait

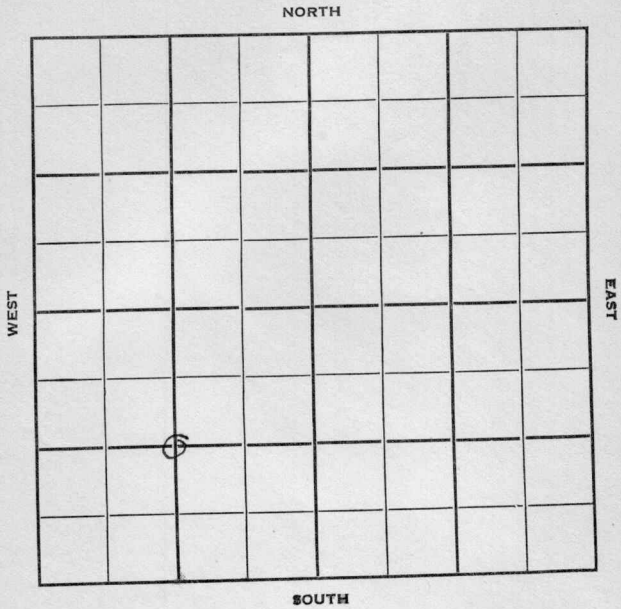

KANSAS

Butler

Sec. 9 Twp. 28 R. 4-E

Well No. #3 Haynes Farm

Dunn & Strait Company

Augusta Contractor


Ft. from N. Line

1320 Ft. from S. Line

Ft. from E. Line

1320 Ft. from W. Line

C SW/4

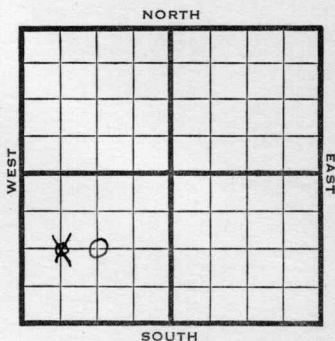

1950

Elv. 1206'

REPORT

7/19

8" @ 100
Drlg 2600

9/13

Oil Well TD 2487'
8" @ 100'
Simp. 2483-85'
5½" @ 2483'
TD 2487'
Comp. 50 BOPD

COMPLETED

Map No. _____ Sec. 9 Twp. 28 R. 4EWell No. 3 HaynesDunn & Strait Company

Contractor

C SW/4

SECTION PLAT



_____ Ft. from N. Line

1320 Ft. from S. Line

_____ Ft. from E. Line

1320 Ft. from W. Line

Butler County

Location _____

Rig up _____

Drilling and Remarks:

8" @ 100

drlg. 2600

RECORD

Cased _____ in., _____ ft.

Sand _____

Gas _____

Oil _____

Total Depth _____

PRODUCTION

1st 24 hrs. Nat. _____

1st 24 hrs. after shot _____

Gas _____ Cu. Ft.

Dry Hole _____

Abandoned _____


Date

JUL 19 1950

19

J. E. TYRA

Scout

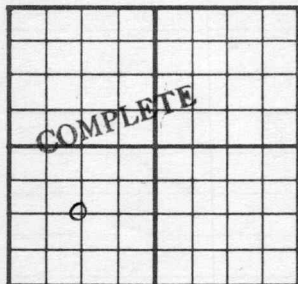County Butler State KansasSec. 9 (Blk.
Twp.) 28 (Sur.
Rge.) 4E Map No.Operator Dunn & StraitWell No. 3 Farm HaynesElev. 1206 Location C SW/41320 Ft. From S Line SW1320 Ft. From W Line Quarter1st. ReportCompletion SEP 13 1950RemarksAugusta PoolSpudding DateDrlg. Data Oil well TD 24878" @ 100 Simp. 2483-85 5½" @ 2483TD 2487 Comp. 50 bopd

J. E. TYRA