


Map No. _____ Sec 9 Twp. 28 R. 4Well No. 7 J R Ralston Farm _____Cont Oil & Gas Company _____

NORTH

WEST

EAST

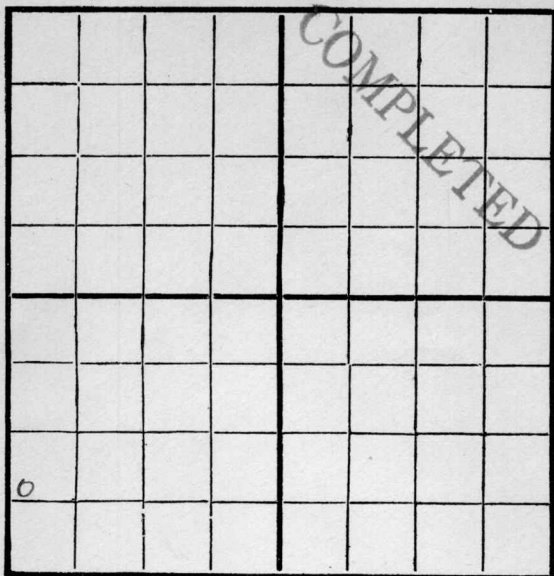

SOUTH

Location _____

Rig Up _____

Drilling Remarks:

5/2 2 ft in

Drilling Remarks:

RECORD

Cased _____ in _____ Ft.

Sand 2480 ft

Gas _____

Oil _____

Total Depth _____

PRODUCTION

1st 24 hrs. Nat. _____

1st 24 hrs. after shot _____

Gas _____ Cu. Ft.

Dry Hole _____


Abandoned _____

Map No. _____ Sec. 9 Twp. 28 R. 4Well No. 7 J. R. Peterson Farm _____Count D. E. E. Company _____

NORTH

WEST

EAST

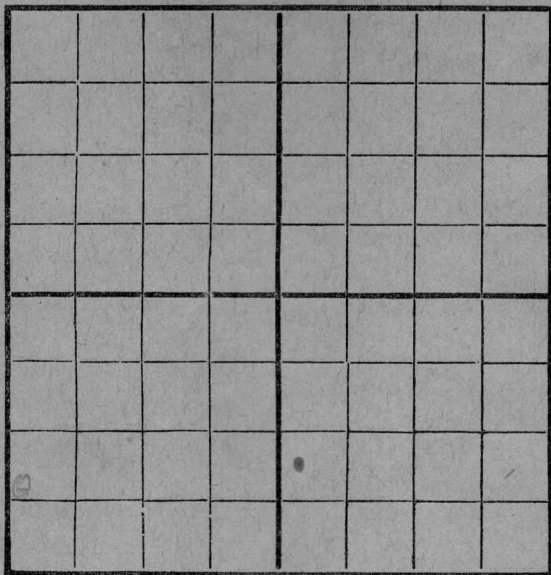

SOUTH

RECORD

Location _____

Cased _____ in. _____ Ft.

Rig Up _____

Sand 2480

Drilling and remarks

Gas _____

Oil _____

Total Depth _____

PRODUCTION

1st 24 hrs. Nat. _____

1st 24 hrs. after shot _____

Gas _____ Cu. Ft.

Dry Hole _____

Abandoned _____

Date

May 2, 1916 L. R. Peterson Scout

Map No. _____ Sec. 9 Twp. 28 R. 4Well No. 7-1 R. Puleston FarmContinental Oil Co. Company

NORTH

WEST

EAST

SOUTH

RECORD

Location _____

Cased _____ in. _____ Ft.

Rig Up _____

Sand 2480 - 2515

Drilling and remarks

Gas _____

Oil _____

Total Depth _____

PRODUCTION

1st 24 hrs. Nat. _____

1st 24 hrs. after shot _____

Gas _____ Cu. Ft.

Dry Hole _____

Abandoned _____

Date

5/2, 1916 L. C. C. Scout