


Kansas

Map No. _____ Sec. 12 Twp. 24 R. 12Well No. 9. Dame Farm _____Vincent Pet. Company _____

NORTH

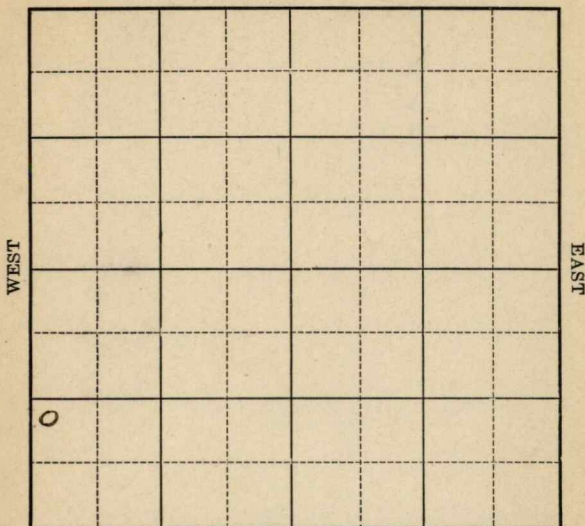

SOUTH

Location _____

Drilling Remarks:

Rig Up _____

Drilling Remarks:

RECORD

Cased _____ in. _____ ft.

Sand _____

Gas _____

Oil _____

Total Depth _____

PRODUCTION

1st 24 hrs. Nat. _____

1st 24 hrs. after shot _____

Gas _____ cu. ft.

Dry Hole _____

Abandoned _____

Map No. _____ Sec. 12 Twp. 24 R. 12


Well No. #9 Dame Farm
Vincent Pet. Company

_____ Ft. from N. Line

1170 Ft. from S. Line

_____ Ft. from E. Line

200 Ft. from W. Line

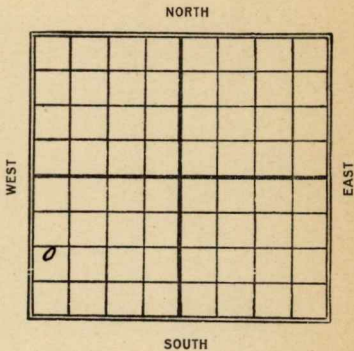

Date

REPORT

14 22

7/15

Deg. 1400

7/15

1723-54

Shot 60 gts 80 Bbls

Map No. 16 Sec. 12 Twp. 24 R. 12Well No. 9 - KlameVincent Pet. Company

Contractor

FIRST REPORT

Ft. from N. Line

1170' Ft. from S. Line

Ft. from E. Line

200 Ft. from W. Line**SECTION PLAT**

0			

Location

Rig up

Drilling and Remarks:

Log 1400**RECORD**

Cased _____ in., _____ ft.

Sand _____

Gas _____

Oil _____

Total Depth _____

PRODUCTION

1st 24 hrs. Nat. _____

1st 24 hrs. after shot _____

Gas _____ Cu. Ft.

Dry Hole _____

Abandoned _____

Date

JUL 15 1922191M. A. BENEAR

Scout

Map No. *Raus 16/12* Sec. *12* Twp. *24* R. *12*Well No. *920ame**Vincent Pet* Company

Contractor

COMPLETED

SECTION PLAT

0			

Ft. from N. Line

1120 Ft. from S. Line

Ft. from E. Line

200 Ft. from W. Line

Location

Rig up

Drilling and Remarks:

shot 60 qt

RECORD

Cased _____ in., _____ ft.

Sand _____

Gas _____

Oil *1723-54*Total Depth *1750*

PRODUCTION

1st 24 hrs. Nat. _____

1st 24 hrs. after shot *70*

Gas _____ Cu. Ft.

Dry Hole _____

Abandoned _____

Date

JUL 15 1922₁₉₁

M. A. BENEAR Scout