


Map No. _____ Sec. 9 Twp. 28 R. 4

Well No. 8 _____ Farm _____

_____ Company _____

NORTH

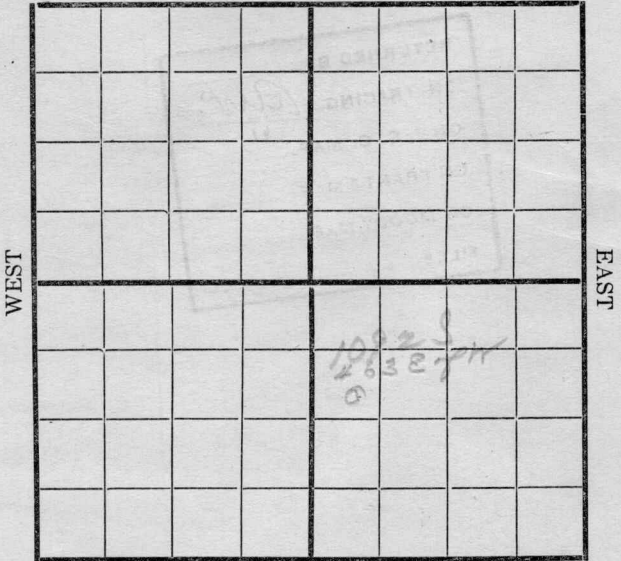

SOUTH

Location _____

Rig Up _____

Drilling and remarks

1092' 00' of N.L.
463 E. of N.L.

FIRST REPORT

RECORD

Cased _____ in. _____ Ft.

Sand _____

Gas _____

Oil _____

Total Depth _____

PRODUCTION

1st 24 hrs. Nat. _____

1st 24 hrs. after shot _____

Gas _____ Cu. Ft.

Dry Hole _____

Abandoned _____

Date

6/30, 1917


Conroy Scout

Map No. _____ Sec. 9 Twp. 28 R. 4

Well No. 8 Sweeney Farm _____

Campbell Company _____

NORTH

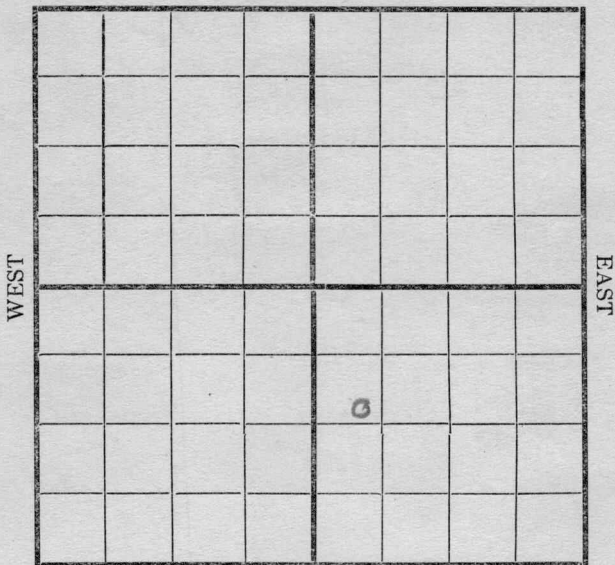

SOUTH

Location _____

Rig Up _____

Drilling and remarks

10925 ft
4638 ft

RECORD

Cased _____ in. _____ Ft.

Sand _____

Gas _____

Oil _____

Total Depth _____

PRODUCTION

1st 24 hrs. Nat. _____

1st 24 hrs. after shot _____

Gas _____ Cu. Ft.

Dry Hole _____

Abandoned _____

Date

6/27, 191 7

Campbell

Scout


Map No. ----- Sec. 9 Twp. 28 R. 4

Well No. 8 Scully Farm

Empire Company

NORTH

WEST

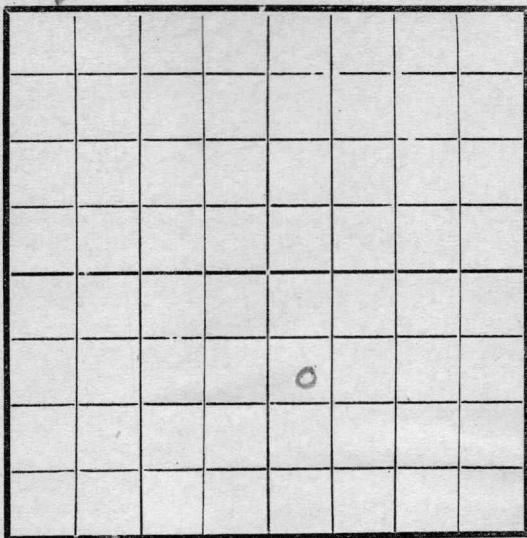

EAST

SOUTH

Location -----
 Rig Up -----
 Drilling and remarks -----

RECORD

Cased ----- in. ----- Ft.
 Sand -----
 Gas -----
 Oil -----
 Total Depth -----


PRODUCTION

1st 24 hrs. Nat. -----
 1st 24 hrs. after shot -----
 Gas ----- Cu. Ft.
 Dry Hole -----
 Abandoned -----

Date

7/6, 1917 Candy Scout

Map No. _____ Sec. 9 Twp. 28 R. 4
 Well No. P. Seely Farm _____
Engine Company _____
 NORTH

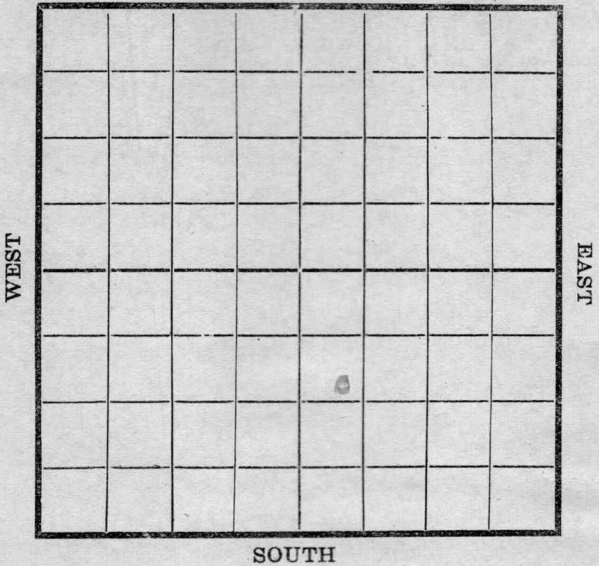

Location _____
 Rig Up _____
 Drilling and remarks
Spinning

RECORD

Cased _____ in. _____ Ft.
 Sand _____
 Gas _____
 Oil _____
 Total Depth _____

PRODUCTION

1st 24 hrs. Nat. _____
 1st 24 hrs. after shot _____
 Gas _____ Cu. Ft.
 Dry Hole _____
 Abandoned _____

Date _____
7/12, 1917 P. Seely Scout

Map No. _____ Sec. 9 Twp. 28 R. 4


Well No. S. Develly Farm _____

Compuce Company _____

NORTH

WEST

EAST

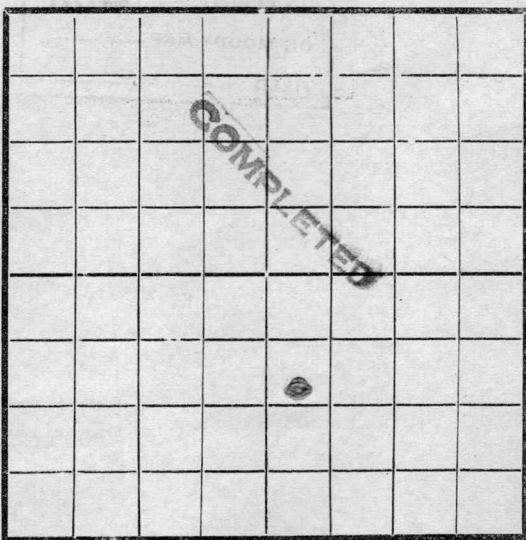

SOUTH

RECORD

Location _____

Rig Up _____

Drilling and remarks _____

Cased _____ in. _____ Ft.

Sand 2462-7487

Gas _____

Oil

Total Depth 7487

PRODUCTION

1st 24 hrs. Nat. 100 Bbls

1st 24 hrs. after shot _____

Gas _____ Cu. Ft.

Dry Hole _____

Abandoned _____

Date

8-21, 1917

Lantz Scout