


Section 12 Township 24 Range 12E

Well No. #1. Dame Est.

Company Aikman & Braden

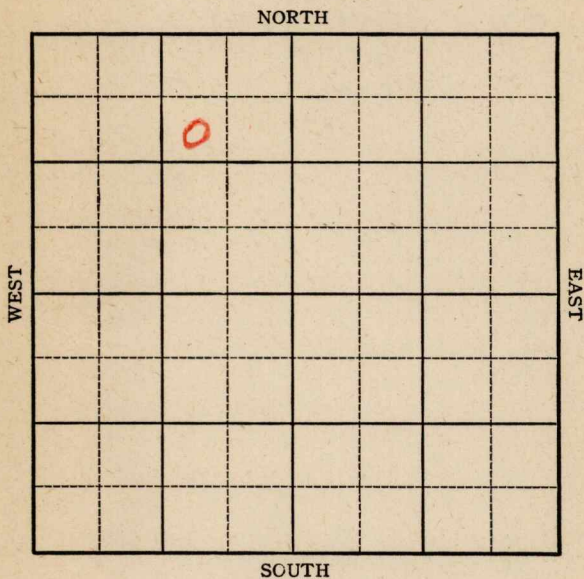

KANSAS

Greenwood County

Sec. 12 Twp. 24 R. 12E

Well No. #1 Dame Est. Farm

Aikman & Braden

Company

Virgil


800 Ft. from N. Line

 Ft. from S. Line

800 Ft. from E. Line

SW Ft. from W. Line

~~SE~~ NE NW

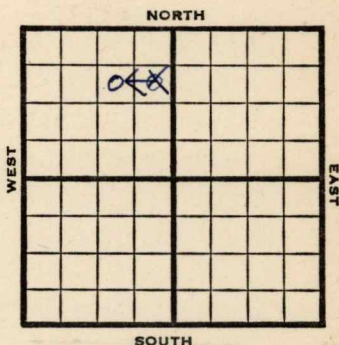

1946 **Elev.** **REPORT**

3/27 Machine

4/4 10" @ 662
Drlg. 795

4/10 Drlg 1250
8" @ 1225

4/16 **Chat 16 48 $\frac{1}{2}$ -64**
TD 6" @ 1656 $\frac{1}{2}$ WOC

4/23 1000 acid SS0

5/1 **Chat 1648 $\frac{1}{2}$**
6" @ 1656 $\frac{1}{2}$
TD 1714
1000 acid.
Wtr.

ABANDONED


KANSASKansas Pool Name VirgilMap No. 16 Sec. 12 Twp. 24 R. 12EWell No. 1 Dame Est.Aikman & Braden Company

FIRST REPORT

Contractor

SWSE NE NW

SECTION PLAT

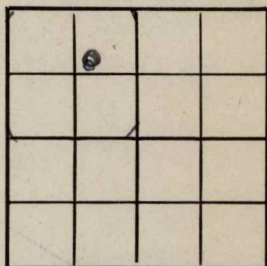800 Ft. from N. Line

Ft. from S. Line

800 Ft. from E. Line

Ft. from W. Line

Greenwood County

Location

Rig up

Drilling and Remarks:

Machine

RECORD

Cased _____ in., _____ ft.

Sand _____

Gas _____

Oil _____

Total Depth _____

PRODUCTION

1st 24 hrs. Nat. _____

1st 24 hrs. after shot _____

Gas _____ Cu. Ft.

Dry Hole _____

Abandoned _____

Date

MAR 27 1946 19S. J. LEWIS Scout

Kansas Pool Name Virgil

Map No. _____ Sec. 12 Twp. 24 R. 12E

Well No. 1 Dame Est.
Aikman & Braden Company

CORRECTION

Contractor

SW NE NW

SECTION PLAT

800 Ft. from N. Line

 Ft. from S. Line

800 Ft. from E. Line

 Ft. from W. Line

Greenwood County

Location _____

Rig up _____

Drilling and Remarks:

Reported

SE NE NW

RECORD

Cased _____ in., _____ ft.

Sand _____

Gas _____

Oil _____

Total Depth _____

PRODUCTION

1st 24 hrs. Nat. _____

1st 24 hrs. after shot _____

Gas _____ Cu. Ft.

Dry Hole _____

Abandoned _____

Date

MAY 1 1946 19 S. J. LEWIS Scout

KANSAS

Kansas Pool Name Virgil

Map No. 14 Sec. 12 Twp. 24 R. 12E

Well No. 1 Dame Est.
Aikman and Braden

Company

ABANDONED

Contractor

SW NE NW

SECTION PLAT

	o		

800 Ft. from N. Line

 Ft. from S. Line

800 Ft. from E. Line

 Ft. from W. Line

Greenwood County

Location

Rig up

Drilling and Remarks:

Chas 1648 1/2
6" @ 1656 1/2
1000 Quad
Water.

RECORD

Cased in., ft.

Sand

Gas

Oil

Total Depth 1714

PRODUCTION

1st 24 hrs. Nat.

1st 24 hrs. after shot

Gas Cu. Ft.

Dry Hole

Abandoned

Date

MAY 1 1946

19

S. J. LEWIS

Scout

1st report shows
of NG MW

you are now
completing in

sw NG MW

which is correct?
Sam

Misc. Small Maps

Cards

Tracing

France Map

Scarborough Map

Pierce Map

Geological Dept.

Pierce Flat