


Section 9 Township 28 Range 4E

Well No. 1 West B

Company E Adair

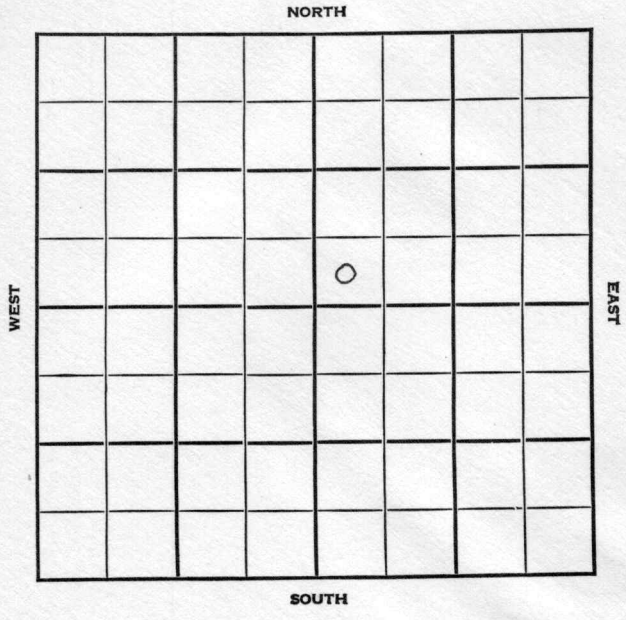

Sec. 9 Twp. 28 R. 4E

Well No. #1 West "B" Farm _____

E. Adair Company _____

Misc. _____


_____ Ft. from N. Line

330 Ft. from S. Line

_____ Ft. from E. Line

330 Ft. from W. Line

SW NE

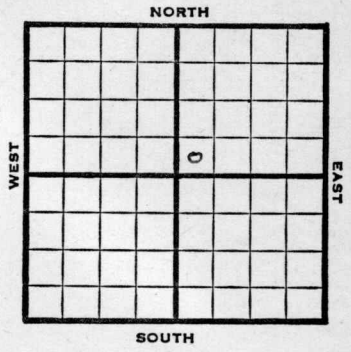

1947

REPORT

12/17

Spud.

12/30

13" @ 688'
10" @ 1450'
Drlg. 1465'

1948

1/7

1/14

"
Lansing 1635'
KC 1995'
Simpson sand 2502'-04'
TD 2502-04'
5" @ 2498'

1/21

Simp. 2502'
5" @ 2498'
Pump 30 Pot
41.0 Gr.
TD 2504'
Comp.

COMPLETED

Map No. _____ Sec. 9 Twp. 28 R. 4E

Well No. 1 West "B"

E. Adair Company

FIRST REPORT Contractor

SW NE

SECTION PLAT

_____ Ft. from N. Line

330 Ft. from S. Line

_____ Ft. from E. Line

330 Ft. from W. Line

Butler County

Location _____

Rig up _____

Drilling and Remarks:

Spud

RECORD

Cased _____ in., _____ ft.

Sand _____

Gas _____

Oil _____

Total Depth _____

PRODUCTION

1st 24 hrs. Nat. _____

1st 24 hrs. after shot _____

Gas _____ Cu. Ft.

Dry Hole _____

Abandoned _____

Date

DEC 17 1947 19

S. J. LEWIS Scout

