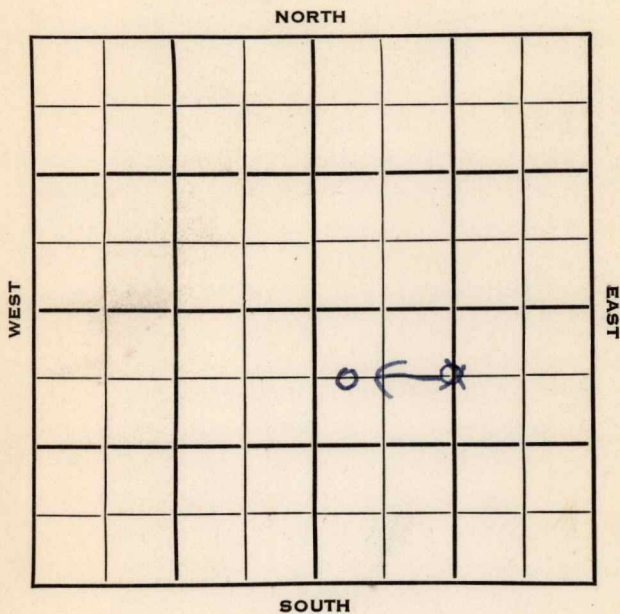


Greenwood

KANSAS

Section 12 Township 24 Range 12EWell No. #2 DarlingCompany Burgin

KANSAS

Greenwood

Sec. 12 Twp. 24 R. 12EWell No. #2 Darling FarmBurgin Company


Contractor

660' Ft. from N. Line

Ft. from S. Line

1320' Ft. from E. Line330 Ft. from W. Line~~G N $\frac{1}{2}$ SE $\frac{1}{4}$~~

CWL NW SE

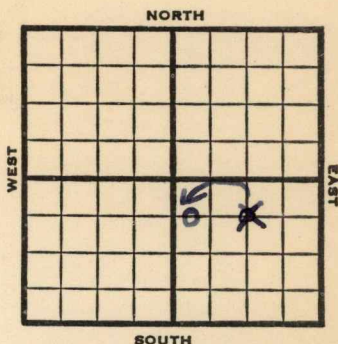

1953

Elev. --

REPORT

2/18

RUR

4/29

Spud 2-17-53

Oil well TD 1750' 8" @ 12

Miss 1707' TD 1718 4" @ 1718

DD 1750 2000 A

Comp. 6 BOPD

COMPLETED

County Greenwood State Kansas
Sec. 12 (Blk. Twp.) 24 (Sur. Rge.) 12E Map No.
Operator Burgin
Well No. 2 Farm Darling
Elev. _____ Location C N $\frac{1}{2}$ SE/4

FIRST REPORT

660 Ft. From N Line SE
1320 Ft. From E Line Quarter

1st. Report FEB 18 1953

Completion _____

Remarks _____

Spudding Date _____

Drlg. Data

RUR

J. G. McGEHEE

Kansas

Map No. _____ Sec. 12 Twp. 24 R. 12E

Well No. 2 Darling

Burgin Company

CORRECTION Contractor

C W L NW SE


SECTION PLAT

660 Ft. from N. Line

_____ Ft. from S. Line

_____ Ft. from E. Line

330 Ft. from W. Line

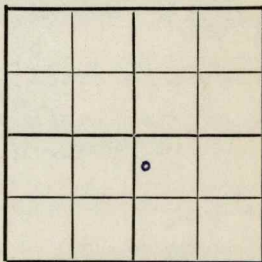

Greenwood County

Location _____

Rig up _____

Drilling and Remarks:

Reported

C N/2 SE/4

RECORD

Cased _____ in., _____ ft.

Sand _____

Gas _____

Oil _____

Total Depth _____

PRODUCTION

1st 24 hrs. Nat. _____

1st 24 hrs. after shot _____

Gas _____ Cu. Ft.

Dry Hole _____

Abandoned _____

Date

FEB 25 1953

19

J. G. McGEHEE

Scout

DD 1750 2000 A Comp. 6 bopd