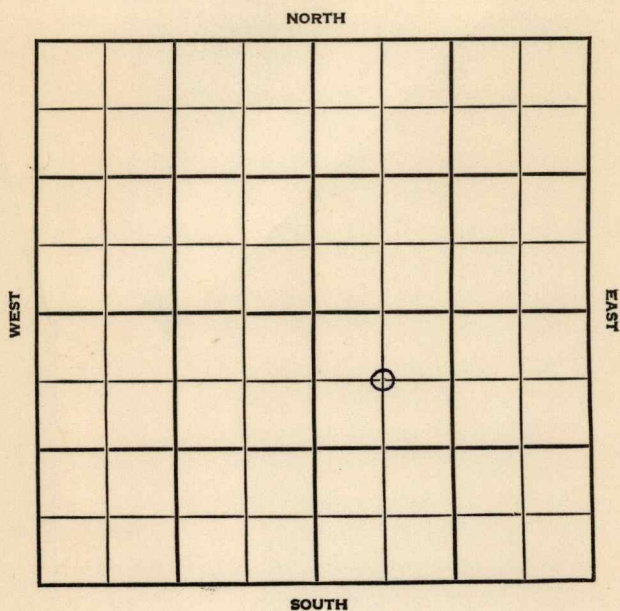


Section 9 Township 24 Range 12 EWell No. #1 HillmanCompany Arthur Lyke

Greenwood

KANSAS

SEC.	TWP.	R.
9	24	12E

WELL NO.

#1 Hillman

FARM

COMPANY

Arthur Lyke

CONTRACTOR

Baker


_____ Ft. from N. Line

_____ Ft. from S. Line

_____ Ft. from E. Line

_____ Ft. from W. Line

C NW SE

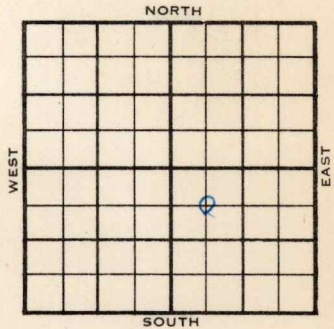

1955

ELEVATION

REPORT

10/5

MICT

12-21

Comm. 11-18-55

8 5/8" @ 558

D & A

Sd. 482

Big. lm. 615

M. 1717

TD 1753'

ABANDONED

Use.

No.

sec.

1.

ス

County Greenwood Elev. _____
Sec. 9 Twp. 24 Rge. 12E
Company Arthur Lyke
Farm Name Hillman No. 1

TOPS	DEPTH	LOG	DATUM	Loc. in Sec.
Anh.				C NW SE
Tp.				
H.				
Tr.				
Dg. <u>sd.</u>	<u>482</u>			
Bl. <u>Big. lm</u>	<u>615</u>			
L.				Geol.
K.C.				Contr.
B.K.C.				Baker
Ce.				
C.				Pool
M.	<u>1717</u>			
M.				
K.				
Mz.				
Mq.				
V.				
S.				
S.				
A.				
R.				
Pe.				
G.				
T.D.	<u>1753</u>			

Date Comm. 11-18-55 DEC 21 1955
8 5/8" @ 558

D & A