


Section 10 Township 28 Range 4 E

Well No. #2 Faltham

Company Braden Drlg.

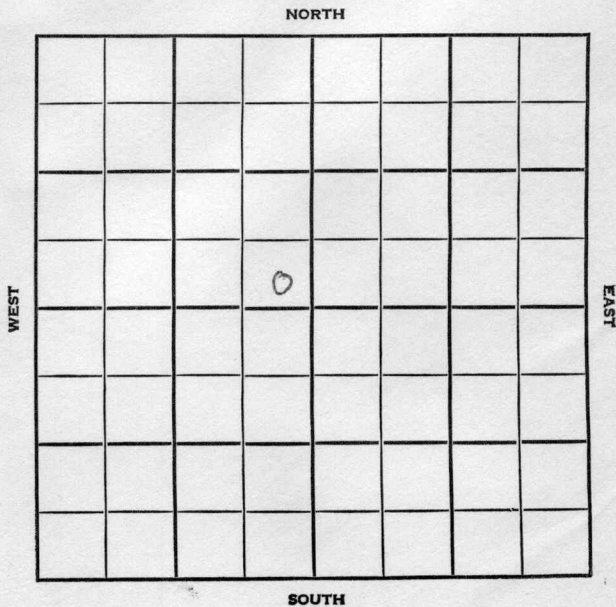

Butler

KANSAS

SEC. 10	TWP. 28	R. 4E
------------	------------	----------

WELL NO. #2 Faltham FARM

COMPANY Braden Drlg.

CONTRACTOR Co. Tools


Augusta

_____ Ft. from N. Line

_____ Ft. from S. Line

_____ Ft. from E. Line

_____ Ft. from W. Line

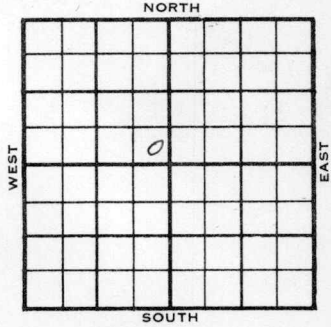

SE SE NW (Twin)

1956	ELEVATION	REPORT
	1284	
2-29		Comm. 2-27-56
4-4		13" @ 338 10" @ 1210 5 1/2" @ 2598 CO to 2645 wtr. D & A L. 1722 KC 2080 S. sd. 2600 TD 2645

ABANDONED

County Butler Elev. _____
 Sec. 10 Twp. 28 Rge. 4E
 Company Braden Drlg.
 Farm Name Faltham No. 2

TOPS	DEPTH	LOG	DATUM
Anh.			
TP.			
H.			
Tr.			
Dg.			
Bl.			
L.			
K.C.			
B.K.C.			
Ce.			
C.			
M.			
M.			
K.			
Mz.			
Me.			
V.			
S.			
S.			
A.			
R.			
PE.			
G.			
T.D.			

Loc. in Sec. SE SE NW
(twin)
 Geol. _____
 Contr. _____
Co. tools
 Pool _____
Augusta

FIRST REPORT	
0	
FEB 20 '56	

Date Comm. 2-27-56

Co.

Lse.

No.

Sec.

T.

R.

County Butler Elev. 1284
 Sec. 10 Twp. 28 Rge. 4E
 Company Braden Drlg.
 Farm Name Faltham No. 2

Co.

TOPS	DEPTH	LOG	DATUM
Anh.			
TP.			
H.			
Tr.			
Dg.			
Bl.			
L.	<u>1722</u>		<u>438</u>
K.C.	<u>2080</u>		<u>796</u>
B.K.C.			
Ce.			
C.			
M.			
M.			
K.			
Mz.			
Me.			
V.			
S.	<u>sd</u>	<u>2600</u>	<u>1316</u>
S.			
A			
R.			
PE.			
G.			
TD.	<u>2645</u>		

Loc. in Sec. _____
SE SE NW
(twin)
 Geol. _____
 Contr. _____
Co. tools
 Pool _____
Augusta

Lse.

ABANDONED
 APR 4 '55

No.

Date Comm. 2-27-56
13" @ 338 10" @ 1210 5 1/2" @ 2598
CO to 2645 wtr.

Sec.

D & A

T.

R.