

KANSAS


Butler

FORM 51 IOM 12-46 PETROL

Section 10 Township 28 Range 4E

Well No. 3 Feltham

Company E. Adair

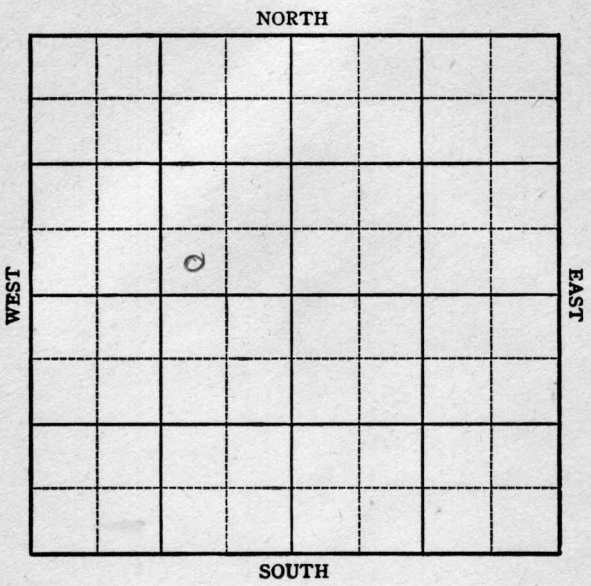

KANSAS

Butler



Sec. 10 Twp. 28 R. 4-E

3 Feltham

Well No. _____ Farm _____

E. Adair


Company _____

_____ Ft. from N. Line

330 Ft. from S. Line

990 Ft. from E. Line

_____ Ft. from W. Line

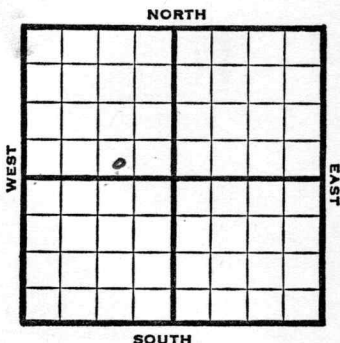

SW SE NW

1947

Elev. 1290' REPORT

6/4	Rig.
6/10	Drlg. 750'
6/17	12" @ 998' Drlg. 495'
6/24	10" @ 1547' Drlg. 2275'
7/1	Simpson 2562' 7" @ 2566' Drlg 2374'
7/8	"
7/16	TD 2593'
7/22	"
7/30	Simp. Sd. 2562' 7" @ 2566' Pump 50 Pot Gr. 38.0 TD 2593'

COMPLETED

Map No. _____ Sec. 10 Twp. 28 R. 4E

Well No. 3 Feltham

E. Adair Company

FIRST REPORT Contractor

SW SE NW

SECTION PLAT

_____ Ft. from N. Line

330 Ft. from S. Line

990 Ft. from E. Line

_____ Ft. from W. Line

Butler County

Location _____

Rig up _____

Drilling and Remarks:

Rig

RECORD

Cased _____ in., _____ ft.

Sand _____

Gas _____

Oil _____

Total Depth _____

PRODUCTION

1st 24 hrs. Nat. _____

1st 24 hrs. after shot _____

Gas _____ Cu. Ft.

Dry Hole _____

Abandoned _____

Date

JUN 4 1947 19 _____

S. J. LEWIS Scout

