


Section 9 Township 24 Range 12E
Well No. 1 Meyers *(Myers)*
Company Berentz Drlg.

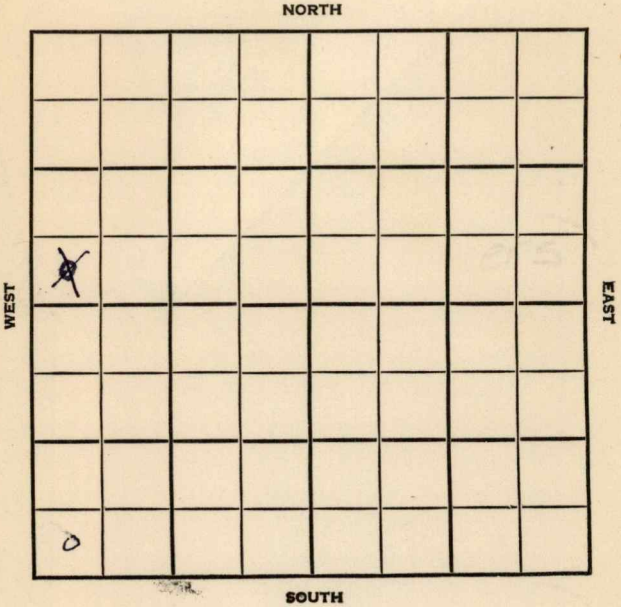

SEC. 9	TWP. 24	R. 12E
-----------	------------	-----------


WELL NO. #1 Meyers FARM

COMPANY Berentz Drlg.

CONTRACTOR Co. Tools.

Hamilton Pool

_____ Ft. from N. Line
 330 _____ Ft. from S. Line
 _____ Ft. from E. Line
 330 _____ Ft. from W. Line

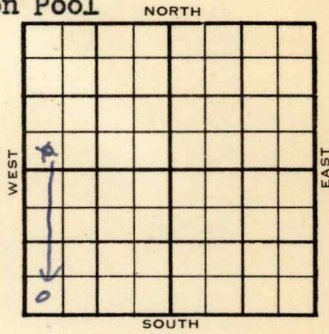

SW SW ~~NW~~ ^{SW}

1954	ELEVATION	REPORT
------	-----------	--------

9/1 Location
 12/1 Spud 10-21-54
 10" @ 720'
 8" @ 1073'
 7" @ 1370'
 Sdy Sh 1505' -1676'
 TD 1676'
 D & A

ABANDONED

Kansas

Map No. _____ Sec. 9 Twp. 24 R. 12E

Well No. 1 Meyers

Berentz Company

CORRECTION Contractor

SW SW SW

SECTION PLAT

_____ Ft. from N. Line

330 Ft. from S. Line

_____ Ft. from E. Line

330 Ft. from W. Line

Greenwood County

Location _____

Rig up _____

Drilling and Remarks:

Reported

SW SW NW

RECORD

Cased _____ in., _____ ft.

Sand _____

Gas _____

Oil _____

Total Depth _____

PRODUCTION

1st 24 hrs. Nat. _____

1st 24 hrs. after shot _____

Gas _____ Cu. Ft.

Dry Hole _____

Abandoned _____

Date

NOV 3 1954 19

FABEN GILSTRAP

Scout

