


Section 10 Township 28 Range 4-E

Well No. 4 Feltham

Company Adair

Miscellaneous NORTH

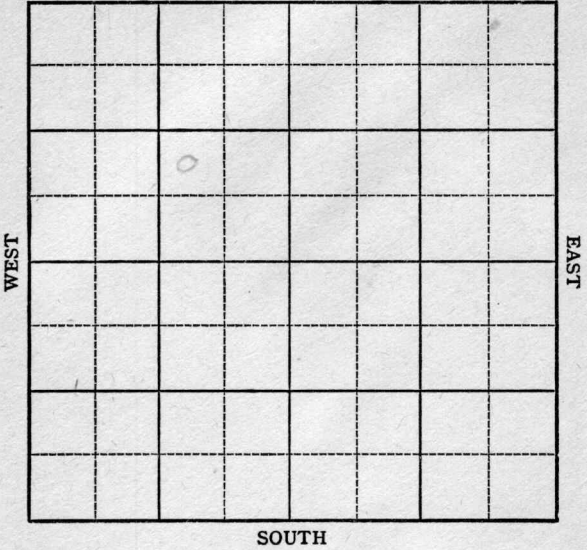

KANSAS

Butler County ✓

Sec. 10 Twp. 28 R. 4-E

Well No. 4 Feltham Farm

Adair Company


Miscellaneous

Ft. from N. Line

990 Ft. from S. Line

990 Ft. from E. Line

Ft. from W. Line

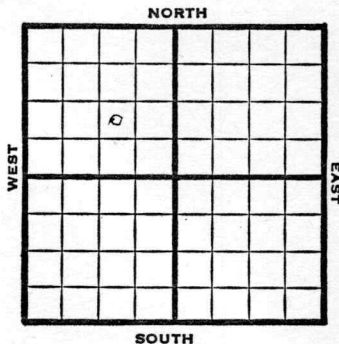

NW SE NW

1947

REPORT

- 7-16 Drlg. 565
- 7/22 12" @ 850
Drlg. 1550
- 7/29 10" @ 1539'
Lansing 1705'
Kansas City 2065'
Drlg 2235'
- 8/6 8" @ 2361'
Simpson 2575'
TD 2603'
6" @ 2596'
WOC
- 8/13 "
- 8/20 Simp 2575'
6" @ 2596'
Pump 20 Pot.
Gr. 38
T.D. 2603'
Completed

COMPLETED

Map No. _____ Sec. 10 Twp. 28 R. 4E

Well No. 4 Feltham

Adair Company

FIRST REPORT Contractor

NW SE NW

SECTION PLAT

	o		

_____ Ft. from N. Line

990 Ft. from S. Line

990 Ft. from E. Line

_____ Ft. from W. Line

Butler County

Location _____

Rig up _____

Drilling and Remarks:

drlg. 565

RECORD

Cased _____ in., _____ ft.

Sand _____

Gas _____

Oil _____

Total Depth _____

PRODUCTION

1st 24 hrs. Nat. _____

1st 24 hrs. after shot _____

Gas _____ Cu. Ft.

Dry Hole _____

Abandoned _____

Date

JUL 16 1947

19

S. J. LEWIS

Scout

