


Map No. Kansas Sec. 10 Twp. 24 R. 12
 Well No. 1 Meyers Farm
Franklin Oil Company

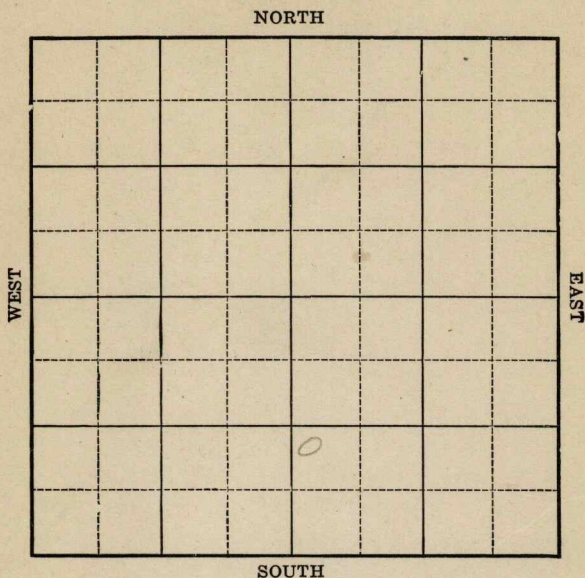

Location _____

Drilling Remarks

RECORD

Cased _____ in. _____ ft.

Sand _____

Gas _____

Oil _____

Total Depth _____

Rig Up _____

Drilling Remarks

PRODUCTION

1st 24 hrs. Nat. _____

1st. 24 hrs. after shot _____

Gas _____ cu. ft.

Dry Hole _____


Abandoned _____

Map No. Kansas Sec. 10 Twp. 24 R 12Well No. 1 Meyers FarmFranklin Oil Company

Ft. from N. Line

1120 Ft. from S. Line

Ft. from E. Line

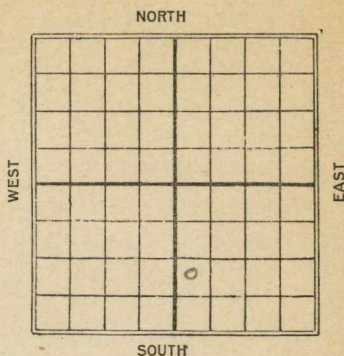200 Ft. from W. LineDate
1925

REPORT

3/1 Dlg 4004/6 Top Line 1743

Pay 1757-88 T.D. 1793

P.B. to 1790

40 gals 15 Bbls

Map No. KANSAS Sec. 10 Twp. 24 R. 12

Well No. 1 Meyers

Franklin oil Company

Contractor

FIRST REPORT

SECTION PLAT

_____ Ft. from N. Line

1120' Ft. from S. Line

_____ Ft. from E. Line

200' Ft. from W. Line

		o	

Location _____

Rig up _____

Drilling and Remarks:

Dlg. 400'

RECORD

Cased _____ in., _____ ft.

Sand _____

Gas _____

Oil _____

Total Depth _____

PRODUCTION

1st 24 hrs. Nat. _____

1st 24 hrs. after shot _____

Gas _____ Cu. Ft.

Dry Hole _____

Abandoned _____

Date

3/1 1925

BENEAR Scout

Map No. **KANSAS** Sec. *10* Twp. *24* R. *12^E*

Well No. *1 Meyers*

Franklin et al. Company

Contractor

COMPLETED SECTION PLAT

----- Ft. from N. Line

1120' Ft. from S. Line

----- Ft. from E. Line

200' Ft. from W. Line

		<i>0</i>	

Location -----

Rig up -----

Drilling and Remarks:

Top Line 1743'
Pay. 1757-88
T.D. 1793
R.B. 1790
40/15

RECORD

Cased ----- in., ----- ft.

Sand -----

Gas -----

Oil -----

Total Depth -----

PRODUCTION

1st 24 hrs. Nat. -----

1st 24 hrs. after shot -----

Gas ----- Cu. Ft.

Dry Hole -----

Abandoned -----

Date

APR 6 1925 *M. A. BENEAR* Scout