


Greenwood

KANSAS

Section 10 Township 24 Range 12-E


Well No. 3 Meyers

Company C. Aikman & Sons

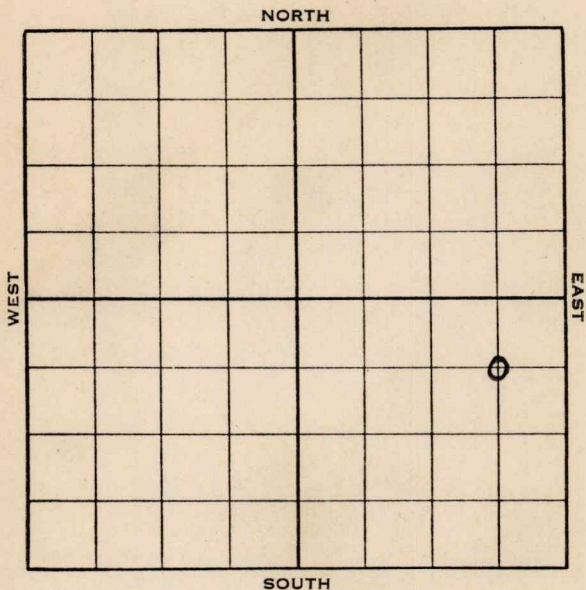

C. Aikman & Sons Company

Ft. from W. Line

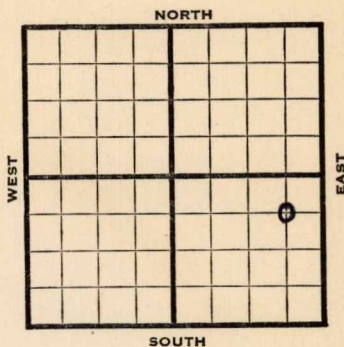[illegible]

Map No. 16 Sec. 10 Twp. 24 R. 12EWell No. 3 MeyersC. Aikman & Sons

Company

Contractor

FIRST REPORT

SECTION PLAT

			0

C NE SE

660' Ft. from N. Line

Ft. from S. Line

660' Ft. from E. Line

Ft. from W. Line

Location _____

Rig up _____

Drilling and Remarks:

Mach.

RECORD

Cased _____ in., _____ ft.

Sand _____

Gas _____

Oil _____

Total Depth _____

PRODUCTION

1st 24 hrs. Nat. _____

1st 24 hrs. after shot _____

Gas _____ Cu. Ft.

Dry Hole _____

Abandoned _____

Date

APR 27 1938

19

H. D. Hatfield Scout

Map No. 16 Sec. 10 Twp. 24 R. 12EWell No. 3 MeyersC. Aikman & Sons

Company

Contractor

COMPLETED

C NE SE

660 Ft. from N. Line Ft. from S. Line660 Ft. from E. Line Ft. from W. Line

SECTION PLAT

			0

Location Rig up

Drilling and Remarks:

1000 Acid6 bbls

RECORD

Cased 6 in., 1790 ft.Sand MISS 1820Gas Oil Total Depth 1828

PRODUCTION

1st 24 hrs. Nat. 1st 24 hrs. after shot Gas Cu. Ft.Dry Hole Abandoned

Date

JUN 1 - 1938

19

H. D. Hatfield

Scout