


Section 10 Township 24 Range 12-E

Well No. #2
#1-Myers

Company Aikman & Braden

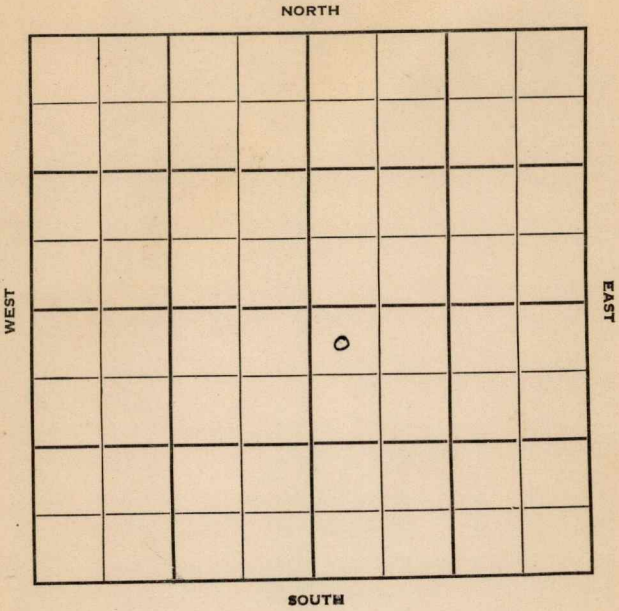

Greenwood **KANSAS**

Sec. 10 Twp. 24 R. 12E ✓

Well No. #5
#1 Myers Farm

Aikman & Braden

Company

Contractor

Miscellaneous


330' Ft. from N. Line

Ft. from S. Line

Ft. from E. Line

330' Ft. from W. Line

NW NW SE

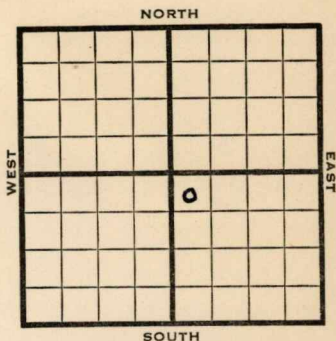

1950

Elev ?

REPORT

8/16

Spud 8-10-50

12" @ 16'

Drlg. 1330'

8/30

12" @ 16

Miss 1748


7" @ 1750

TD 1768

Comp 20 bopd

Completed

COMPLETED

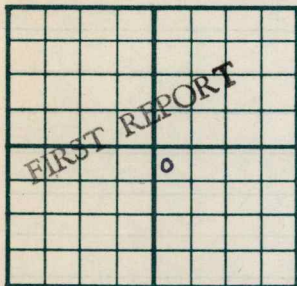County Greenwood State KansasSec. 10 (Blk.) 24 (Sur.) 12E Map No.Operator Aikman & BradenWell No. 1 Farm MyersElev. Location NW NW SE330 Ft. From N Line SE330 Ft. From W Line Quarter1st. Report AUG 16 1950

Completion

Remarks

Spudding Date 8-10-50

Drlg. Data

12" @ 16 drlg. 1330

J. E. TYRA

Kansas

Map No. _____ Sec. 10 Twp. 24 R. 12EWell No. 5 Myers_____ Aikman & Braden Company_____ CORRECTION Contractor

NW NW SE

SECTION PLAT

330 Ft. from N. Line

_____ Ft. from S. Line

_____ Ft. from E. Line

330 Ft. from W. Line

		0	

_____ Greenwood County

Location _____

Rig up _____

Drilling and Remarks:

Reported

#1 Myers

RECORD

Cased _____ in., _____ ft.

Sand _____

Gas _____

Oil _____

Total Depth _____

PRODUCTION

1st 24 hrs. Nat. _____

1st 24 hrs. after shot _____

Gas _____ Cu. Ft.

Dry Hole _____

Abandoned _____

Date

AUG 23 1950 19 J. E. TYRA Scout

J. E. TYRA