

Section 10 Township 28 Range 4-E

Well No. 27 Feltham


Company Cities service Oil

Miscellaneous

NORTH

WEST

EAST

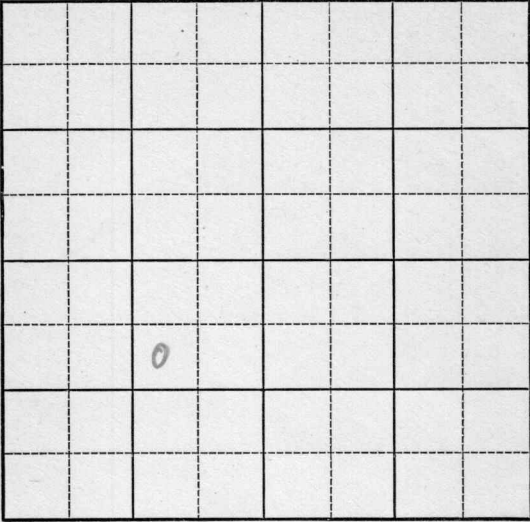

SOUTH

Sec. 10 Twp. 28 R. 4-E

Well No. #27 Feltham Farm

Cities Service oil Company


(Misc.)

990 Ft. from N. Line

\_\_\_\_\_ Ft. from S. Line

990 Ft. from E. Line

\_\_\_\_\_ Ft. from W. Line

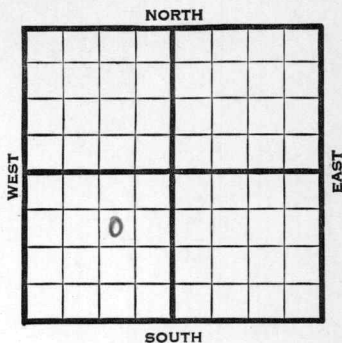

1941	REPORT
10/1	Pits.
10/9	Lans. 1682' K.C. 2042'
	7" - 2043' T.D. 2086'
	2000 acid.
10/15	K.C. 2042'
	7" - 2043'
	T.D. 2086'
	2000 acid.
	Pump 14 oil & 16 water.
	36. Gravity
	<b>COMPLETED</b>

Map No. K-11 Sec. 10 Twp. 28 R. 4E

Well No. 27 Feltham

Cities Service Oil Company

Contractor

FIRST REPORT

SW NE SW

990 Ft. from N. Line

\_\_\_\_\_ Ft. from S. Line

990 Ft. from E. Line

\_\_\_\_\_ Ft. from W. Line

SECTION PLAT


MISCELLANEOUS

Location \_\_\_\_\_

Rig up \_\_\_\_\_

Drilling and Remarks:

Pits

RECORD

Cased \_\_\_\_\_ in., \_\_\_\_\_ ft.

Sand \_\_\_\_\_

Gas \_\_\_\_\_

Oil \_\_\_\_\_

Total Depth \_\_\_\_\_

PRODUCTION

1st 24 hrs. Nat. \_\_\_\_\_

1st 24 hrs. after shot \_\_\_\_\_

Gas \_\_\_\_\_ Cu. Ft.

Dry Hole \_\_\_\_\_

Abandoned \_\_\_\_\_

Date

OCT 1 1941

S. J. LEWIS

Scout

Map No. K-11 Sec. 10 Twp. 28 R. 4E

Well No. 27 Feltham

Cities Service Oil Company

Contractor

COMPLETED

SECTION PLAT

SW NE SW

990 Ft. from N. Line

\_\_\_\_\_ Ft. from S. Line

990 Ft. from E. Line

\_\_\_\_\_ Ft. from W. Line


MISCELLANEOUS

Location \_\_\_\_\_

Rig up \_\_\_\_\_

Drilling and Remarks:

*KC 2042*  
*7" @ 2043*  
*2000 acid*  
*Pump 14 oil 16 water*  
*36° Gr*

RECORD

Cased \_\_\_\_\_ in., \_\_\_\_\_ ft.

Sand \_\_\_\_\_

Gas \_\_\_\_\_

Oil \_\_\_\_\_

Total Depth 2086

PRODUCTION

1st 24 hrs. Nat. \_\_\_\_\_

1st 24 hrs. after shot \_\_\_\_\_

Gas \_\_\_\_\_ Cu. Ft.

Dry Hole \_\_\_\_\_

Abandoned \_\_\_\_\_

Date

OCT 15 1941

S. J. LEWIS Scout