


Map No. 3-Myers Sec. 10 Twp. 24 R. 12E
 Well No. Bert Young Farm _____ Company _____

NORTH

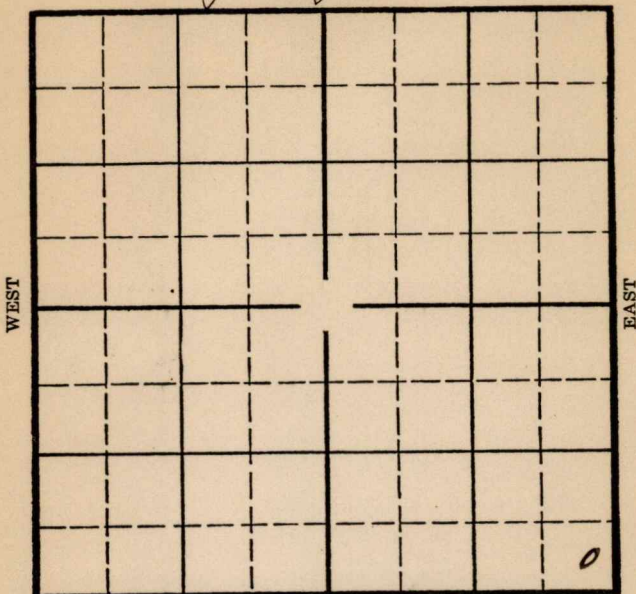

SOUTH

Location _____
 Drilling Remarks _____

Rig Up _____
 Drilling Remarks _____

RECORD

Cased _____ in. _____ ft.
 Sand _____
 Gas _____
 Oil _____
 Total Depth _____

PRODUCTION

1st 24 hrs. Nat. _____
 1st 24 hrs. after shot _____
 Gas _____ cu. ft. _____
 Dry Hole _____
 Abandoned _____

Greenwood
24 12E

Map No. Sec. 10 Twp. 24 R. 12E

Well No. 3-Meyers Farm


Bert Young Company

 Ft. from N. Line

200 Ft. from S. Line

200 Ft. from E. Line

 Ft. from W. Line

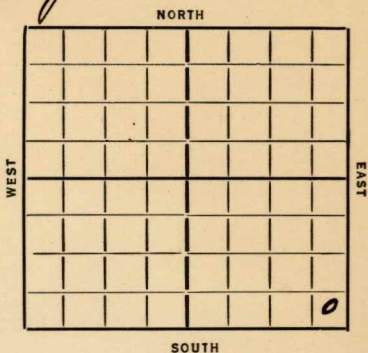

Date

REPORT

1935
10/24 Rog.
11/1
11/7 Run
11/14
11/21 Run & SD.
11/29
12/6 dely 755 10" 721
12/13 " 1350 8" 1225
12/19 Top Miss 1747 to 1757-61
do 1773-75 TD 1778
shot 60 gts CO Will acidize
12/26
12/36 Cemented csg
1/8 Miss 1747
TD 1778
60 gts Est 10 Oil

COMPLETED

Map No. 16 Sec. 10 Twp. 24 R. 12EWell No. 3-MyersBest Young Company

Contractor

FIRST REPORTS

SECTION PLAT

			0

Ft. from N. Line

200 Ft. from S. Line200 Ft. from E. Line

Ft. from W. Line

Location

Rig up

Drilling and Remarks:

Ray

RECORD

Cased _____ in., _____ ft.

Sand _____

Gas _____

Oil _____

Total Depth _____

PRODUCTION

1st 24 hrs. Nat. _____

1st 24 hrs. after shot _____

Gas _____ Cu. Ft.

Dry Hole _____

Abandoned _____

Date

10-24-35

192

ORVAL MANNSCHRECK

Scout

Map No. 16 Sec. 10 Twp. 24 R. 12E

Well No. 3-Myers

Bert Young Company

Contractor

SECTION PLAT

.....Ft. from N. Line

200 Ft. from S. Line

200 Ft. from E. Line

.....Ft. from W. Line

			0

COMPLETED

Location.....

Rig up.....

Drilling and Remarks:

60 gts.

Est. 10 oil

RECORD

Cased.....in.,ft.

Sand miss 1747

Gas.....

Oil.....

Total Depth 1778

PRODUCTION

1st 24 hrs. Nat.....

1st 24 hrs. after shot.....

Gas.....Cu. Ft.

Dry Hole.....

Abandoned.....

Date

JAN 8 1936

192.....

ORVAL MANNSCHRECK

Scout