

Section 10 Township 24 Range 12EWell No. #1 ShermanCompany Ashlock

		0					

NORTH

WEST

EAST

SOUTH

Greenwood

KANSAS

Sec. 10 Twp. 24 R. 12 E ✓

Well No. # 1 Sherman Farm

Ashlock

Company

Contractor

Ft. from N. Line

330


Ft. from S. Line

990

Ft. from E. Line

Ft. from W. Line

SW SE NW

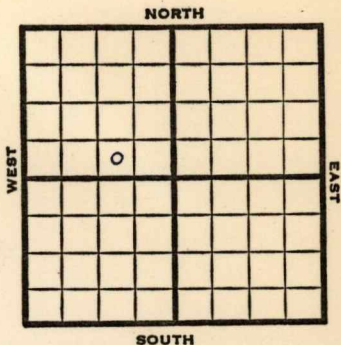

1951

Elev. -

REPORT

4/25

Location

5/16

Oil Well TD 1826

8" @ 39 4" @ 1800

Miss 1800 TD 1826

2000 A Comp. 20 bopd

COMPLETED

County Greenwood State Kansas
 Sec. 10 (Blk.) 24 (Sur.) 12E Map No.

Operator Ashlock

Well No. 1 Farm Sherman

Elev. Location SW SE NW

FIRST REPORT

0

330 Ft. From S Line NW

990 Ft. From E Line Quarter

1st. Report APR 25 1951

Completion

Remarks

Spudding Date

Drlg. Data

Location

J. E. TYRA

