


Map No. _____ Sec. 10 Twp. 28 R. 4

Well No. 9 Miller Farm _____
Empire Company

NORTH

WEST

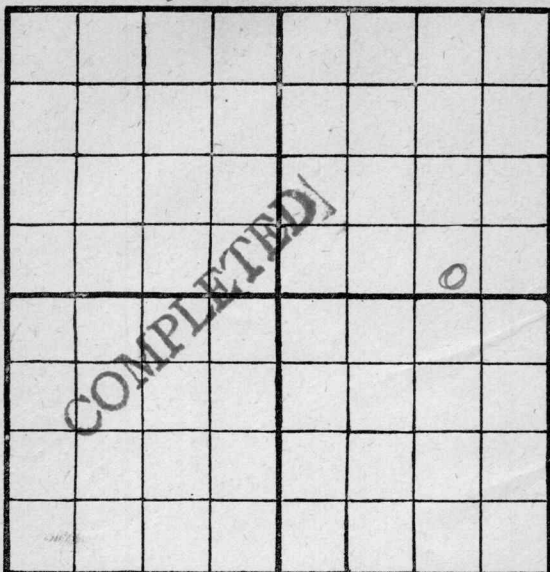

EAST

SOUTH

Location _____

Rig Up _____

Drilling Remarks:

Drilling Remarks:

RECORD

PRODUCTION

Cased _____ in. _____ ft.

1st 24 hrs. Nat. _____

Sand _____

1st 24 hrs. after shot _____

Gas _____

Gas _____ cu. ft

Oil _____

Dry Hole _____

Total Depth _____

Abandoned _____

Map No. 107 K11 Sec. 10 Twp. 28 R. 4Well No. 9 Miller FarmEmpire Company

NORTH

WEST

EAST

SOUTH

Location -----

Rig Up ✓ -----

Drilling and remarks

FIRST REPORT

RECORD

Cased ----- in ----- Ft.

Sand -----

Gas -----

Oil -----

Total Depth -----

PRODUCTION

1st 24 hrs. Nat. -----

1st 24 hrs. after shot -----

Gas ----- Cu. Ft.


Dry Hole -----

Abandoned -----

Date

4/26, 1918 Condy Scout

Map No. _____ Sec. 10 Twp. 28 R. 4
Well No. 9 Miller Farm _____
Company Company _____
NORTH

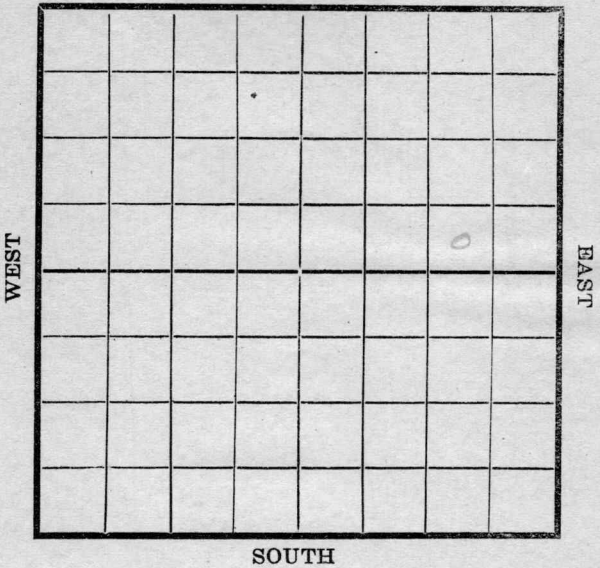

Location _____
Rig Up _____
Drilling and remarks

Spudding
Taylor Bros
Auguste
KS

RECORD

Cased _____ in _____ Ft.
Sand _____
Gas _____
Oil _____
Total Depth _____

PRODUCTION

1st 24 hrs. Nat. _____
1st 24 hrs. after shot _____
Gas _____ Cu. Ft.
Dry Hole _____
Abandoned _____

Date

3/22/18 191 8 *Candy* Scout

Map No. _____ Sec. 10 Twp. 28 R. 4Well No. 9 Miller Farm __________Engine Company

NORTH

WEST

EAST

SOUTH

Location _____

Rig Up _____

Drilling and remarks

775

RECORD

Cased _____ in _____ Ft

Sand _____

Gas _____

Oil _____

Total Depth _____

PRODUCTION

1st 24 hrs. Nat. _____

1st 24 hrs. after shot _____

Gas _____ Cu. Ft.

Dry Hole _____

Abandoned _____

Date

5/29/1918 Candy Scout

Map No. _____ Sec. 10 Twp. 28 R. 4


Well No. 9 Miller

Engine Company

Contractor

NORTH

WEST

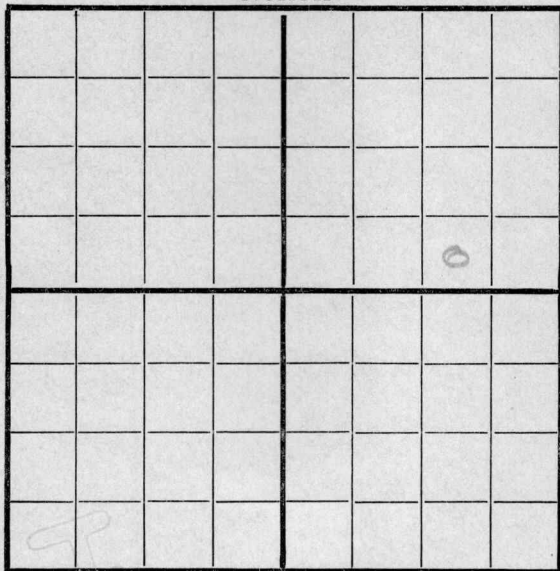

EAST

SOUTH

Location _____

Rig up _____

Drilling and Remarks:

1380

RECORD

Cased _____ in., _____ ft.

Sand _____

Gas _____

Oil _____

Total Depth _____

PRODUCTION

1st 24 hrs. Nat. _____

1st 24 hrs. after shot _____

Gas _____ Cu. Ft.

Dry Hole _____

Abandoned _____

Date

6/5

191

S. C. Cuddy

Scout

Map No. _____ Sec. 10 Twp. 28 R. 4Well No. 9 Miller

_____ Company

_____ Contractor

NORTH

WEST

EAST

SOUTH

Location _____

Rig up _____

Drilling and Remarks:

2160

RECORD

Cased _____ in., _____ ft.

Sand _____

Gas _____

Oil _____

Total Depth _____

PRODUCTION

1st 24 hrs. Nat. _____

1st 24 hrs. after shot _____

Gas _____ Cu. Ft.

Dry Hole _____

Abandoned _____

Date

6/12/28 Candiff Scout

Map No. _____ Sec. 10 Twp. 28 R. 4Well No. 9 Miller

_____ Company

_____ Contractor

NORTH

WEST

EAST

SOUTH

Location _____

Rig up _____

Drilling and Remarks:

SD
2160

RECORD

Cased _____ in., _____ ft.

Sand _____

Gas _____

Oil _____

Total Depth _____

PRODUCTION

1st 24 hrs. Nat. _____

1st 24 hrs. after shot _____

Gas _____ Cu. Ft.

Dry Hole _____

Abandoned _____

Date

6/19 191 8 Landry Scout

Map No. _____ Sec. 10 Twp. 28 R. 4Well No. 9 MillerEngineer Company

Contractor _____

NORTH

WEST

EAST

SOUTH

Location _____

Rig up _____

Drilling and Remarks:

2400

RECORD

Cased _____ in., _____ ft.

Sand _____

Gas _____

Oil _____

Total Depth _____

PRODUCTION

1st 24 hrs. Nat. _____

1st 24 hrs. after shot _____

Gas _____ Cu. Ft.

Dry Hole _____

Abandoned _____

Date

6/26 1918 C. Condy Scout

Map No. _____ Sec. 10 Twp. 28 R. 4Well No. 9 Miller_____
Company_____
Contractor

NORTH

WEST

EAST

SOUTH

Location _____

Rig up _____

Drilling and Remarks:

Top sand
2585

RECORD

Cased _____ in., _____ ft.

Sand _____

Gas _____

Oil _____

Total Depth _____

PRODUCTION

1st 24 hrs. Nat. _____

1st 24 hrs. after shot _____

Gas _____ Cu. Ft.

Dry Hole _____

Abandoned _____

Date

7/3 *191* *J. Condy* Scout

Map No. 1002 KH Sec. 10 Twp. 28 R. 4


Well No. 9 Miller

Company Empire

Contractor Taylor Bros

NORTH

WEST

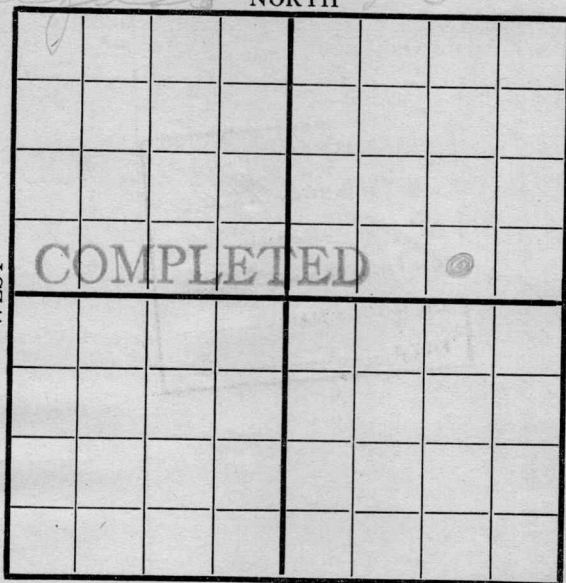

EAST

SOUTH

RECORD

Location _____

Cased _____ in., _____ ft.

Rig up _____

Sand 2585-2594

Drilling and Remarks:

Gas _____

Oil _____

Total Depth _____

Est at

150 Bbls

PRODUCTION

1st 24 hrs. Nat. _____

1st 24 hrs. after shot _____

Gas _____ Cu. Ft.

Dry Hole _____

Abandoned _____

Date

7/11 191 S. Condiff Scout