


Map No. 24 Sec. 10 Twp. 28 R. 4
Well No. 11 Miller Farm
Empire Company

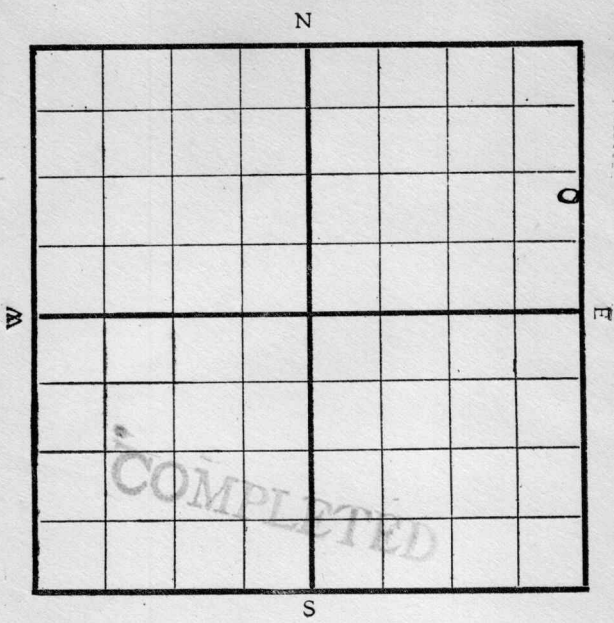

Location -----
Drilling Remarks:

RECORD

Cased ----- in. ----- ft.
Sand -----
Gas -----
Oil -----
Total Depth -----

Rig Up -----
Drilling Remarks:

PRODUCTION

1st 24 hrs. Nat. -----
1st 24 hrs. after shot -----
Gas ----- cu. ft.
Dry Hole -----
Abandoned -----

Map No. _____ Sec. 10 Twp. 28 R. 1Well No. 11. Miller FarmEmpire Gas & Fuel Company


Contractor

ME Quarter

_____ Ft. from N. Line

990 Ft. from S. Line330 Ft. from E. Line

_____ Ft. from W. Line

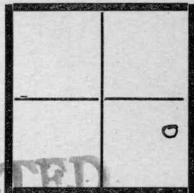Date 11/14 REPORT11/9 Rig up.
22 1560 water 1560.17/11 1560 for water21/11 — — — —6/3 2601-11 20 flb. oil8/4 3 flb. water

Map No. K11 Sec. 10 Twp. 28 R. 4Well No. 11 MillerEmpire Company

Contractor

SECTION PLAT

Ft. from N. Line

990 Ft. from S. Line330 Ft. from E. Line

Ft. from W. Line

			○

Location

Rig up ☒

Drilling and Remarks:

RECORD

Cased _____ in., _____ ft.

Sand _____

Gas _____

Oil _____

Total Depth _____

PRODUCTION

1st 24 hrs. Nat. _____

1st 24 hrs. after shot _____

Gas _____ Cu. Ft.

Dry Hole _____

Abandoned _____

Date


11/9 1919 Pyle Scout

Map No. K 11 Sec. 10 Twp. 28 R. 4

Well No. 11 Miller Farm

Empire Company.

NORTH

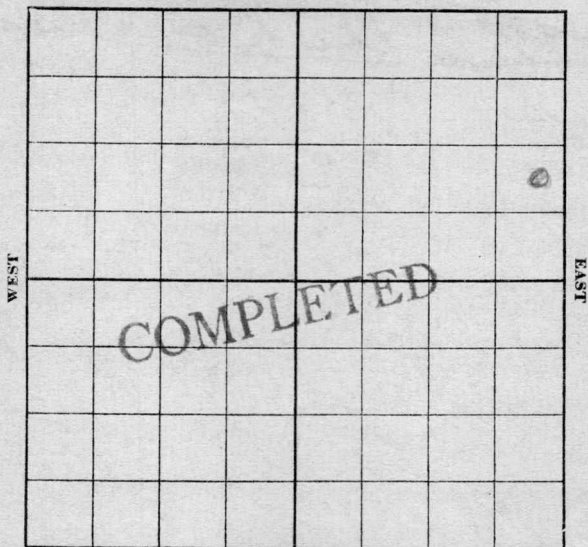

990 S

SOUTH

330 E

RECORD

Location

Cased in., ft.

Rig up

Sand 2601 - 2611

Drilling and Remarks:

Gas

Oil

Total Depth

PRODUCTION

1st 24 hrs. Nat.

1st 24 hrs. after shot

Gas Cu. Ft.

Dry Hole

Abandoned

Date

8/10

Pyie

Scout.