


Map No. _____ Sec. 10 Twp. 28 R. 4
 Well No. 7-H-Miller Farm _____
Empire Company

NORTH

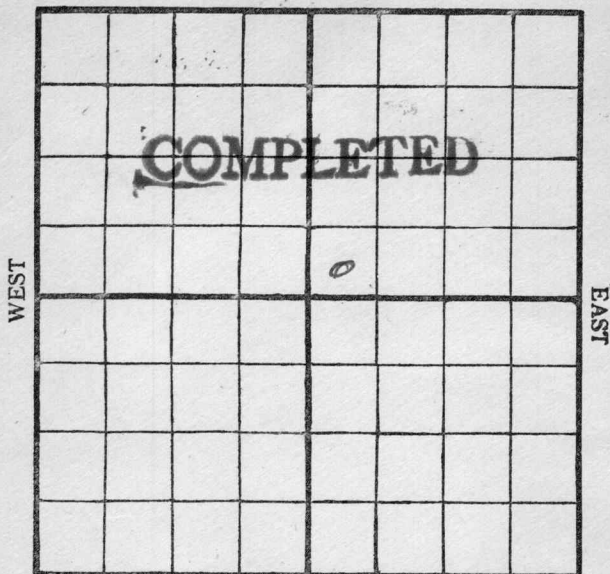

SOUTH

Location _____

Rig Up _____

Drilling Remarks:

Drilling Remarks:

RECORD

Cased _____ in. _____ ft.

Sand _____

Gas _____

Oil _____

Total Depth _____

PRODUCTION

1st 24 hrs. Nat. _____

1st 24 hrs. after shot _____

Gas _____ cu. ft


Dry Hole _____

Abandoned _____

Map No. _____ Sec. 10 Twp. 28 R. 4
Well No. 7 W W Miller Farm _____
Engine Company _____

NORTH

WEST

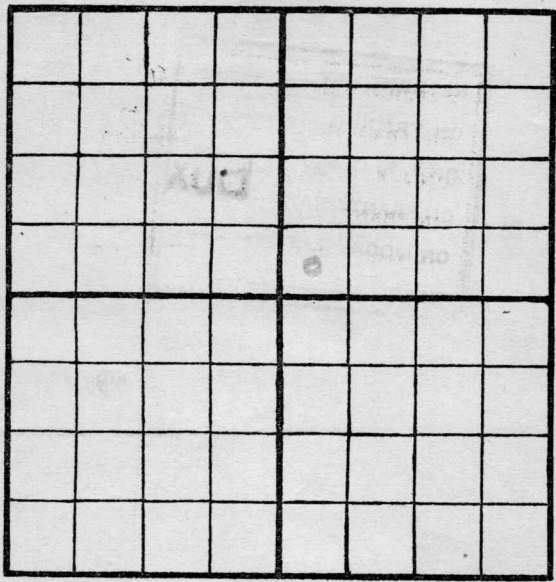

EAST

SOUTH

Location _____
Rig Up ☒ _____
Drilling and remarks _____

FIRST REPORT

RECORD

Cased _____ in. _____ Ft.
Sand _____
Gas _____
Oil _____
Total Depth _____

PRODUCTION


1st 24 hrs. Nat. _____
1st 24 hrs. after shot _____
Gas _____ Cu. Ft.
Dry Hole _____
Abandoned _____

Date 10/17, 1917 C. C. C. C. Scout _____

Map No. _____ Sec. 10 Twp. 28 R. 4Well No. 7 Miller Farm __________Empire Company

NORTH

WEST

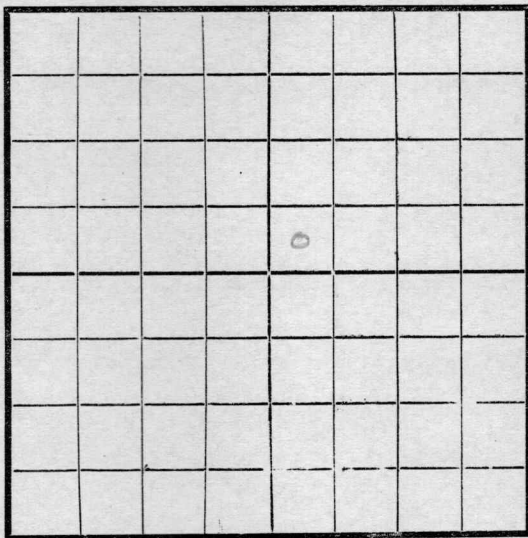

EAST

SOUTH

Location _____

Rig Up _____

Drilling and remarks

Open drilling

RECORD

Cased _____ in. _____ Ft.

Sand _____

Gas _____

Oil _____

Total Depth _____

PRODUCTION

1st 24 hrs. Nat. _____

1st 24 hrs. after shot _____

Gas _____ Cu. Ft.

Dry Hole _____

Abandoned _____


Date

10/31, 1917 Cordell Scout

Map No. _____ Sec. 10 Twp. 28 R. 4
 Well No. 7 Miller Farm _____
Engine Company _____

NORTH

WEST

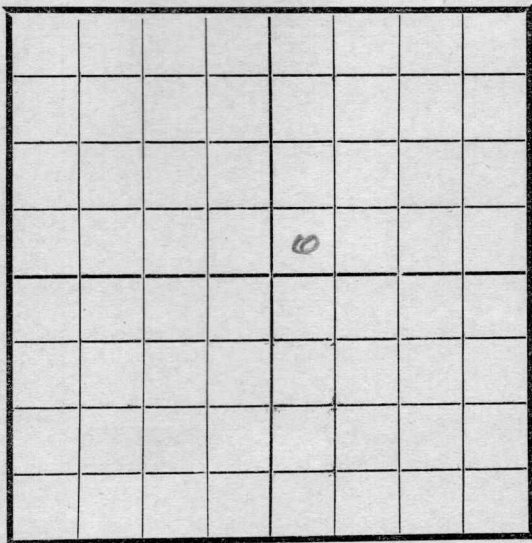

EAST

SOUTH

Location _____
 Rig Up _____
 Drilling and remarks

480

RECORD

Cased _____ in. _____ Ft.
 Sand _____
 Gas _____
 Oil _____
 Total Depth _____

PRODUCTION

1st 24 hrs. Nat. _____
 1st 24 hrs. after shot _____
 Gas _____ Cu. Ft.
 Dry Hole _____
 Abandoned _____


Date

11-7, 1917 Carley Scout

Map No. _____ Sec. 10 Twp. 28 R. 4Well No. 7 Miller Farm
Empire Company

NORTH

WEST

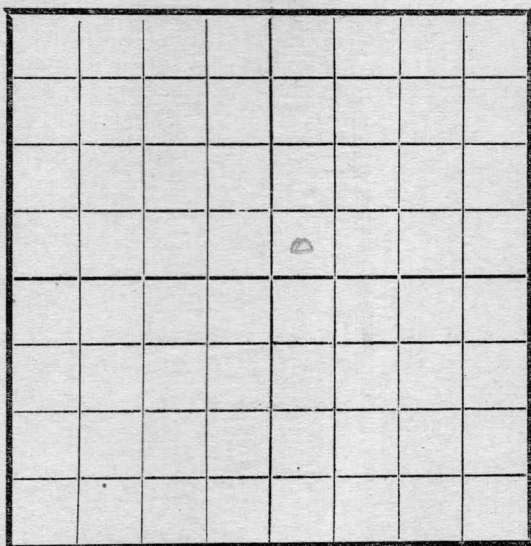

EAST

SOUTH

Location _____

Rig Up _____

Drilling and remarks

830

RECORD

Cased _____ in. _____ Ft.

Sand _____

Gas _____

Oil _____

Total Depth _____

PRODUCTION

1st 24 hrs. Nat. _____

1st 24 hrs. after shot _____

Gas _____ Cu. Ft.

Dry Hole _____

Abandoned _____


Date

11/14, 1917 C. Conley Scout

Map No. _____ Sec. 10 Twp. 28 R. 4Well No. 7 Miller Farm
Engine Company

NORTH

WEST

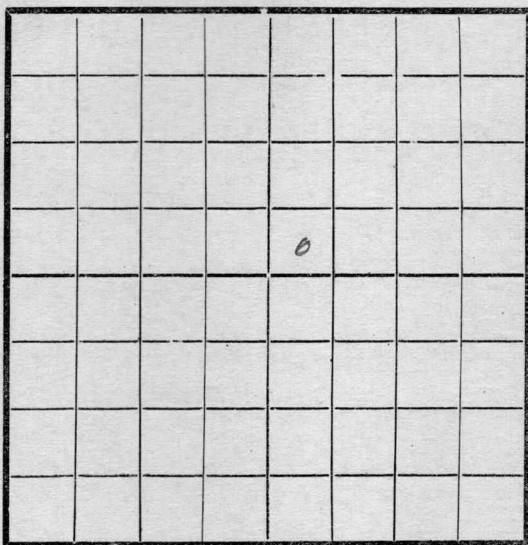

EAST

SOUTH

Location _____

Rig Up _____

Drilling and remarks

1350

RECORD

Cased _____ in. _____ Ft.

Sand _____

Gas _____

Oil _____

Total Depth _____

PRODUCTION

1st 24 hrs. Nat. _____

1st 24 hrs. after shot _____

Gas _____ Cu. Ft.

Dry Hole _____

Abandoned _____


Date

11/21, 1917 2 Carley Scout

Map No.----- Sec. 10 Twp. 28 R. 4
 Well No. 7 Miller Farm
Engine Company

NORTH

WEST

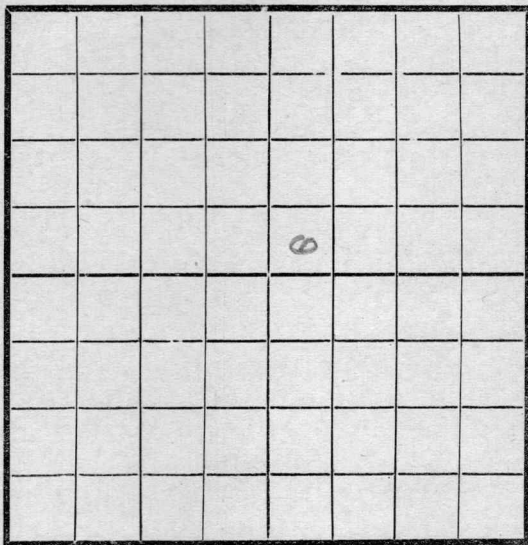

EAST

SOUTH

Location -----
 Rig Up -----
 Drilling and remarks

1750

RECORD

Cased ----- in. ----- Ft.
 Sand -----
 Gas -----
 Oil -----
 Total Depth -----

PRODUCTION

1st 24 hrs. Nat. -----
 1st 24 hrs. after shot -----
 Gas ----- Cu. Ft.
 Dry Hole -----
 Abandoned -----


Date

11/28, 1911 7 Cardiff Scout

Map No. _____ Sec. 10 Twp. 28 R. 4
 Well No. 7 Miller Farm _____
Empire Company _____

NORTH

WEST

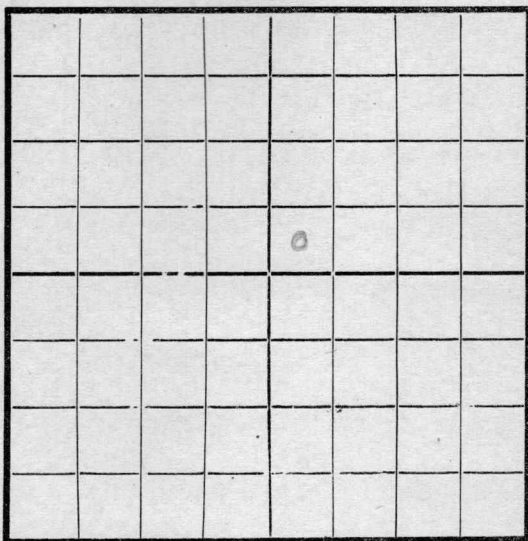

EAST

SOUTH

Location _____

Rig Up _____

Drilling and remarks

1880

RECORD

Cased _____ in. _____ Ft.

Sand _____

Gas _____

Oil _____

Total Depth _____

PRODUCTION

1st 24 hrs. Nat. _____

1st 24 hrs. after shot _____

Gas _____ Cu. Ft.

Dry Hole _____

Abandoned _____


Date

1915, 1917 Cordell Scout

Map No. _____ Sec. 10 Twp. 28 R. 4
 Well No. 7 Miller Farm _____
Engine Company _____

NORTH

WEST

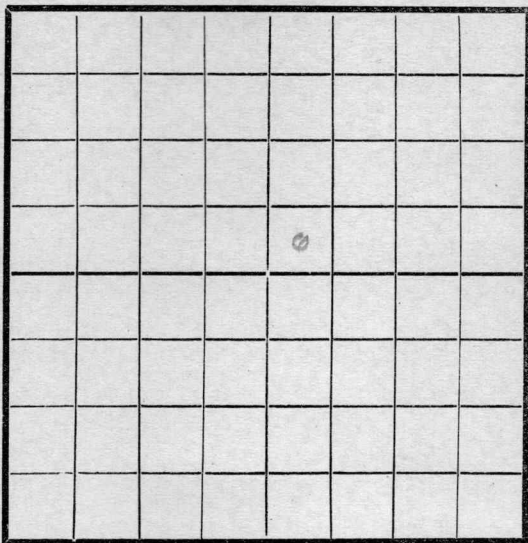

EAST

SOUTH

Location _____
 Rig Up _____
 Drilling and remarks _____

1890

RECORD

Cased _____ in. _____ Ft.
 Sand _____
 Gas _____
 Oil _____
 Total Depth _____

PRODUCTION

1st 24 hrs. Nat. _____
 1st 24 hrs. after shot _____
 Gas _____ Cu. Ft.
 Dry Hole _____
 Abandoned _____

Date

12/12, 1917 Conley Scout


Map No. _____ Sec. 10 Twp. 28 R. 4

Well No. 7 Miller Farm _____

Cummins Company _____

NORTH

WEST

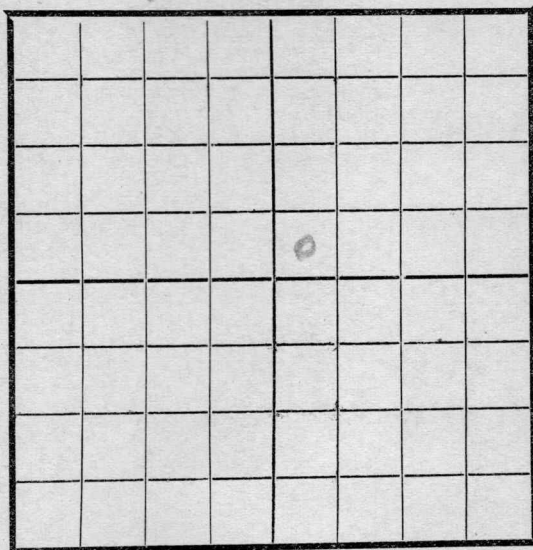

EAST

SOUTH

Location _____

Rig Up _____

Drilling and remarks

LD 1890

RECORD

Cased _____ in. _____ Ft.

Sand _____

Gas _____

Oil _____

Total Depth _____

PRODUCTION

1st 24 hrs. Nat. _____

1st 24 hrs. after shot _____

Gas _____ Cu. Ft.

Dry Hole _____

Abandoned _____


Date

12/19, 1917 Cummins Scout

Map No. _____ Sec. 10 Twp. 28 R. 4Well No. 7 Miller Farm _____Empire Gas & I Company _____

NORTH

WEST

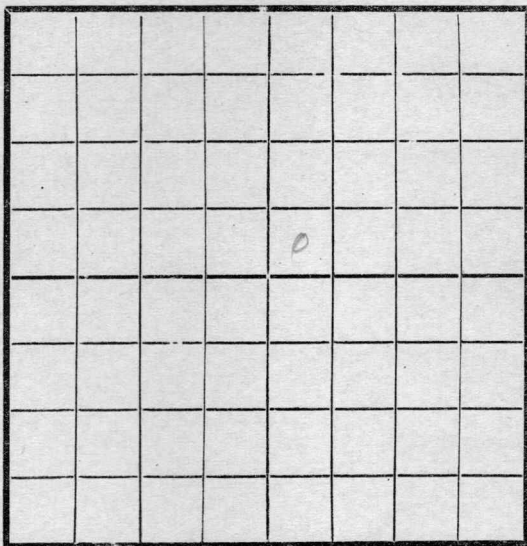

EAST

SOUTH

Location _____

Rig Up _____

Drilling and remarks

SD 1890**RECORD**

Cased _____ in. _____ Ft.

Sand _____

Gas _____

Oil _____

Total Depth _____

PRODUCTION

1st 24 hrs. Nat. _____

1st 24 hrs. after shot _____

Gas _____ Cu. Ft.

Dry Hole _____

Abandoned _____

Date


1/2, 1918 Conley Scout

Map No. _____ Sec. 10 Twp. 28 R. 4Well No. 7 Miller Farm _____

Company _____

NORTH

WEST

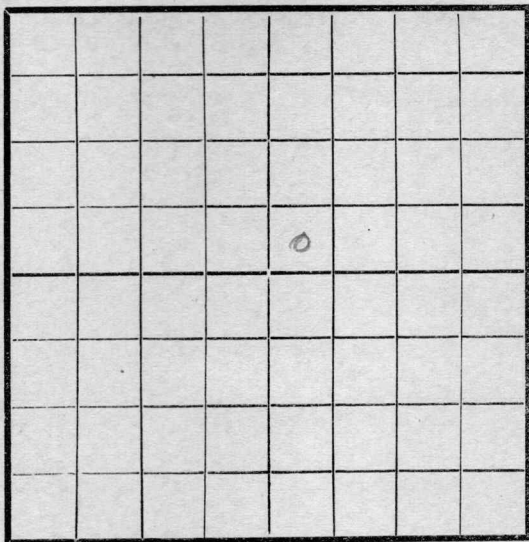

EAST

SOUTH

Location _____

Rig Up _____

Drilling and remarks

22 1890

RECORD

Cased _____ in. _____ Ft.

Sand _____

Gas _____

Oil _____

Total Depth _____

PRODUCTION

1st 24 hrs. Nat. _____

1st 24 hrs. after shot _____

Gas _____ Cu. Ft.

Dry Hole _____

Abandoned _____


Date

1/9, 1918 C. Conroy Scout

Map No. _____ Sec. 10 Twp. 28 R. 4Well No. 7 Miller Farm
Empire Company

NORTH

WEST

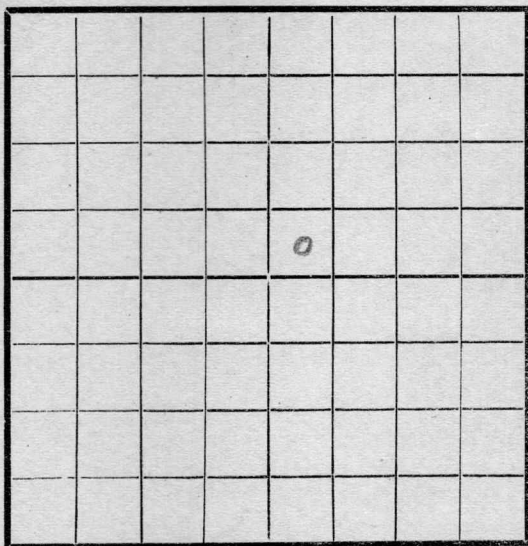

EAST

SOUTH

Location _____

Rig Up _____

Drilling and remarks

221910

RECORD

Cased _____ in. _____ Ft.

Sand _____

Gas _____

Oil _____

Total Depth _____

PRODUCTION

1st 24 hrs. Nat. _____

1st 24 hrs. after shot _____

Gas _____ Cu. Ft.

Dry Hole _____

Abandoned _____


Date

7/16, 1918 E. Condy Scout

Map No. _____ Sec. 10 Twp. 28 R. 4

Well No. 7 Miller Farm _____
Empire Company

NORTH

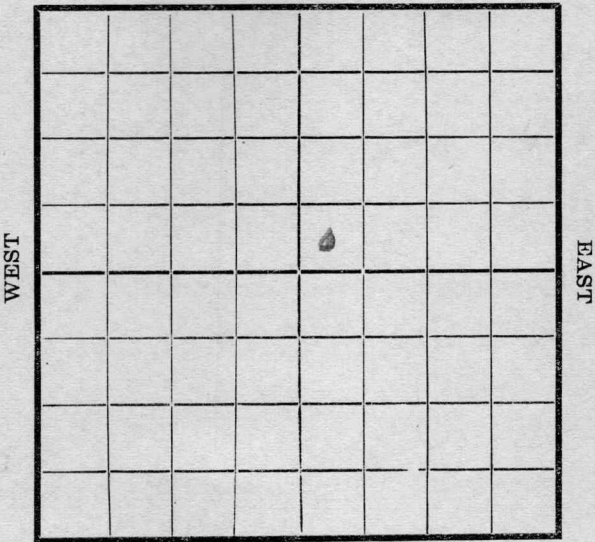

SOUTH

Location _____
Rig Up _____
Drilling and remarks

DD 1910

RECORD

Cased _____ in. _____ Ft.
Sand _____
Gas _____
Oil _____
Total Depth _____

PRODUCTION


1st 24 hrs. Nat. _____
1st 24 hrs. after shot _____
Gas _____ Cu. Ft.
Dry Hole _____
Abandoned _____

Date 1/23, 1918 _____ Scout _____

Map No. _____ Sec. 10 Twp 28 R. 4
Well No. 7 Miller Farm _____
Empire Company _____

NORTH

WEST

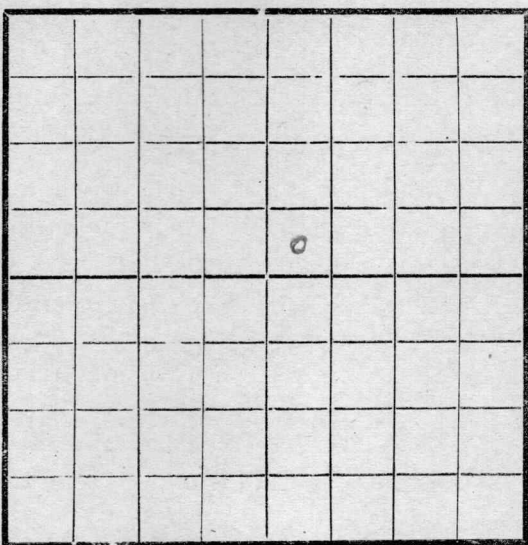


EAST

SOUTH

	RECORD
Location _____	Cased _____ in. _____ Ft.
Rig Up _____	Sand _____
Drilling and remarks	Gas _____
<u>2055</u>	Oil _____
	Total Depth _____
	PRODUCTION
	1st 24 hrs. Nat. _____
	1st 24 hrs. after shot _____
	Gas _____ Cu. Ft.
	Dry Hole _____
	Abandoned _____

Date 1/30, 1918 Scout

Map No. _____ Sec. 10 Twp. 28 R. 4
 Well No. 7 Miller Farm _____
Engine Company _____
 NORTH

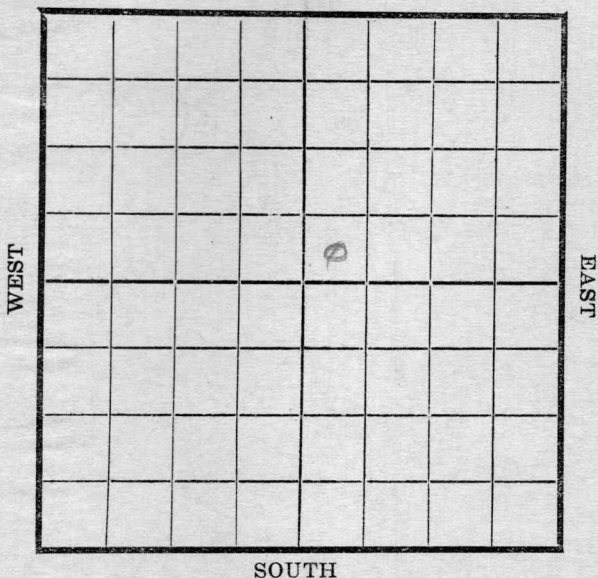

Location _____
 Rig Up _____
 Drilling and remarks

22 2055

RECORD

Cased _____ in. _____ Ft.
 Sand _____
 Gas _____
 Oil _____
 Total Depth _____

PRODUCTION

1st 24 hrs. Nat. _____
 1st 24 hrs. after shot _____
 Gas _____ Cu. Ft.
 Dry Hole _____
 Abandoned _____


Date

2/6, 1918 C. C. Dyer Scout

Map No. _____ Sec. 10 Twp. 28 R. 4
 Well No. 7 Miller Farm
Engine Company

NORTH

WEST

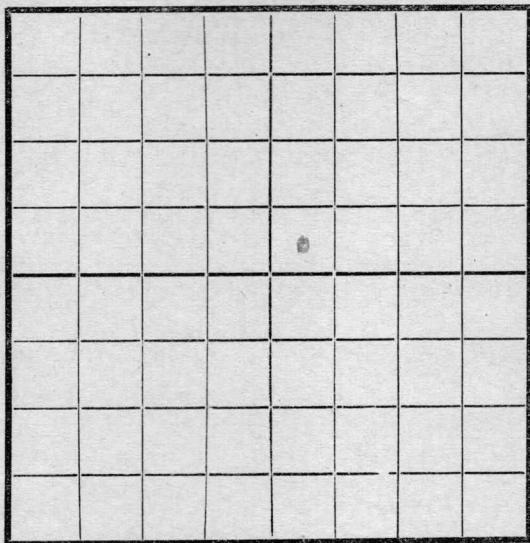

EAST

SOUTH

Location _____
 Rig Up _____
 Drilling and remarks

RECORD

Cased _____ in. _____ Ft.
 Sand _____
 Gas _____
 Oil _____
 Total Depth _____

PRODUCTION

1st 24 hrs. Nat. _____
 1st 24 hrs. after shot _____
 Gas _____ Cu. Ft.
 Dry Hole _____
 Abandoned _____


2095
Clyde Dill Co
Augusta
Kans

Date

7/13, 1918 C. Conley Scout

Map No. _____ Sec. 10 Twp. 28 R. 4
Well No. 7 Miller Farm _____
Engine Company _____

NORTH

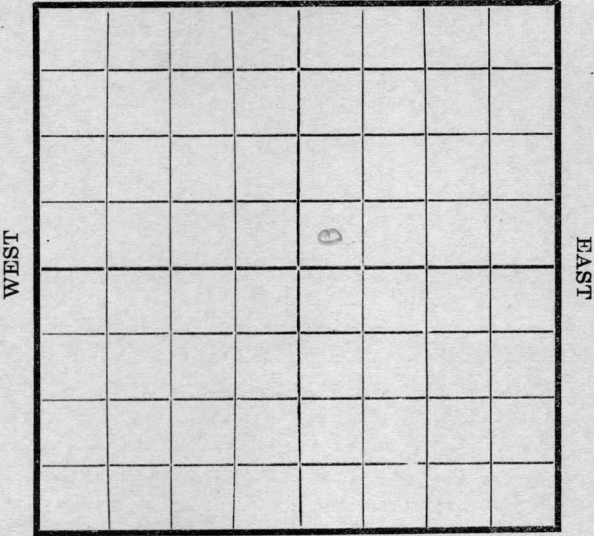

SOUTH

Location _____ Rig Up _____ Drilling and remarks <u>2095</u>	RECORD
	Cased _____ in. _____ Ft.
	Sand _____
	Gas _____
	Oil _____
	Total Depth _____
	PRODUCTION
	1st 24 hrs. Nat. _____
	1st 24 hrs. after shot _____
	Gas _____ Cu. Ft.
	Dry Hole _____
	Abandoned _____

Date 7/20, 1918 Scout

Map No. _____ Sec. 10 Twp. 28 R. 4Well No. 7 Miller Farm _____

_____ Company

NORTH

WEST

EAST

SOUTH

Location _____

Rig Up _____

Drilling and remarks

RECORD

Cased _____ in. _____ Ft.

Sand _____

Gas _____

Oil _____

Total Depth _____

PRODUCTION

1st 24 hrs. Nat. _____

1st 24 hrs. after shot _____

Gas _____ Cu. Ft.

Dry Hole _____

Abandoned _____

Date


4/27, 1918. Cordiff Scout

Sec. 10 Twp. 28 R. 4

Well No. 7 Miller Farm
Engle Company

NORTH

WEST

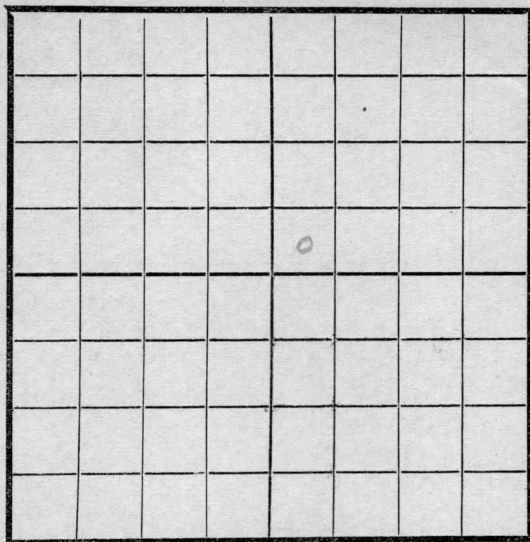

EAST

SOUTH

Location -----
 Rig Up -----
 Drilling and remarks

2365

RECORD

Cased ----- in. ----- Ft.
 Sand -----
 Gas -----
 Oil -----
 Total Depth -----

PRODUCTION


1st 24 hrs. Nat. -----
 1st 24 hrs. after shot -----
 Gas ----- Cu. Ft.
 Dry Hole -----
 Abandoned -----

Date 3/6, 1911 S. C. Cuddy Scout

Map No. _____ Sec. 10 Twp. 38 R. 4
 Well No. 7 Miller Farm _____
Engine Company _____

NORTH

WEST

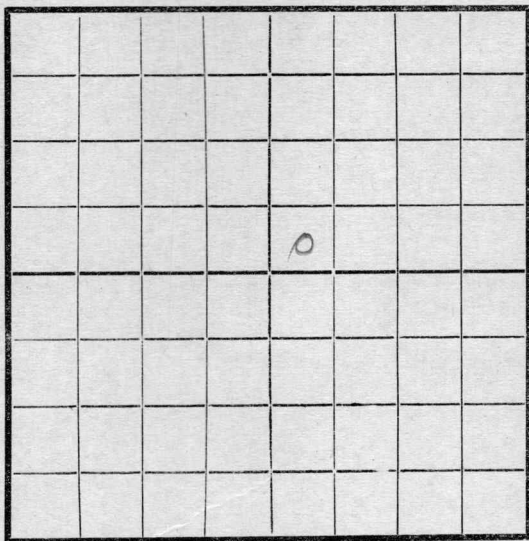

EAST

SOUTH

Location _____

Rig Up _____

Drilling and remarks

22 2365

RECORD

Cased _____ in. _____ Ft.
 Sand _____
 Gas _____
 Oil _____
 Total Depth _____

PRODUCTION

1st 24 hrs. Nat. _____
 1st 24 hrs. after shot _____
 Gas _____ Cu. Ft.
 Dry Hole _____
 Abandoned _____

Date


3/13, 1918 Scout

Map No. _____ Sec. 10 Twp. 28 R. 4

Well No. 7 Miller Farm _____
Empire Company

NORTH

WEST

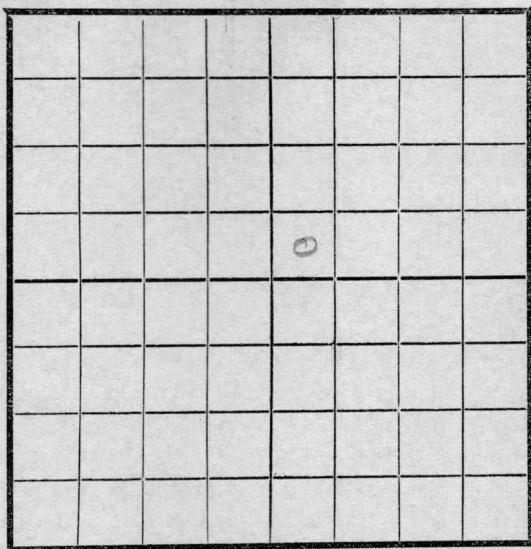

EAST

SOUTH


RECORD	
Location _____	Cased _____ in. _____ Ft.
Rig Up _____	Sand _____
Drilling and remarks <u>2550</u>	Gas _____
	Oil _____
	Total Depth _____
	PRODUCTION
	1st 24 hrs. Nat. _____
	1st 24 hrs. after shot _____
	Gas _____ Cu. Ft.
	Dry Hole _____
	Abandoned _____

Date 3/20, 1911 J. C. Cuddy Scout

Map No. _____ Sec. 10 Twp. 28 R. 4Well No. 7 Haller Farm __________Engine Company _____

NORTH

WEST

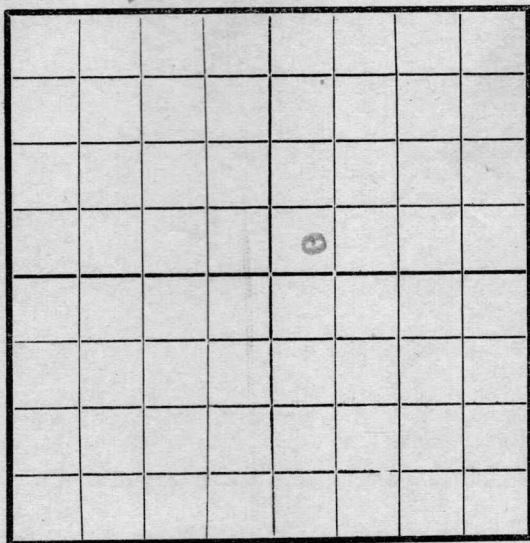

EAST

SOUTH

Location _____

Rig Up _____

Drilling and remarks

RECORD

Cased _____ in. _____ Ft.

Sand _____

Gas _____

Oil _____

Total Depth _____

PRODUCTION

1st 24 hrs. Nat. _____

1st 24 hrs. after shot _____

Gas _____ Cu. Ft.

Dry Hole _____

Abandoned _____

Date


3/27 1918 Clendy Scout

Map No. _____ Sec. 10 Twp. 28 R. 4

Well No. 7 Miller Farm _____

_____ Company

NORTH

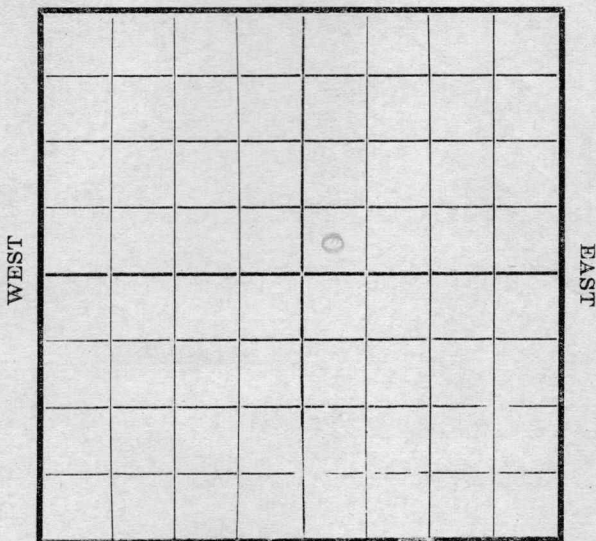

SOUTH

Location _____

Rig Up _____

Drilling and remarks

LD

2604

RECORD

Cased _____ in _____ Ft.

Sand _____

Gas _____

Oil _____

Total Depth _____

PRODUCTION

1st 24 hrs. Nat. _____

1st 24 hrs. after shot _____

Gas _____ Cu. Ft.

Dry Hole _____

Abandoned _____

Date

4/3, 1918 S. Condy Scout


Map No. K11 Sec. 10 Twp. 28 R. 4Well No. 7 million Farm _____

Company _____

NORTH

WEST

EAST

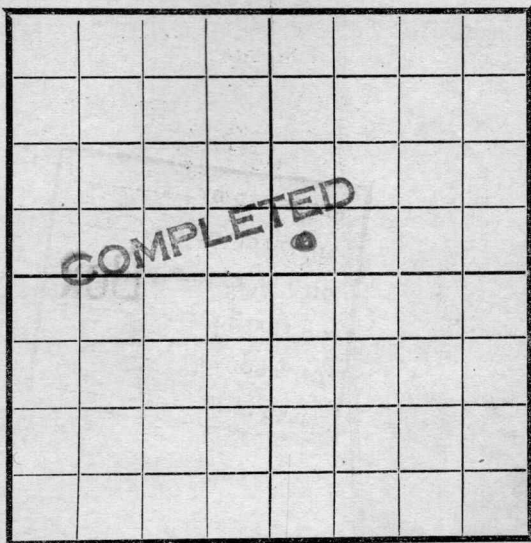

SOUTH

Location _____

Rig Up _____

Drilling and remarks

Est at
50 Bbls

RECORD

Cased _____ in. _____ Ft.

Sand 2591-2605

Gas _____

Oil _____

Total Depth _____

PRODUCTION

1st 24 hrs. Nat. _____

1st 24 hrs. after shot _____

Gas _____ Cu. Ft.

Dry Hole _____

Abandoned _____

Date

4/10, 1918 Condon Scout

Butler
 K11 KANSAS MAP No. _____ SEC. 10 TWP. 28S R. 4E
 WELL No. 7 *Hubb*
Empire COMPANY

CONTRACTOR _____

SECTION PLAT

ABANDONED

_____ FT. FROM N. LINE
 _____ FT. FROM S. LINE
 _____ FT. FROM E. LINE
 _____ FT. FROM W. LINE

RECORD

LOCATION _____
 RIG UP _____
 DRILLING AND REMARKS:

CASED _____ IN. _____ FT.
 SAND _____
 GAS _____
 OIL _____
 TOTAL DEPTH 26 24

PRODUCTION

1ST 24 HRS. NAT. _____
 1ST 24 HRS. AFTER SHOT _____
 GAS _____ CU. FT.
 DRY HOLE _____
 ABANDONED _____

DATE

5/28 1928

SCOUT