

# KANSAS Butler

Section 10 Township 28 Range 4E

Well No. 1 Moyle

Company Ailman & Broaden

Misc.

NORTH

WEST

EAST

							0

SOUTH

Butler

KANSAS ✓

Sec. 10 Twp. 28 R. 4E

Well No. #1 Moyle Farm \_\_\_\_\_

Aikman & Braden Company

Miscellaneous (Braden, Cont.)


NORTH

330' Ft. from N. Line

\_\_\_\_\_ Ft. from S. Line

330' Ft. from E. Line

\_\_\_\_\_ Ft. from W. Line

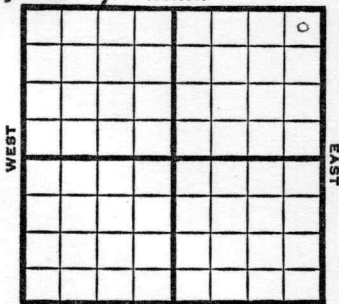

NE/C

1949

elev 1303'

REPORT

6/8

Location

6/15

15" @ 65'

13" @ 800'

Drlg. 865'

6/21

10" @ 1464'

Drlg. 1570'

6/28

KC 2091'

8" @ 2091'

Drlg. 2098'

7/6

Simpson 2590'

TD 2590'

7"@ 2590'

7/12

2631 UR 7"

7/20

Arb. 2623'

7"@ 2623'

TD 2631'

7/27

"

8/3

PB 2165'

6" @ 2097'

8/10

"

8/17

TD 2631'

Arb. 2623'

7"@ 2623'

2500 acid

Pump 10 oil Pot

38° Gr.

Comp

COMPLETED

Butler

County

Kansas

State

Map No.

Sec.

10

Twp.

28

R.

4E

Well No.

1 Moyle

Aikman & Braden

Company

Braden

Contractor

NE/C

FIRST REPORT SECTION PLAT

330

Ft. from N. Line

Ft. from S. Line

330


Ft. from E. Line

Ft. from W. Line


Miscellaneous

Remarks:

Location

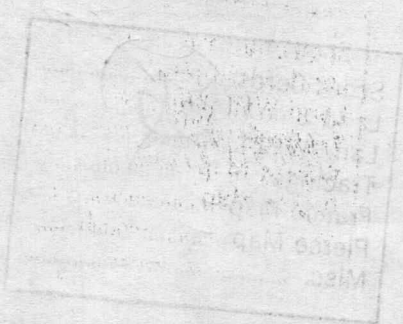

Date

JUN 8 1949

Scout

S. J. LEWIS

Map No. K11 Sec. 10 Twp. 28 R. 4E

Well No. 1 Moyle

Aikman & Braden Company

**COMPLETE** Contractor

NE/C

E 1, 1903  
SECTION PLAT

330 Ft. from N. Line

\_\_\_\_\_ Ft. from S. Line

330 Ft. from E. Line

\_\_\_\_\_ Ft. from W. Line

			0

Butler County

Location \_\_\_\_\_

Rig up \_\_\_\_\_

Drilling and Remarks:

*See 2623*

*7" @ 2623*

*2500 acid*

*Pump 100 oil 100 ft.*

*280/50*

**RECORD**

Cased \_\_\_\_\_ in., \_\_\_\_\_ ft.

Sand \_\_\_\_\_

Gas \_\_\_\_\_

Oil \_\_\_\_\_

Total Depth 2623

**PRODUCTION**

1st 24 hrs. Nat. \_\_\_\_\_

1st 24 hrs. after shot \_\_\_\_\_

Gas \_\_\_\_\_ Cu. Ft.

Dry Hole \_\_\_\_\_

Abandoned \_\_\_\_\_

Date

AUG 17 1949 19

S. J. LEWIS Scout