

Farm

Company


Drilling Remarks:

Drilling Remarks:

RECORD

Cased _____ in. _____ ft.

Sand _____

Gas _____

Oil _____

Total Depth_____

PRODUCTION

1st 24 hrs. Nat. _____

1st 24 hrs. after shot

Gas _____ cu. ft.

Dry Hole _____

Abandoned _____

Map No. 7 Sec. 11 Twp. 24 R. 12

Well No. 2 _____ Farm _____
Butch Lip _____ Company _____

660


~~1120~~ Ft. from N. Line

Ft. from S. Line

700

200 Ft. from E. Line

Ft. from W. Line

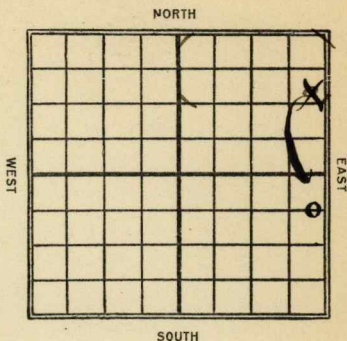

Date 1922

REPORT

2/18 dely 600'

3/26	Sand 1745-64. Shot 80 qts. 60 Bbls.
------	--

Map No. K 16 Sec. 11 Twp. 24 R. 12

Well No. 2 Dalton

Ruth Oil Co. Company

Contractor

1st. Report


SECTION PLAT

660 Ft. from N. Line

_____ Ft. from S. Line

200 Ft. from E. Line

_____ Ft. from W. Line

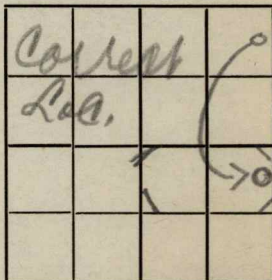

Location _____

Rig up _____

Drilling and Remarks:

sand 1743-64
shot 80 qts.
60 bbls.

Completed.

RECORD

Cased _____ in., _____ ft.

Sand _____

Gas _____

Oil _____

Total Depth _____

PRODUCTION

1st 24 hrs. Nat. _____

1st 24 hrs. after shot _____

Gas _____ Cu. Ft.

Dry Hole _____

Abandoned _____


Date

MAR 26 1922

M. A. BENEAR

Scout

map shows no well at
 this location. Also
 this is C. O. & Y. Co.
 acreage

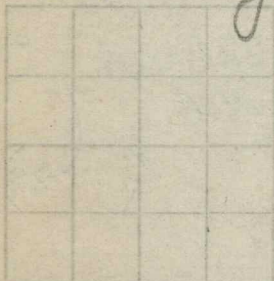

ft. from N. line

ft. from S. line

ft. from E. line

ft. from W. line

RECORD

Location

Returned

J. P. P.

Cards

Tracing

J. S. C. map

Frantz map

P

Moody map

J. P. P.

Moody plat book

Moody plat book

Date