


Map No. _____ Sec. 10 Twp. 28 R. 4
Well No. 3636 mayle Farm _____
Empire Company _____

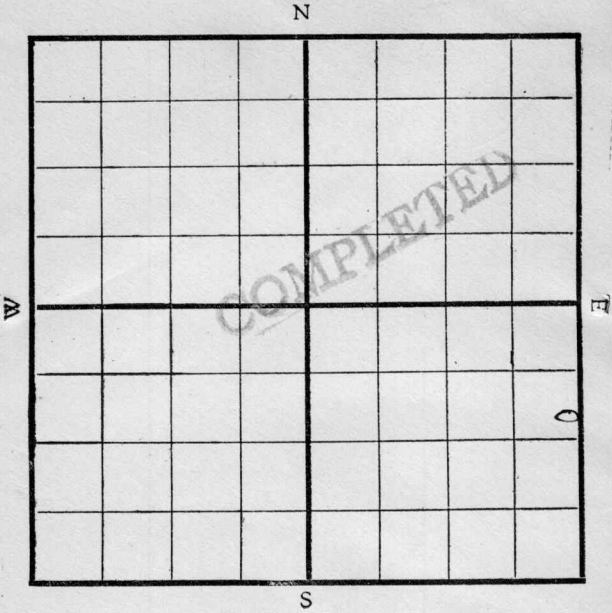

Location _____

Drilling Remarks:

RECORD

Cased _____ in. _____ ft.
Sand _____
Gas _____
Oil _____
Total Depth _____

Rig Up _____

Drilling Remarks:

PRODUCTION

1st 24 hrs. Nat. _____
1st 24 hrs. after shot _____
Gas _____ cu. ft.
Dry Hole _____
Abandoned _____

Map No. _____ Sec. 10 Twp. 28 R. 4Well No. 36 Moyle FarmEmpire Company_____
ContractorS E Quarter990 Ft. from N. Line_____
Ft. from S. Line330 Ft. from E. Line_____
Ft. from W. Line1919
Date

REPORT

11/13 Dr 130' FIRST REPORT
 22 Dr for water 130'
 17/11 Dr 130 for water
 2/11 - - -
 6/16 2558-72 22 Hls.

Map No. K 11 Sec. 10 Twp. 28 R. 4Well No. 36 Mayle

----- Company

----- Contractor

SECTION PLAT

990 Ft. from N. Line

----- Ft. from S. Line

330 Ft. from E. Line

----- Ft. from W. Line

Location -----

Rig up -----

Drilling and Remarks:

RECORD

Cased ----- in., ----- ft.

Sand -----

Gas -----

Oil -----

Total Depth -----

PRODUCTION

1st 24 hrs. Nat. -----

1st 24 hrs. after shot -----

Gas ----- Cu. Ft.

Dry Hole -----

Abandoned -----

Date

11/13 1919

Pyle

Scout

L1002
 Map No. K11 Sec. 10 Twp. 28 R. 4

Well No. 36 Moyle
Empire Company

Contractor

SECTION PLAT

990 Ft. from N. Line

_____ Ft. from S. Line

330 Ft. from E. Line

_____ Ft. from W. Line

COMPLETED

Location _____

Rig up _____

Drilling and Remarks:

RECORD

Cased _____ in., _____ ft.

Sand 2558-72

Gas _____

Oil _____

Total Depth _____

PRODUCTION

1st 24 hrs. Nat. 22 bbls

1st 24 hrs. after shot _____

Gas _____ Cu. Ft.

Dry Hole _____

Abandoned _____

Date

6/16 19120

Pyle

Scout