

Butler

Form 51-5M-3-26-22544

Map No. _____ Sec. 10 Twp. 28 R. 4


Well No. 44 - Moyle Farm _____
Empire Company _____

NORTH

WEST

EAST

SOUTH

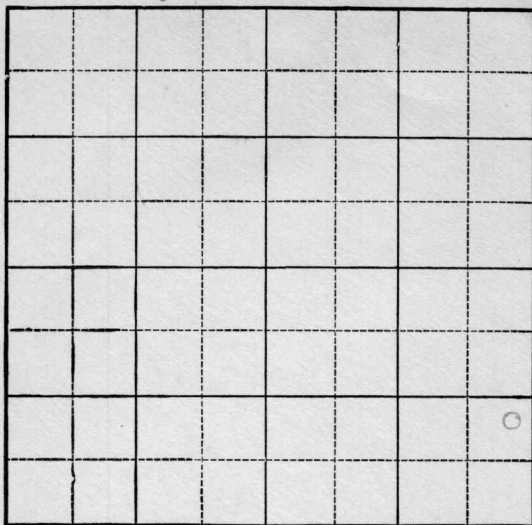

Location _____

Drilling Remarks _____

Rig Up _____

Drilling Remarks _____

RECORD

Cased _____ in. _____ ft.

Sand _____

Gas _____

Oil _____

Total Depth _____

PRODUCTION

1st 24 hrs. Nat. _____

1st 24 hrs. after shot _____

Gas _____ cu. ft.

Dry Hole _____

Abandoned _____

Kanson


Map No. _____ Sec. 10 Twp. 28 R. 4Well No. 44 - Moyle Farm _____Empire Company _____

_____ Ft. from N. Line

1120 Ft. from S. Line200 Ft. from E. Line

_____ Ft. from W. Line

NORTH

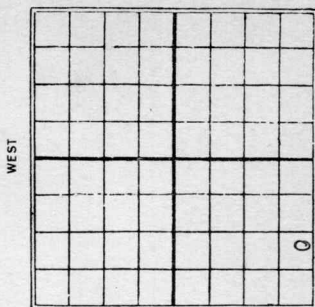

SOUTH

1927

Date

REPORT

3/1 Location

3/9

3/16 Rigging up

3/24 Spudding

3/30 Drlg 780

4/7 " 1350

4/13 " 1765

4/20 " 2360

4/27 ~~top sand 2457-59 - u.R. 6"~~

5/5 top sand 2557 (correction)

Pay 2564-66 - T.D. - 1400' oil

in hole in 16 hrs.

5/11 Sand 2557-2566'

Total Depth 2566'

50 bbls

11 KANSAS
 Map No. _____ Sec. 10 Twp. 28 R. 4
 Well No. 44
 Empire _____ Company
 _____ Contractor

FIRST REPORTS

_____ Ft. from N. Line

1120 _____ Ft. from S. Line

200 _____ Ft. from E. Line

_____ Ft. from W. Line

SECTION PLAT

			0

Location ✓ _____

Rig up _____

Drilling and Remarks:

RECORD

Cased _____ in., _____ ft.

Sand _____

Gas _____

Oil _____

Total Depth _____

PRODUCTION

1st 24 hrs. Nat. _____

1st 24 hrs. after shot. _____

Gas _____ Cu. Ft.

Dry Hole _____

Abandoned _____

Date

MAR 2 1927

CHAS. L. SHERWOOD

192

Scout

Map No. 11 KANSAS Sec. 10 Twp. 28 R. 4

Well No. 44 maybe

Empire Oil & Gas Co Company

Contractor

COMPLETED

SECTION PLAT

Ft. from N. Line

1120 Ft. from S. Line

200 Ft. from E. Line

Ft. from W. Line

			o

Location

Rig up

Drilling and Remarks:

RECORD

Cased 2557 in., 2566 ft.

Sand

Gas

Oil

Total Depth 2566

PRODUCTION

1st 24 hrs. Nat.

1st 24 hrs. after shot

Gas Cu. Ft.

Dry Hole

Abandoned

Date

MAY 11 1927

CHAS. L. SHERWOOD

192

Scout