


FORM 51 25M 3-49 PETROL

Section 10 Township 28 Range 4E

Well No. #50 Moyle

Company Cities Service Oil

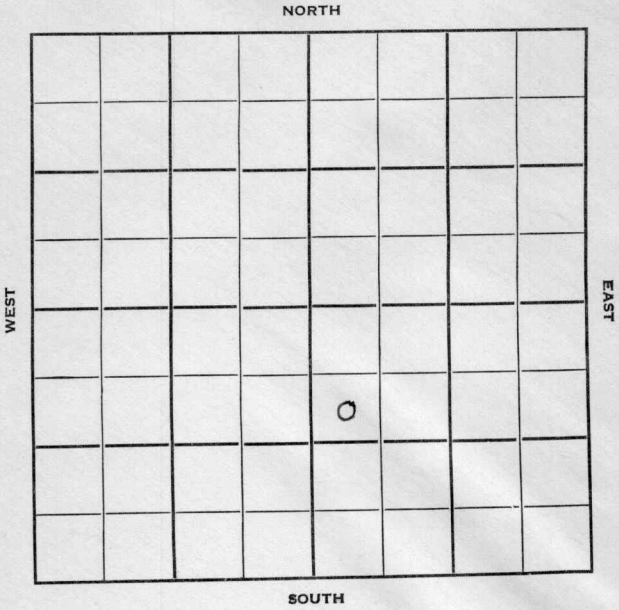

Sec. 10 Twp. 28 R. 4E

Well No. #50 Moyle Farm _____

Cities Service Oil

Augusta Pool (B & R Drlg., Contr.) Company _____


990' Ft. from N. Line

_____ Ft. from S. Line

_____ Ft. from E. Line

330' Ft. from W. Line

SW NW SE

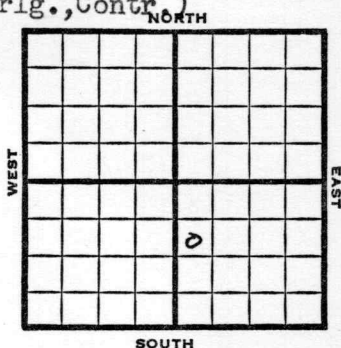

1950

Elev 1271' REPORT

1/4 Set 10" @ 80'
Simp sand 2560
TD 2567'
Rng. 5"

2/1 TD 2667'
10" @ 80'
5" @ 2666'
KC 2040'
BKC 2222
P 15 BO 8 hrs.
Comp

COMPLETED

Kansas


Map No. _____ Sec. 10 Twp. 28 R. 4EWell No. 50 Moyle

_____ Cities Service Oil _____ Company

_____ B & R Drlg. _____ Contractor

SW NW SE

SECTION PLAT

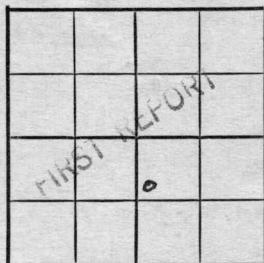990 Ft. from N. Line

_____ Ft. from S. Line

_____ Ft. from E. Line

330 Ft. from W. Line

Butler County

Location _____

Rig up _____

Drilling and Remarks:

Set 10" @ 80'

Simp. sand

2560-67 TD

Rng. 5"

RECORD

Cased _____ in., _____ ft.

Sand _____

Gas _____

Oil _____

Total Depth _____

PRODUCTION

1st 24 hrs. Nat. _____

1st 24 hrs. after shot _____

Gas _____ Cu. Ft.

Dry Hole _____

Abandoned _____

Date

JAN 4 1950 19J.E. Tyra Scout

Kansas

Augusta Pool

Map No. _____ Sec. 10 Twp. 28 R. 4EWell No. 50 Moyle

Cities Service

Company


Contractor

SW NW SE

E. 1271
SECTION PLAT990 Ft. from N. Line

_____ Ft. from S. Line

_____ Ft. from E. Line

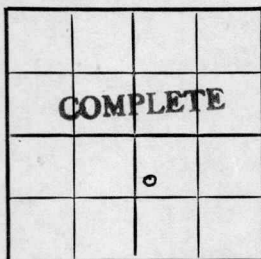330 Ft. from W. Line

Butler County

Location _____

Rig up _____

Drilling and Remarks:

10" @ 80
 5" @ 2666
 K.C. 2040
 B.K.C. 2222

P 15 B 0 8 hrs.

RECORD

Cased _____ in., _____ ft.

Sand _____

Gas _____

Oil _____

Total Depth 2573 2667

PRODUCTION

1st 24 hrs. Nat. _____

1st 24 hrs. after shot _____

Gas _____ Cu. Ft.

Dry Hole _____

Abandoned _____

Date

J. E. TYRA

FEB 1 1950 19

Scout