


Form 51-5M-4-27-27423

Map No. **KANSAS** Sec. **6** Twp. **24** R. **12**

Well No. 1 - Smith Farm
Prairie & Parrish Company

NORTH

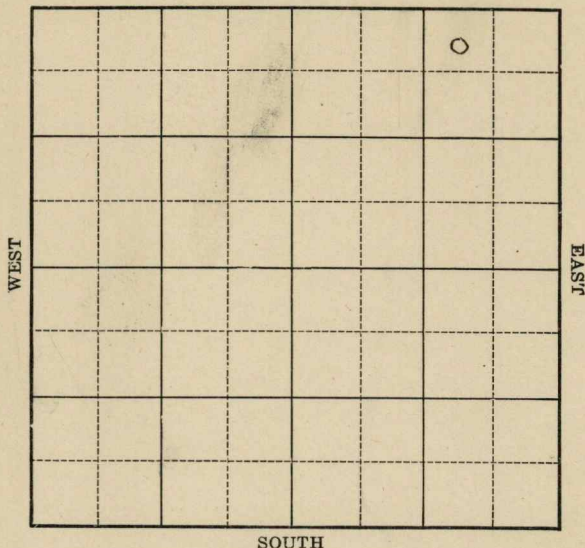

Location _____

Drilling Remarks

Rig Up.....

Drilling Remarks

RECORD

Cased _____ in. _____ ft.

Sand

Gas

Oil _____

Total Depth

PRODUCTION

1st 24 hrs. Nat. _____

1st 24 hrs. after shot_____

Gas _____ cu. ft.

Dry Hole_____

Abandoned


Map No. **KANSAS** Sec. 6 Twp. 24 R. 12
Well No. 1 - Smith Farm
Prairie & Parrish Company

330 Ft. from N. Line

_____ Ft. from S. Line

990 Ft. from E. Line

_____ Ft. from W. Line

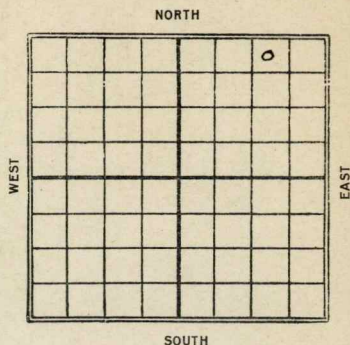

1928

Date	REPORT
9/19	<u>Rig up.</u>
9/26	<u> </u>
10/3	<u> </u>
10/10	<u> </u>
10/17	<u>drilg 425'</u>
10/24	<u>S.D. 425'</u>
10/31	<u> </u>
11/7	<u>S.D. 610'</u>
11/14	<u> </u>
11/21	<u>S.D. 1150'</u>
11/28	<u>Drilg 1400'</u>
12/5	<u>Top line 1817'</u> <u>run 6" csg.</u>
12/12	<u> </u>
12/19	<u>Top line 1821'</u> <u>shot 40 gts 1832-42'</u> <u>show of oil</u> <u>T.D. 1880'</u> <u>Dry & Abandoned</u>

K16 KANSAS

MAP No. _____ SEC. 6 TWP. 24 R. 12WELL No. 1 SmithPrairie & Parrish COMPANY

CONTRACTOR

FIRST REPORTS.

SECTION PLAT

			0

330 FT. FROM N. LINE

_____ FT. FROM S. LINE

990 FT. FROM E. LINE

_____ FT. FROM W. LINE

LOCATION _____

RIG UP _____

DRILLING AND REMARKS:

RECORD

CASED _____ IN. _____ FT.

SAND _____

GAS _____

OIL _____

TOTAL DEPTH _____

PRODUCTION

1ST 24 HRS. NAT. _____

1ST 24 HRS. AFTER SHOT _____

GAS _____ CU. FT.

DRY HOLE _____

ABANDONED _____

DATE

SEP 19 1928

CHAS. L. SHERWOOD

192

SCOUT

B. M. Wood

Map No. K16 Sec. 6 Twp. 74 R. 12
 Well No. 1 Smith

Prairie & Parrish Company

Contractor

COMPLETED

SECTION PLAT

330 Ft. from N. Line

Ft. from S. Line

990 Ft. from E. Line

Ft. from W. Line

ABANDONED

			0

Location

Rig up

Drilling and Remarks:

Top line 1871'

407 1832-42' Show
oil

D 24 1880

RECORD

Cased in, ft.

Sand

Gas

Oil

Total Depth 1880

PRODUCTION

1st 24 hrs. Nat.

1st 24 hrs. after shot

Gas Cu. Ft.

Dry Hole ☒

Abandoned ☒

Date

DEC 19 1928 CHAS. L. SHERWOOD

192 Scout