


SECTION 7 TOWNSHIP 24 RANGE 12E

WELL NO. #1 Berry

COMPANY H. Ulrich

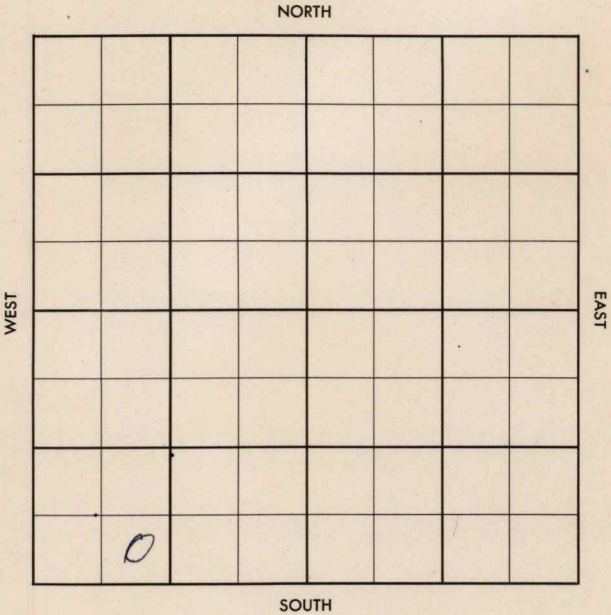

County Greenwood Elev. _____ Co.
 Sec. 7 Twp. 24 Rge. 12E
 Company H. Ulrich
 Farm Name Berry No. 1

TOPS	DEPTH	LOG	DATUM	Loc. in Sec.
Anh.				SE SW SW
Tr.				
H.				
Tr.				
Dg.				
Bl.				
L.				Geol. _____
K.C.				Contr. _____
B.K.C.				Eureka
Ce.				Pool
C.				
M.				
M.				
K.				
Mz.				
Mq.				
V.				
S.				
S.				
A.				
R.				
Pe.				
G.				
T.D.				

FIRST REPORT


DEC 12 56

Date Comm. 12-7-56
8" @ 80/75 drlg. 1500

81

County Greenwood Elev. _____
 Sec. 7 Twp. 24 Rge. 12E
 Company H. Ulrich
 Farm Name Berry No. 1

TOPS	DEPTH	LOG	DATUM	Loc. in Sec. _____
Anh.				SE SW SW
Tp.				
H.				
Tr.				
Dg.				
Bl.				
L.				Geol. _____
K.C.				Contr. _____
B.K.C.				Eureka
Ce. <u>CAH. 15d 1560-1000</u>				Pool _____
C.				
M.				
M.				
K.				
Mz.				
Mq.				
V.				
S.				
S.				
A.				
R.				
PE.				
G.				
T.D.	<u>1620</u>			

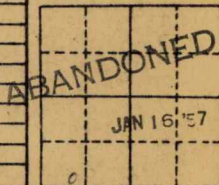

Date Comm. 12-7-56

8" @ 80/75 drlg. 1500 DEC 13 '56 DEC 26 '56

JAN 2 '57

JAN 9 '57

JAN 16 '57

No money for pipe.
 Temp Abd.