

Section 7 Township 24 Range 12E

Well No. 1 Fry

Company White & Ellis et al

Misc.

NORTH

WEST

EAST

				0			

SOUTH

Greenwood

KANSAS

Sec. 7 Twp. 24 R. 12E


Well No. #1 Fry Farm

White & Ellis et al

Company

Miscellaneous (White & Ellis, Cont.)

NORTH

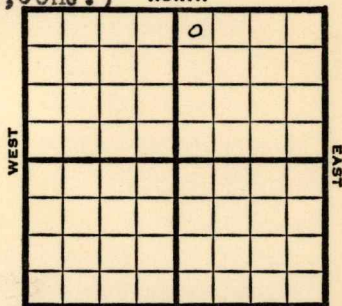

330' Ft. from N. Line

Ft. from S. Line

Ft. from E. Line

330' Ft. from W. Line

NW NE

SOUTH

1949

REPORT

10/19 Location

10/26 8" @ 93'

Drlg. 970'

11/1 "

11/9 "

11/16 TD 1795'

Miss 1772'

5" @ 1775'

Pump 50 Oil Pot

38° Gr.

Comp

COMPLETED

Map No. _____ Sec. 7 Twp. 24 R. 12E


Well No. 1 Fry

White & Ellis etal. Company

White & Ellis Contractor

NW NE

**FIRST REPORT
SECTION PLAT**

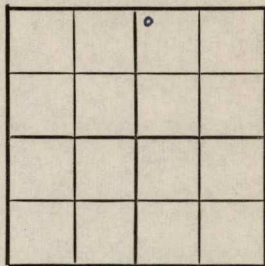

330 Ft. from N. Line

_____ Ft. from S. Line

_____ Ft. from E. Line

330 Ft. from W. Line

Greenwood County

Location X

Rig up _____

Drilling and Remarks:

RECORD

Cased _____ in., _____ ft.

Sand _____

Gas _____

Oil _____

Total Depth _____

PRODUCTION

1st 24 hrs. Nat. _____

1st 24 hrs. after shot _____

Gas _____ Cu. Ft.

Dry Hole _____

Abandoned _____

Date

OCT 19 1949

S. J. LEWIS Scout

Map No. _____ Sec. 7 Twp. 24 R. 12E

Well No. 1 Fry

White & Ellis etal. Company

COMPLETE Contractor

NW NE


SECTION PLAT

330 Ft. from N. Line

_____ Ft. from S. Line

_____ Ft. from E. Line

330 Ft. from W. Line

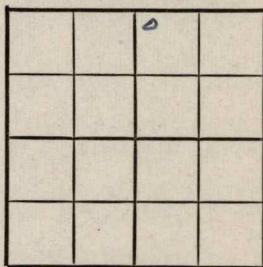

Greenwood County

Location _____

Rig up _____

Drilling and Remarks:

Mis 1772

5' @ 1775

Prod 50 oil ft

35' su

RECORD

Cased _____ in., _____ ft.

Sand _____

Gas _____

Oil _____

Total Depth 1785

PRODUCTION

1st 24 hrs. Nat. _____

1st 24 hrs. after shot _____

Gas _____ Cu. Ft.

Dry Hole _____

Abandoned _____

Date

NOV 16 1949 19

S. J. LEWIS Scout