

Map No. _____ Sec. 11 Twp. 28 R. 4Well No. 25 J N Hazlet Farm _____Muehlen Company _____

NORTH

WEST

EAST

COMPLETED

SOUTH

Location _____

Rig Up 7/5

Drilling Remarks:

Drilling Remarks:

10/2 - 1760 Drilling10/11 - Rig skidded10/18 - Spuddling10/23 - 1100640 = 11/9700 = 11/141610 = 11/271760 = 12/4 = 12/11 =1780 = 12/18 = 12/28 = 1/16 = 1/8/17 = 1/15 =

RECORD

Cased _____ in _____ Ft.

Sand _____

Gas _____

Oil _____

Total Depth _____

PRODUCTION

1st 24 hrs. Nat. _____

1st 24 hrs. after shot _____

Gas _____ Cu. Ft.


Dry Hole _____

Abandoned _____

Map No. _____ Sec. 11 Twp. 38 R. 4
 Well No. 58 W. Maguire Farm _____
Wichita Company _____

NORTH

WEST

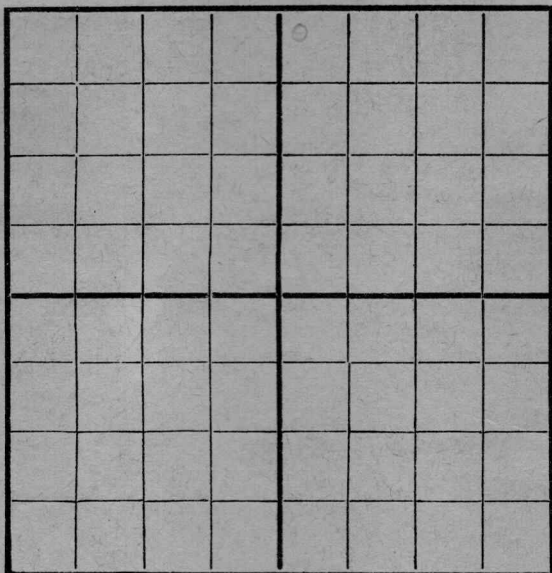

EAST

SOUTH

Location _____
 Rig Up _____
 Drilling and remarks _____

RECORD

Cased _____ in. _____ Ft.
 Sand _____
 Gas _____
 Oil _____
 Total Depth _____

PRODUCTION

1st 24 hrs. Nat. _____
 1st 24 hrs. after shot _____
 Gas _____ Cu. Ft.
 Dry Hole _____
 Abandoned _____


Date

7/5, 1915, Scout

Map No. _____ Sec. 11 Twp. 28 R. 4
Well No. 5 Haylett Farm
Amesbury Company

NORTH

WEST

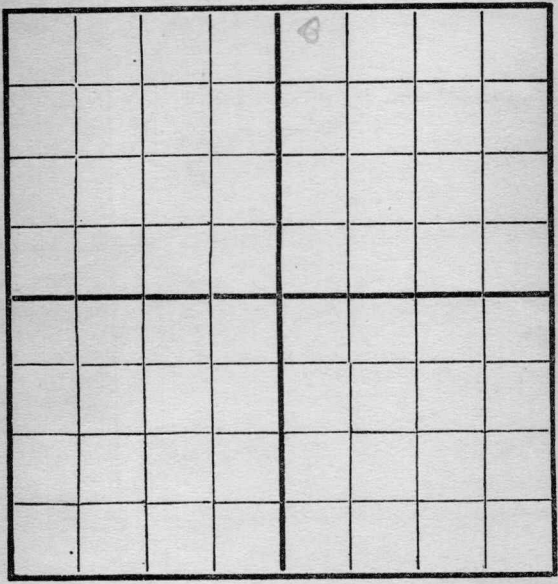

EAST

SOUTH

Location _____
Rig Up _____
Drilling and remarks

1735 gas
2 1/2 cu

RECORD

Cased _____ in. _____ Ft.
Sand _____
Gas _____
Oil _____
Total Depth _____


PRODUCTION

1st 24 hrs. Nat. _____
1st 24 hrs. after shot _____
Gas _____ Cu. Ft.
Dry Hole _____
Abandoned _____

Date 8/8, 1916 Reed Scout

Map No. _____ Sec. 11 Twp. 28 R. 4
 Well No. 5 Hazlett Farm _____
Empire Company _____

NORTH

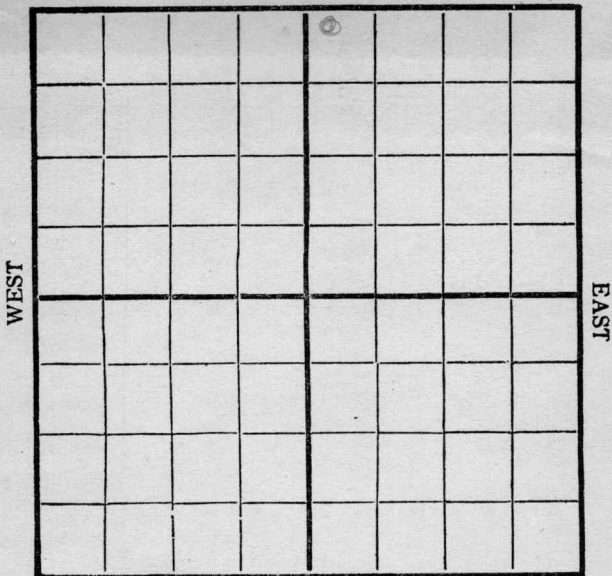

SOUTH

Location _____
 Rig Up _____
 Drilling and remarks _____

1760' Fishing

RECORD

Cased _____ in. _____ Ft.
 Sand _____
 Gas _____
 Oil _____
 Total Depth _____

PRODUCTION


1st 24 hrs. Nat. _____
 First 24 hrs. after shot _____
 Gas _____ Cu. Ft.
 Dry Hole _____
 Abandoned _____

Date

8/14, 1916 Acordiff Scout

Map No. _____ Sec. 11 Twp. 28 R. 4
 Well No. 5 Hazlett Farm _____
Empire Company _____

NORTH

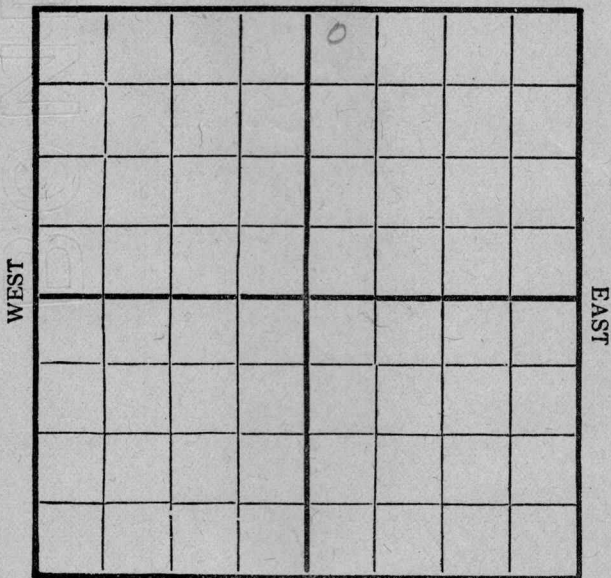

SOUTH

Location _____
 Rig Up _____
 Drilling and remarks _____

*Fishing -
 1 hole collapsed
 casing in
 hole*

RECORD

Cased _____ in. _____ Ft.
 Sand _____
 Gas _____
 Oil _____
 Total Depth _____

PRODUCTION


1st 24 hrs. Nat. _____
 First 24 h. s. after shot _____
 Gas _____ Cu. Ft.
 Dry Hole _____
 Abandoned _____

Date 8/31, 1916 Scout

Map No. _____ Sec. 11 Twp. 28 R. 4
 Well No. 5 Higlett Farm _____
Empire Company _____

NORTH

WEST

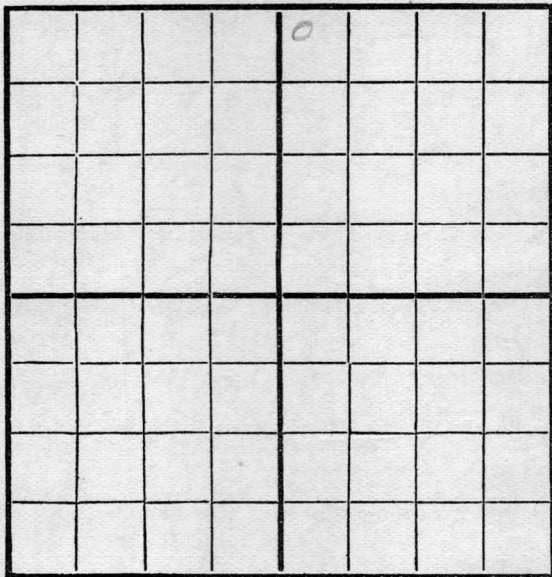

EAST

SOUTH

Location _____
 Rig Up _____
 Drilling and remarks _____

RECORD

Cased _____ in. _____ Ft.
 Sand _____
 Gas _____
 Oil _____
 Total Depth _____

PRODUCTION

1st 24 hrs. Nat. _____
 1st 24 hrs. after shot _____
 Gas _____ Cu. Ft.
 Dry Hole _____
 Abandoned _____

Date

191

Scout


1760
Collapsed
Casing
AUG 30 1916

L. C. Corbett

Map No. _____ Sec. 11 Twp. 28 R. 4Well No. 5 Haylett FarmEmpire Company

NORTH

WEST

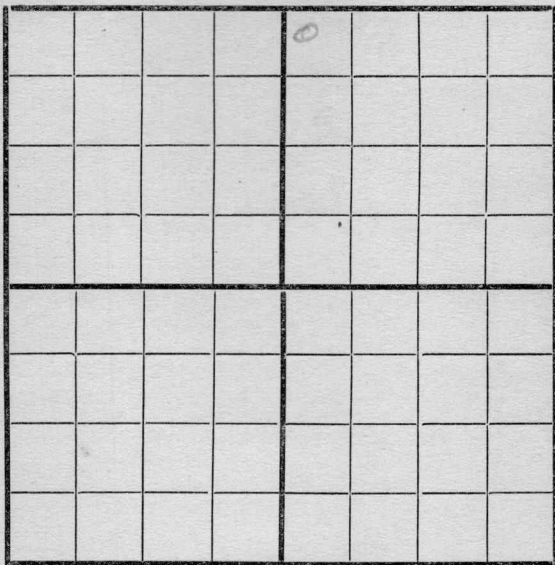

EAST

SOUTH

Location _____

Rig Up _____

Drilling and remarks

Fishing
Hole Collapsed
Coaming

RECORD

Cased _____ in. _____ Ft.

Sand _____

Gas _____

Oil _____

Total Depth _____

PRODUCTION

1st 24 hrs. Nat. _____

1st 24 hrs. after shot _____

Gas _____ Cu. Ft.

Dry Hole _____

Abandoned _____


Date

9/4, 1916 L. B. Bailey Scout

Map No. _____ Sec. 11 Twp. 28 R. 4
 Well No. 5 Hazlett Farm _____
Engine Company _____

NORTH

WEST

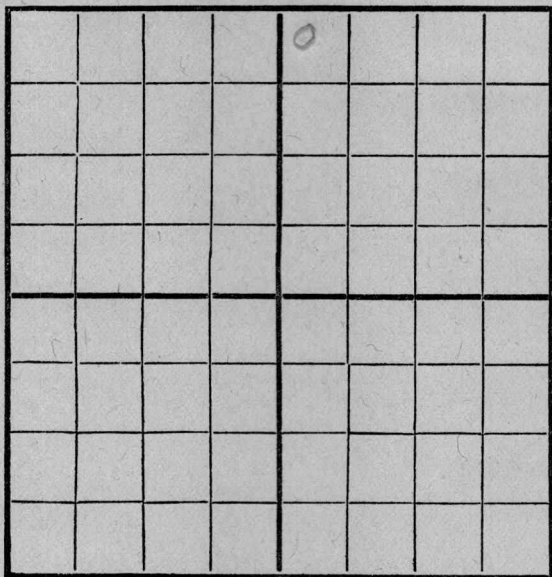

EAST

SOUTH

Location _____

Rig Up _____

Drilling and remarks

*Still fishing
at 1760*

RECORD

Cased _____ in. _____ Ft.

Sand _____

Gas _____

Oil _____

Total Depth _____

PRODUCTION

1st 24 hrs. Nat. _____

1st 24 hrs. after shot _____

Gas _____ Cu. Ft.

Dry Hole _____

Abandoned _____

Date

9/12, 1916 Scout Scout

Map No. _____ Sec. 11 Twp. 28 R. 4
 Well No. 5-1022 Farm _____
 _____ Company _____

NORTH

SOUTH

Location _____
 Rig Up _____
 Drilling and remarks _____

Fishing Job
Shut Down

RECORD

Cased _____ in. _____ Ft.
 Sand _____
 Gas _____
 Oil _____
 Total Depth _____

PRODUCTION

1st 24 hrs. Nat. _____
 1st 24 hrs. after shot _____
 Gas _____ Cu. Ft.
 Dry Hole _____
 Abandoned _____


Date

9/18, 1916 Scout

Map No. _____ Sec. 11 Twp. 28 R. 4
 Well No. 5 Hogsett Farm _____
Cuyahoga Company _____

NORTH

WEST

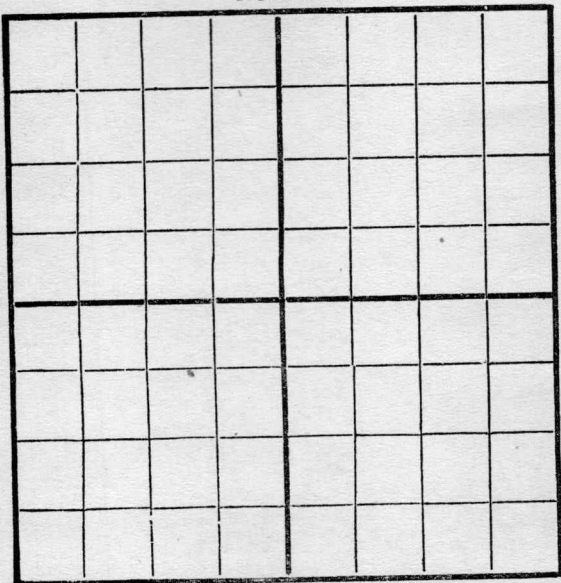

EAST

SOUTH

Location _____
 Rig Up _____
 Drilling and remarks _____

RECORD

Cased _____ in. _____ Ft
 Sand _____
 Gas _____
 Oil _____
 Total Depth _____

PRODUCTION

1st 24 hrs. Nat. _____
 First 24 hrs. after shot _____
 Gas _____ Cu. Ft
 Dry Hole _____
 Abandoned _____

*Started up
 fishing after
 several miles
 Shut Down
 at 1760*


Date

9/27, 1916 L. C. Cuyahoga

Map No. _____ Sec. 11 Twp. 28 R. 4
 Well No. 5 Hogsett Farm _____
Engine Company _____

NORTH

WEST

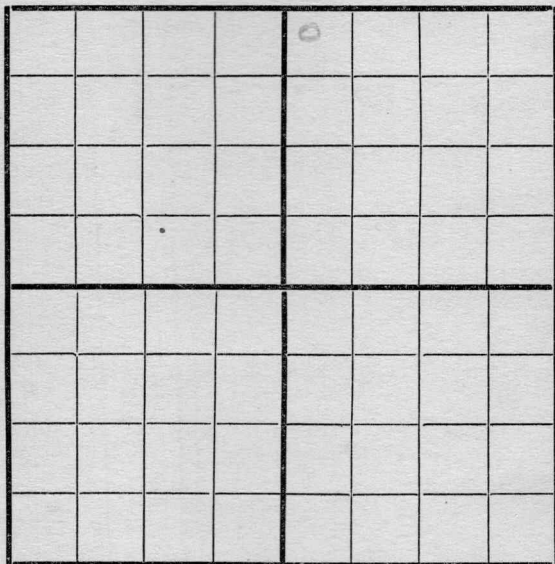

EAST

SOUTH

Location _____
 Rig Up _____
 Drilling and remarks _____

RECORD

Cased _____ in. _____ Ft.
 Sand _____
 Gas _____
 Oil _____
 Total Depth _____

PRODUCTION

1st 24 hrs. Nat. _____
 1st 24 hrs. after shot _____
 Gas _____ Cu. Ft.
 Dry Hole _____
 Abandoned _____

Date

10/2, 191 6500000000 Scout

Map No. _____ Sec. 11 Twp. 28 R. 4Well No. 5 Hoylett Farm _____

Company _____

NORTH

WEST

EAST

SOUTH

Location _____

Rig Up _____

Drilling and remarks

*Skidded Rig
few feet into**Lost all hole
by collapsed*

RECORD

Cased _____ in. _____ Ft.

Sand _____

Gas _____

Oil _____

Total Depth _____

PRODUCTION

1st 24 hrs. Nat. _____

First 24 hrs. after shot _____

Gas _____ Cu. Ft.

Dry Hole _____

Abandoned _____

Date

10/11, 191 6 L C R Scout

Map No. _____ Sec. 11 Twp. 28 R. 4
 Well No. 5 Hoggett Farm _____
Crupine Company _____

NORTH

WEST

EAST

SOUTH

Location _____

Rig Up _____

Drilling and remarks

gudding

RECORD

Cased _____ in. _____ Ft.

Sand _____

Gas _____

Oil _____

Total Depth _____

PRODUCTION

1st 24 hrs. Nat. _____

1st 24 hrs. after shot _____

Gas _____ Cu. Ft.

Dry Hole _____

Abandoned _____

Date

10/18, 1916 Scout

Map No. _____ Sec. 11 Twp. 28 R. 4


Well No. 574022 Farm _____

Engine Company _____

NORTH

WEST

EAST

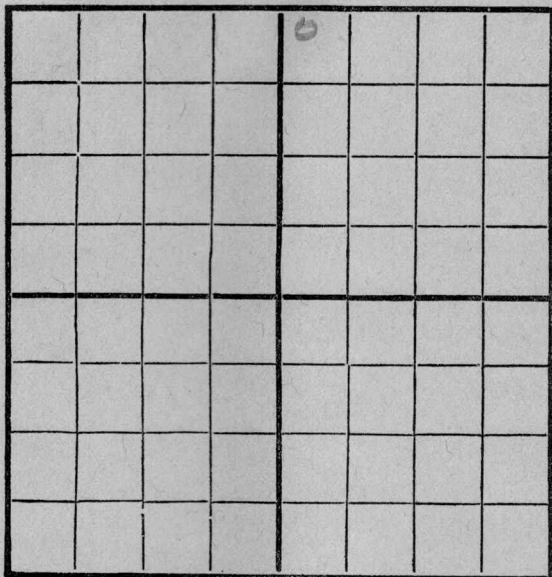

SOUTH

Location _____

Rig Up _____

Drilling and remarks

100

RECORD

Cased _____ in. _____ Ft.

Sand _____

Gas _____

Oil _____

Total Depth _____

PRODUCTION

1st 24 hrs. Nat. _____

First 24 h.s. after shot _____

Gas _____ Cu. Ft.

Dry Hole _____


Abandoned _____

Date

10/23, 1916 Alaugh Scout

Map No. _____ Sec. 11 Twp. 28 R. 4
 Well No. 5 Hazlett Farm _____
Empire Company _____

NORTH

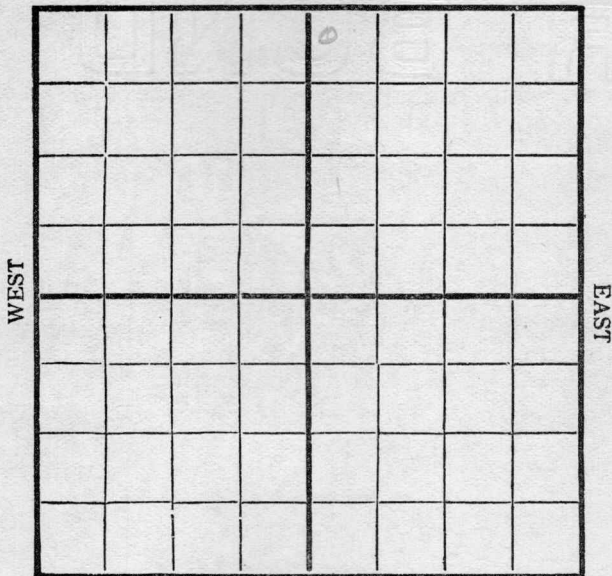

SOUTH

Location _____
 Rig Up _____
 Drilling and remarks _____

200

RECORD

Cased _____ in. _____ Ft.
 Sand _____
 Gas _____
 Oil _____
 Total Depth _____

PRODUCTION


1st 24 hrs. Nat. _____
 First 24 h. s. after shot _____
 Gas _____ Cu. Ft.
 Dry Hole _____
 Abandoned _____

Date

10/30, 1916 Scout

Map No. _____ Sec. 11 Twp. 28 R. 4
 Well No. 5 Hozlett Farm
Cummins Company

NORTH

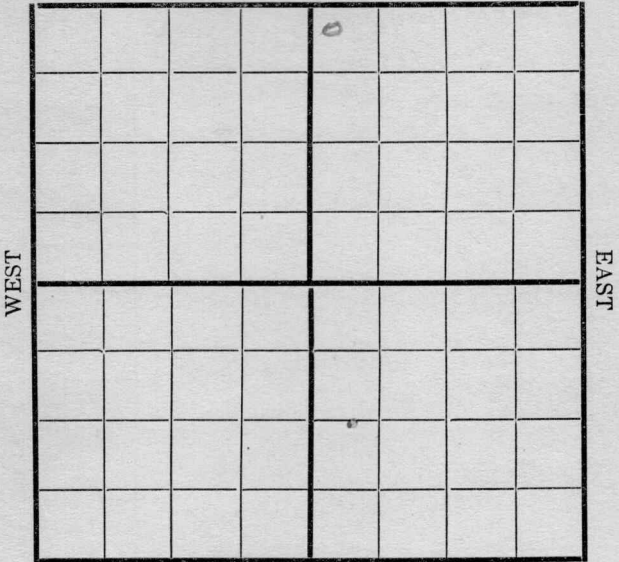

SOUTH

Location _____
 Rig Up _____
 Drilling and remarks

640

RECORD

Cased _____ in. _____ Ft.
 Sand _____
 Gas _____
 Oil _____
 Total Depth _____

PRODUCTION

1st 24 hrs. Nat. _____
 1st 24 hrs. after shot _____
 Gas _____ Cu. Ft.
 Dry Hole _____
 Abandoned _____

Date


11/9, 1916 Scout

Map No. _____ Sec. 11 Twp. 28 R. 4
 Well No. 5 Hazlett Farm _____
Engine Company _____

NORTH

WEST

EAST

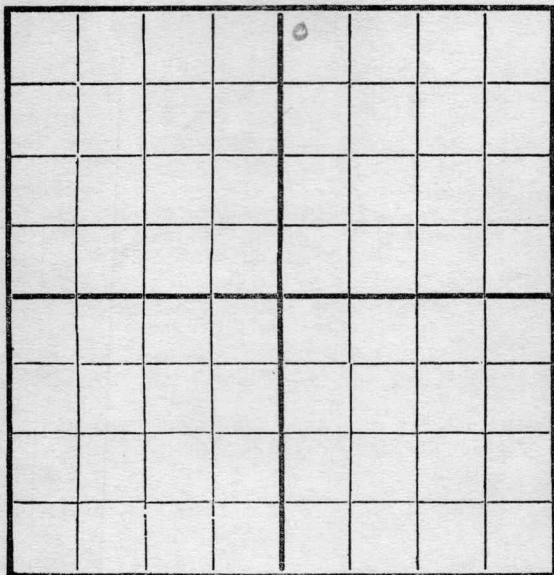

SOUTH

Location _____
 Rig Up _____
 Drilling and remarks

700'

RECORD

Cased _____ in. _____ Ft.
 Sand _____
 Gas _____
 Oil _____
 Total Depth _____

PRODUCTION

1st 24 hrs. Nat. _____
 First 24 hrs. after shot _____
 Gas _____ Cu. Ft.
 Dry Hole _____
 Abandoned _____

Date


11/14, 1916 Cardiff Scout

Map No. _____ Sec. 11 Twp. 28 R. 4
 Well No. 5 Hazett Farm _____
Camp Company _____

NORTH

WEST

EAST

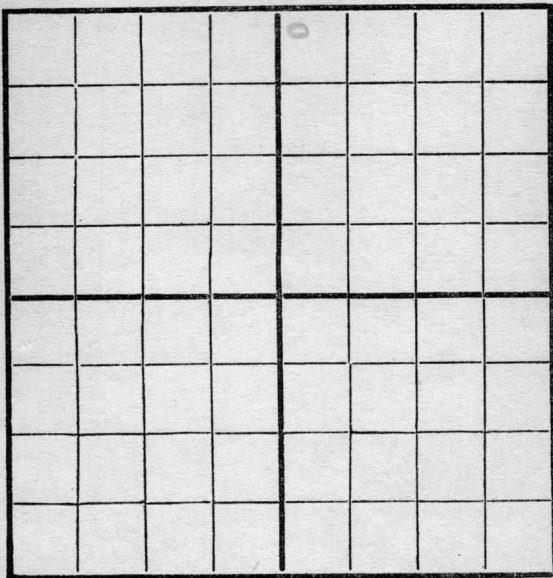

SOUTH

Location _____
 Rig Up _____
 Drilling and remarks

1000

RECORD

Cased _____ in. _____ Ft.
 Sand _____
 Gas _____
 Oil _____
 Total Depth _____

PRODUCTION

1st 24 hrs. Nat. _____
 1st 24 hrs. after shot _____
 Gas _____ Cu. Ft.
 Dry Hole _____
 Abandoned _____

Date

11/20/06 191 Camp Scout

Map No. _____ Sec. 11 Twp. 28 R. 4
 Well No. 5 Koppeltt Farm _____
Engine Company _____

NORTH

WEST

EAST

				0			

SOUTH

Location _____
 Rig Up _____
 Drilling and remarks

1610'

RECORD

Cased _____ in. _____ Ft.
 Sand _____
 Gas _____
 Oil _____
 Total Depth _____


PRODUCTION

1st 24 hrs. Nat. _____
 1st 24 hrs. after shot _____
 Gas _____ Cu. Ft.
 Dry Hole _____
 Abandoned _____

Date

11/27, 1916 Cooley Scout

Map No. _____ Sec. 11 Twp. 28 R. 4
 Well No. 5 Hoggett Farm _____
Empire Company _____
 NORTH

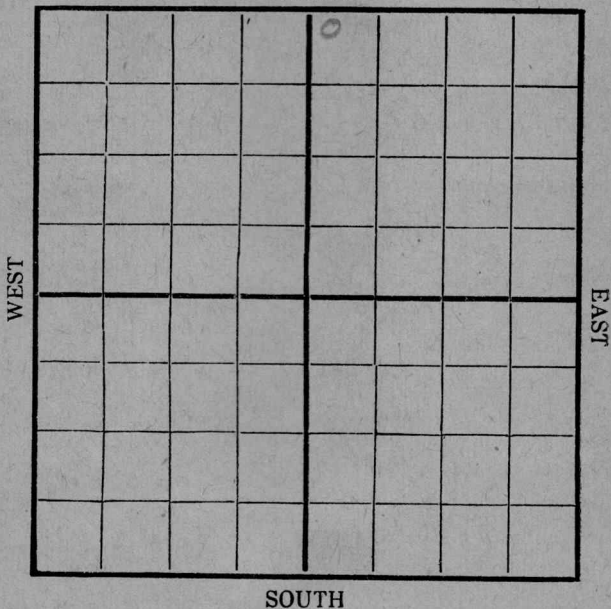

Location _____
 Rig Up _____
 Drilling and remarks _____

RECORD

Cased _____ in. _____ Ft.
 Sand _____
 Gas _____
 Oil _____
 Total Depth _____

PRODUCTION

1st 24 hrs. Nat. _____
 1st 24 hrs. after shot _____
 Gas _____ Cu. Ft.
 Dry Hole _____
 Abandoned _____

Date 12/4/1916 _____ Scout _____

Map No. _____ Sec. 11 Twp. 28 R. 4Well No. 3 Hogsett FarmEmpire Company

NORTH

WEST

EAST

SOUTH

Location _____

Rig Up _____

Drilling and remarks

Shut Down
at 1760'

RECORD

Cased _____ in. _____ Ft.

Sand _____

Gas _____

Oil _____

Total Depth _____

PRODUCTION

1st 24 hrs. Nat. _____

1st 24 hrs. after shot _____

Gas _____ Cu. Ft.

Dry Hole _____

Abandoned _____

Date

12/11, 1916, Carney Scout

Map No. _____ Sec. 11 Twp. 28 R. 4Well No. 5 Hazlett Farm _____Company Empire

NORTH

WEST

EAST

SOUTH

RECORD

Location _____

Cased _____ in. _____ Ft.

Rig Up _____

Sand _____

Drilling and remarks

Gas _____

Oil _____

Total Depth _____

PRODUCTION

1st 24 hrs. Nat. _____

1st 24 hrs. after shot _____

Gas _____ Cu. Ft.

Dry Hole _____

Abandoned _____

Date


12/8, 1916

Scout

Map No. _____ Sec. 11 Twp. 28 R. 4
 Well No. 2704026 Farm _____
 _____ Company

NORTH

WEST

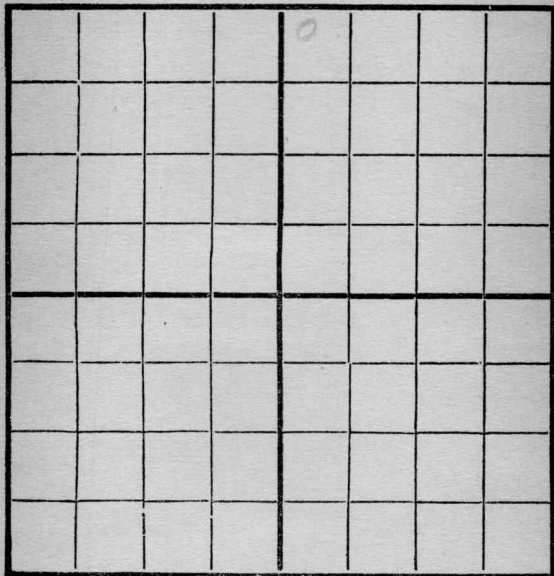

EAST

SOUTH

Location _____

Rig Up _____

Drilling and remarks

RECORD

Cased _____ in. _____ Ft.

Sand _____

Gas _____

Oil _____

Total Depth _____

PRODUCTION

1st 24 hrs. Nat. _____

First 24 hrs. after shot _____

Gas _____ Cu. Ft.

Dry Hole _____

Abandoned _____

Date

12/28/6, 1916 _____ Scout

Map No. 2 Sec. 11 Twp. 28 R. 4
 Well No. 5 Anglett Farm
Engine Company

NORTH

WEST EAST

Remember Changed from #5 to #2

SOUTH

Location _____
 Rig Up _____
 Drilling and remarks _____

RECORD

Cased _____ in. _____ Ft.
 Sand _____
 Gas _____
 Oil _____
 Total Depth _____

PRODUCTION

1st 24 hrs. Nat. _____
 1st 24 hrs. after shot _____
 Gas _____ Cu. Ft.
 Dry Hole _____
 Abandoned _____

Date _____

1/1, 1917 Cooley Scout

Map No. _____ Sec. 11 Twp. 28 R. 4
 Well No. 2 Hazlett Farm _____
Empire Company _____

NORTH

				0			

SOUTH

Location _____
 Rig Up _____
 Drilling and remarks _____

Shut Down
at 1780'

RECORD

Cased _____ in. _____ Ft.
 Sand _____
 Gas _____
 Oil _____
 Total Depth _____

PRODUCTION

1st 24 hrs. Nat. _____
 1st 24 hrs. after shot _____
 Gas _____ Cu. Ft.
 Dry Hole _____
 Abandoned _____

Date

1/7, 1917 Condy Scout

Map No. _____ Sec. 11 Twp. 28 R. 4
 Well No. 2 Hazlett Farm _____
Engine Company _____

NORTH

WEST

EAST

SOUTH

Location _____

Rig Up _____

Drilling and remarks

*Shut Down
at 1780*

RECORD

Cased _____ in. _____ Ft.

Sand _____

Gas _____

Oil _____

Total Depth _____

PRODUCTION

1st 24 hrs. Nat. _____

First 24 hrs. after shot _____

Gas _____ Cu. Ft.

Dry Hole _____


Abandoned _____

Date

1/1, 1912 Carley Scout

Map No. _____ Sec. 11 Twp. 28 R. 4Well No. 2 Shingle FarmEmpire Company

NORTH

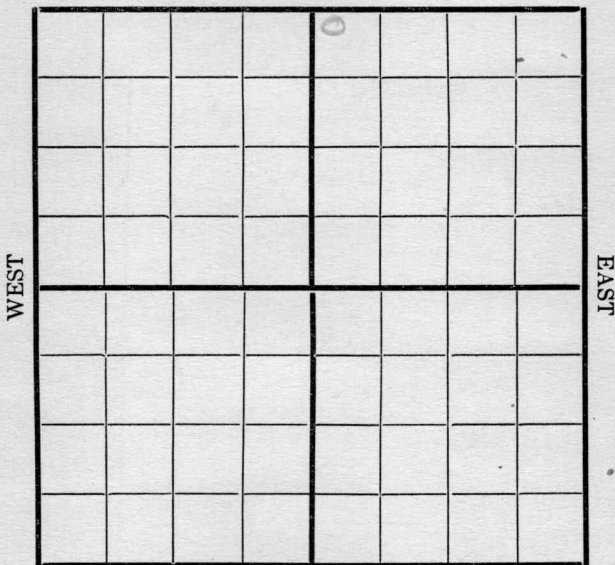

SOUTH

Location _____

Rig Up _____

Drilling and remarks

*Shut Down
at 1780'*

RECORD

Cased _____ in. _____ Ft.

Sand _____

Gas _____

Oil _____

Total Depth _____

PRODUCTION

1st 24 hrs. Nat. _____

1st 24 hrs. after shot _____

Gas _____ Cu. Ft.

Dry Hole _____

Abandoned _____


Date

1/8, 1917 Andy Scout

Map No. _____ Sec. 11 Twp. 28 R. 4
 Well No. 2 Doggett Farm _____
Engine Company _____

NORTH

WEST

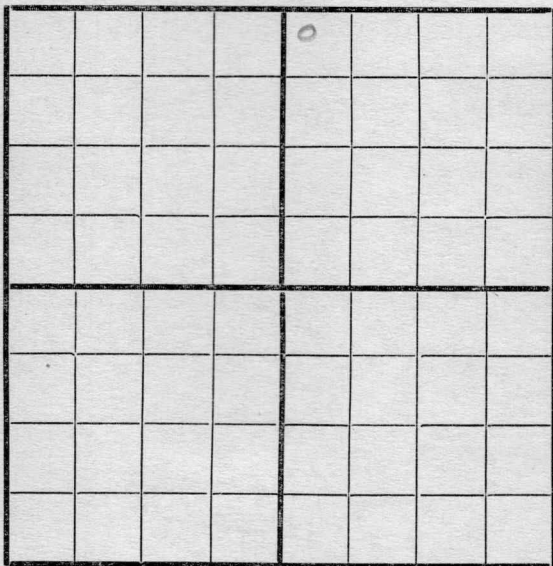

EAST

SOUTH

Location _____

Rig Up _____

Drilling and remarks

*Shut Down
at 1780'*

RECORD

Cased _____ in. _____ Ft.

Sand _____

Gas _____

Oil _____

Total Depth _____

PRODUCTION

1st 24 hrs. Nat. _____

1st 24 hrs. after shot _____

Gas _____ Cu. Ft.

Dry Hole _____

Abandoned _____

Date


1/15; 1917 Cardiff Scout

Map No. _____ Sec. 11 Twp. 28 R. 9Well No. 2 Eagle Farm _____

_____ Company _____

NORTH

WEST

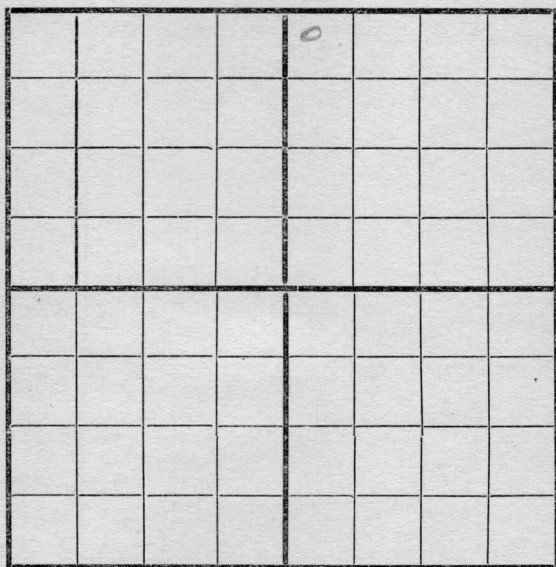

EAST

SOUTH

Location _____

Rig Up _____

Drilling and remarks

Fishing
1780'

RECORD

Cased _____ in. _____ Ft.

Sand _____

Gas _____

Oil _____

Total Depth _____

PRODUCTION

1st 24 hrs. Nat. _____

1st 24 hrs. after shot _____

Gas _____ Cu. Ft.

Dry Hole _____


Abandoned _____

Date

1/22, 191 *7* *Co. Dr. J. J.* Scout

Map No. _____ Sec. 11 Twp. 28 R. 4
 Well No. 2 Haylett Farm _____
Engine Company _____

NORTH

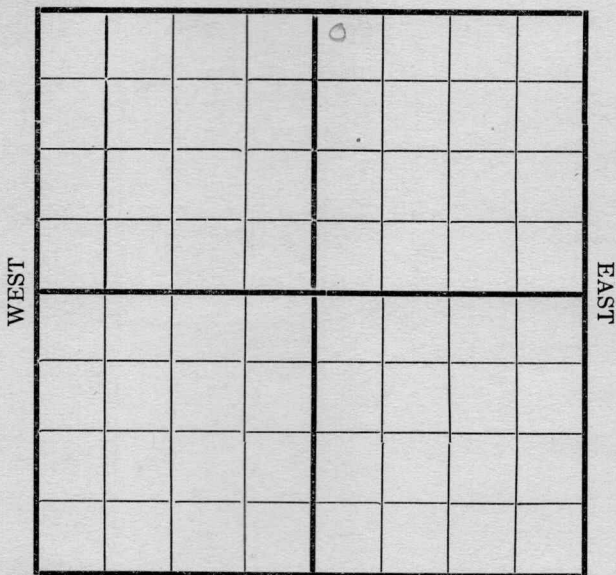

SOUTH

Location _____

Rig Up _____

Drilling and remarks

Shut Down
1780

RECORD

Cased _____ in. _____ Ft.

Sand _____

Gas _____

Oil _____

Total Depth _____

PRODUCTION

1st 24 hrs. Nat. _____

1st 24 hrs. after shot _____

Gas _____ Cu. Ft.

Dry Hole _____

Abandoned _____

Date

1/29 191 7 Amey Scout

Map No. _____ Sec. 11 Twp. 28 R. 4
 Well No. 2 Hazlett Farm _____
Engine Company _____

NORTH

WEST

EAST

SOUTH

Location _____
 Rig Up _____
 Drilling and remarks _____

Shut Down
1780

RECORD

Cased _____ in. _____ Ft.
 Sand _____
 Gas _____
 Oil _____
 Total Depth _____

PRODUCTION

1st 24 hrs. Nat. _____
 1st 24 hrs. after shot _____
 Gas _____ Cu. Ft.
 Dry Hole _____
 Abandoned _____

Date


2/5, 1917 Scout

Map No. _____ Sec. 11 Twp. 28 R. 4
 Well No. 2 Hazlett Farm _____
Cumpane Company _____

NORTH

WEST

EAST

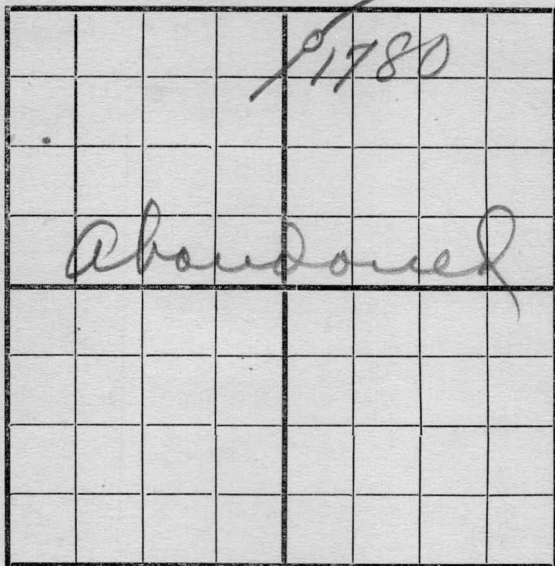

SOUTH

Location _____

Rig Up _____

Drilling and remarks _____

Could not
 get by fishing
 job and casing
 collapsed x
 Had to abandon

RECORD

Cased _____ in. _____ Ft.

Sand _____

Gas _____

Oil _____

Total Depth _____

PRODUCTION

1st 24 hrs. Nat. _____

1st 24 hrs. after shot _____

Gas _____ Cu. Ft.

Dry Hole _____

Abandoned _____

Date _____

2/12 1917

Condy Scout