



WEST

EAST

SOUTH

Location _____

Drilling Remarks

Rig Up.

Drilling Remarks

RECORD

Cased _____ in. _____ ft.

Sand.....

Gas _____

Oil

Total Depth-----

PRODUCTION

1st 24 hrs. Nat.-----

1st 24 hrs. after shot_____

Gas_____cu. ft._____

Dry Hole_____

Abandoned

Greenwood

Map No. KANSAS Sec. 6 Twp. 24 R. 12^E

Well No. 1 Smith Farm


Polhamus & Selby Company

 Ft. from N. Line

1070' Ft. from S. Line

1070' Ft. from E. Line

 Ft. from W. Line

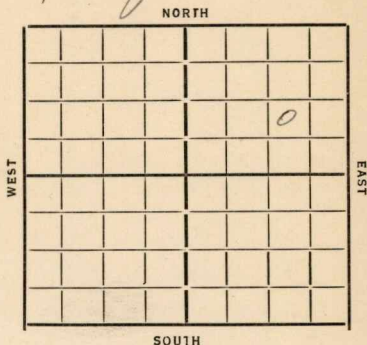

Date 11/23

REPORT

11/1 Location

11/8 Rig up.

11/15 Drilg 670 - 12' at 335

11/22 " 1400'

11/29 Sand 1707-24 T.D. 1748

H.F. Oil - shot 60 gts

12/6 cem 6" at 1700 woc

12/13 swab 70 bbl 24 hr

12/20 sand 1707-24 T.D. 1748

54 bbl

COMPLETED

Map No. 16 Sec. 6 Twp. 24 R. 12 EWell No. 1- SmithPolhamus & Selby Company

Contractor

SECTION PLAT

Ft. from N. Line

1070 Ft. from S. Line1070 Ft. from E. Line

Ft. from W. Line

			0

FIRST REPORTS

Location ✓

Rig up

Drilling and Remarks:

RECORD

Cased in., ft.

Sand

Gas

Oil

Total Depth

PRODUCTION

1st 24 hrs. Nat.

1st 24 hrs. after shot

Gas Cu. Ft.

Dry Hole

Abandoned

Date

11-1-33

192

O. Mannschreck Scout

Map No. 16 Sec. 6 Twp. 24 R. 12EWell No. 1 SmithPolhamus & Selby Company

Contractor

COMPLETED

SECTION PLAT

			0

Ft. from N. Line

1070 Ft. from S. Line1070 Ft. from E. Line

Ft. from W. Line

Location

Rig up

Drilling and Remarks:

54 bbls

RECORD

Cased _____ in., _____ ft.

Sand 1707-24

Gas _____

Oil _____

Total Depth 1748

PRODUCTION

1st 24 hrs. Nat. _____

1st 24 hrs. after shot _____

Gas _____ Cu. Ft.

Dry Hole _____

Abandoned _____

Date

12-20-33 P. Mannick Scout